


1856+00 ✓

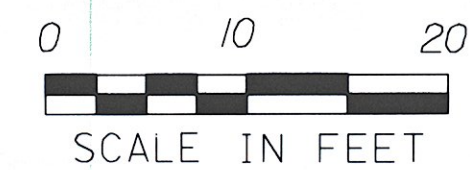

STA. 1856+00 TO STA. 1856+00

*MRP*  
*2-8-11* *RCO*  
*3/16/11*

PROJECT NAME: ROCKINGHAM	PLOT DATE: 26-MAY-2010
PROJECT NUMBER: IM 091-(57)	DRAWN BY: P. PELOQUIN
FILE NAME: 07a158/Design/d07a158xs.dgn	CHECKED BY: S. MENARD
DESIGNED BY: P. PELOQUIN	SHEET 56 OF 78