


1856+50 ✓

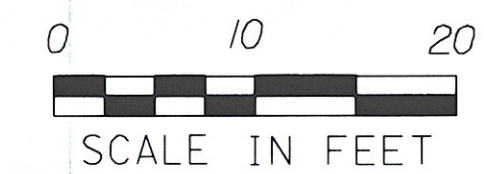

STA. 1856+50 TO STA. 1856+50

PLP
2-8-11 *RCD*
3116111

PROJECT NAME: ROCKINGHAM	
PROJECT NUMBER: IM 091-K(57)	
FILE NAME: 07a158/Design/d07a158xs.dgn	PLOT DATE: 26-MAY-2010
PROJECT LEADER: K. ROBIE	DRAWN BY: P. PELOQUIN
DESIGNED BY: P. PELOQUIN	CHECKED BY: S. MENARD
CROSS SECTION SHEET 3I	SHEET 57 OF 78