


1857+00 ✓

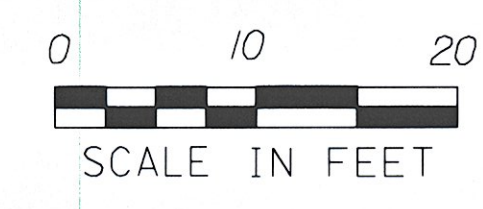

STA. 1857+00 TO STA. 1857+00

RF
2-8-11 *RCO*
3116111

| | | |
|------------------------------|--|------------------------|
| PROJECT NAME: ROCKINGHAM | FILE NAME: 07a158/Design/d07a158xs.dgn | PLOT DATE: 26-MAY-2010 |
| PROJECT NUMBER: IM 091-1(57) | PROJECT LEADER: K. ROBIE | DRAWN BY: P. PELOQUIN |
| | DESIGNED BY: P. PELOQUIN | CHECKED BY: S. MENARD |
| | CROSS SECTION SHEET 32 | SHEET 58 OF 78 |