


1857+50 ✓

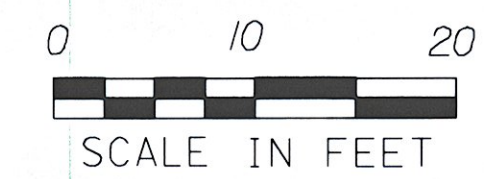

STA. 1857+50 TO STA. 1857+50

*MP*  
2-8-11 *RCD*  
3/16/11

|  |                        |
|--|------------------------|
| PROJECT NAME: ROCKINGHAM               |                        |
| PROJECT NUMBER: IM 091-(57)            |                        |
| FILE NAME: 07a158/Design/d07a158xs.dgn | PLOT DATE: 26-MAY-2010 |
| PROJECT LEADER: K. ROBIE               | DRAWN BY: P. PELOQUIN  |
| DESIGNED BY: P. PELOQUIN               | CHECKED BY: S. MENARD  |
| CROSS SECTION SHEET 33                 | SHEET 59 OF 78         |