



1858+50 ✓

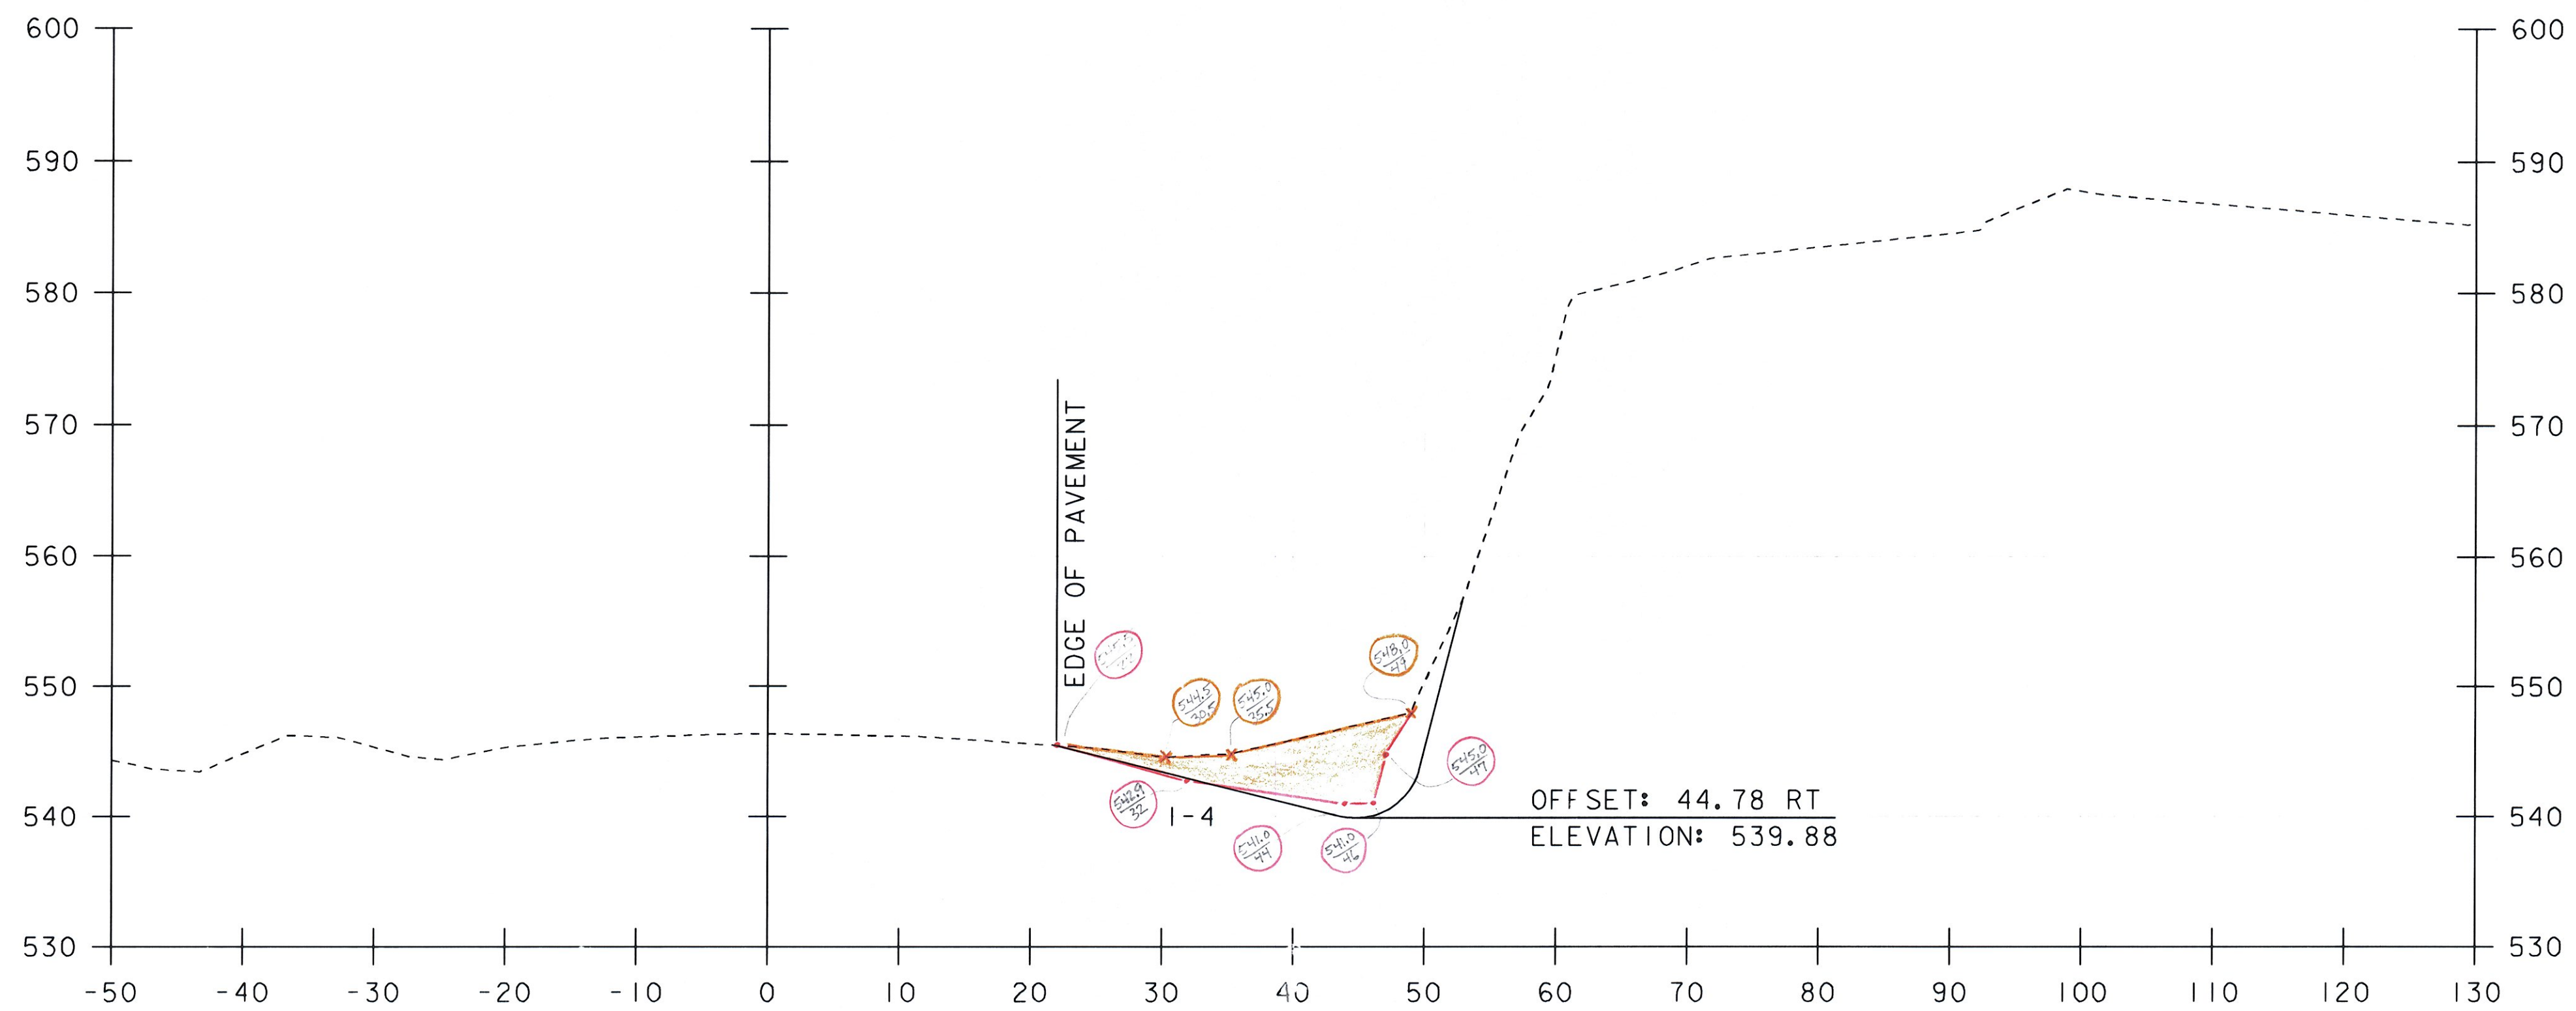

1858+00 ✓

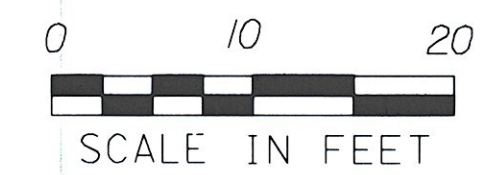

STA. 1858+00 TO STA. 1858+50

MRP
2-8-11 *RCD*
3/16/11

PROJECT NAME: ROCKINGHAM	
PROJECT NUMBER: IM 091-1(57)	
FILE NAME: 07a158/Design/d07a158xs.dgn	PLOT DATE: 26-MAY-2010
PROJECT LEADER: K. ROBIE	DRAWN BY: P. PELOQUIN
DESIGNED BY: P. PELOQUIN	CHECKED BY: S. MENARD
CROSS SECTION SHEET 34	SHEET 60 OF 78