


1859+50 ✓

EXISTING 24' X 88' CSP
NEW 24' X 8' CPEP WITH END SECTION

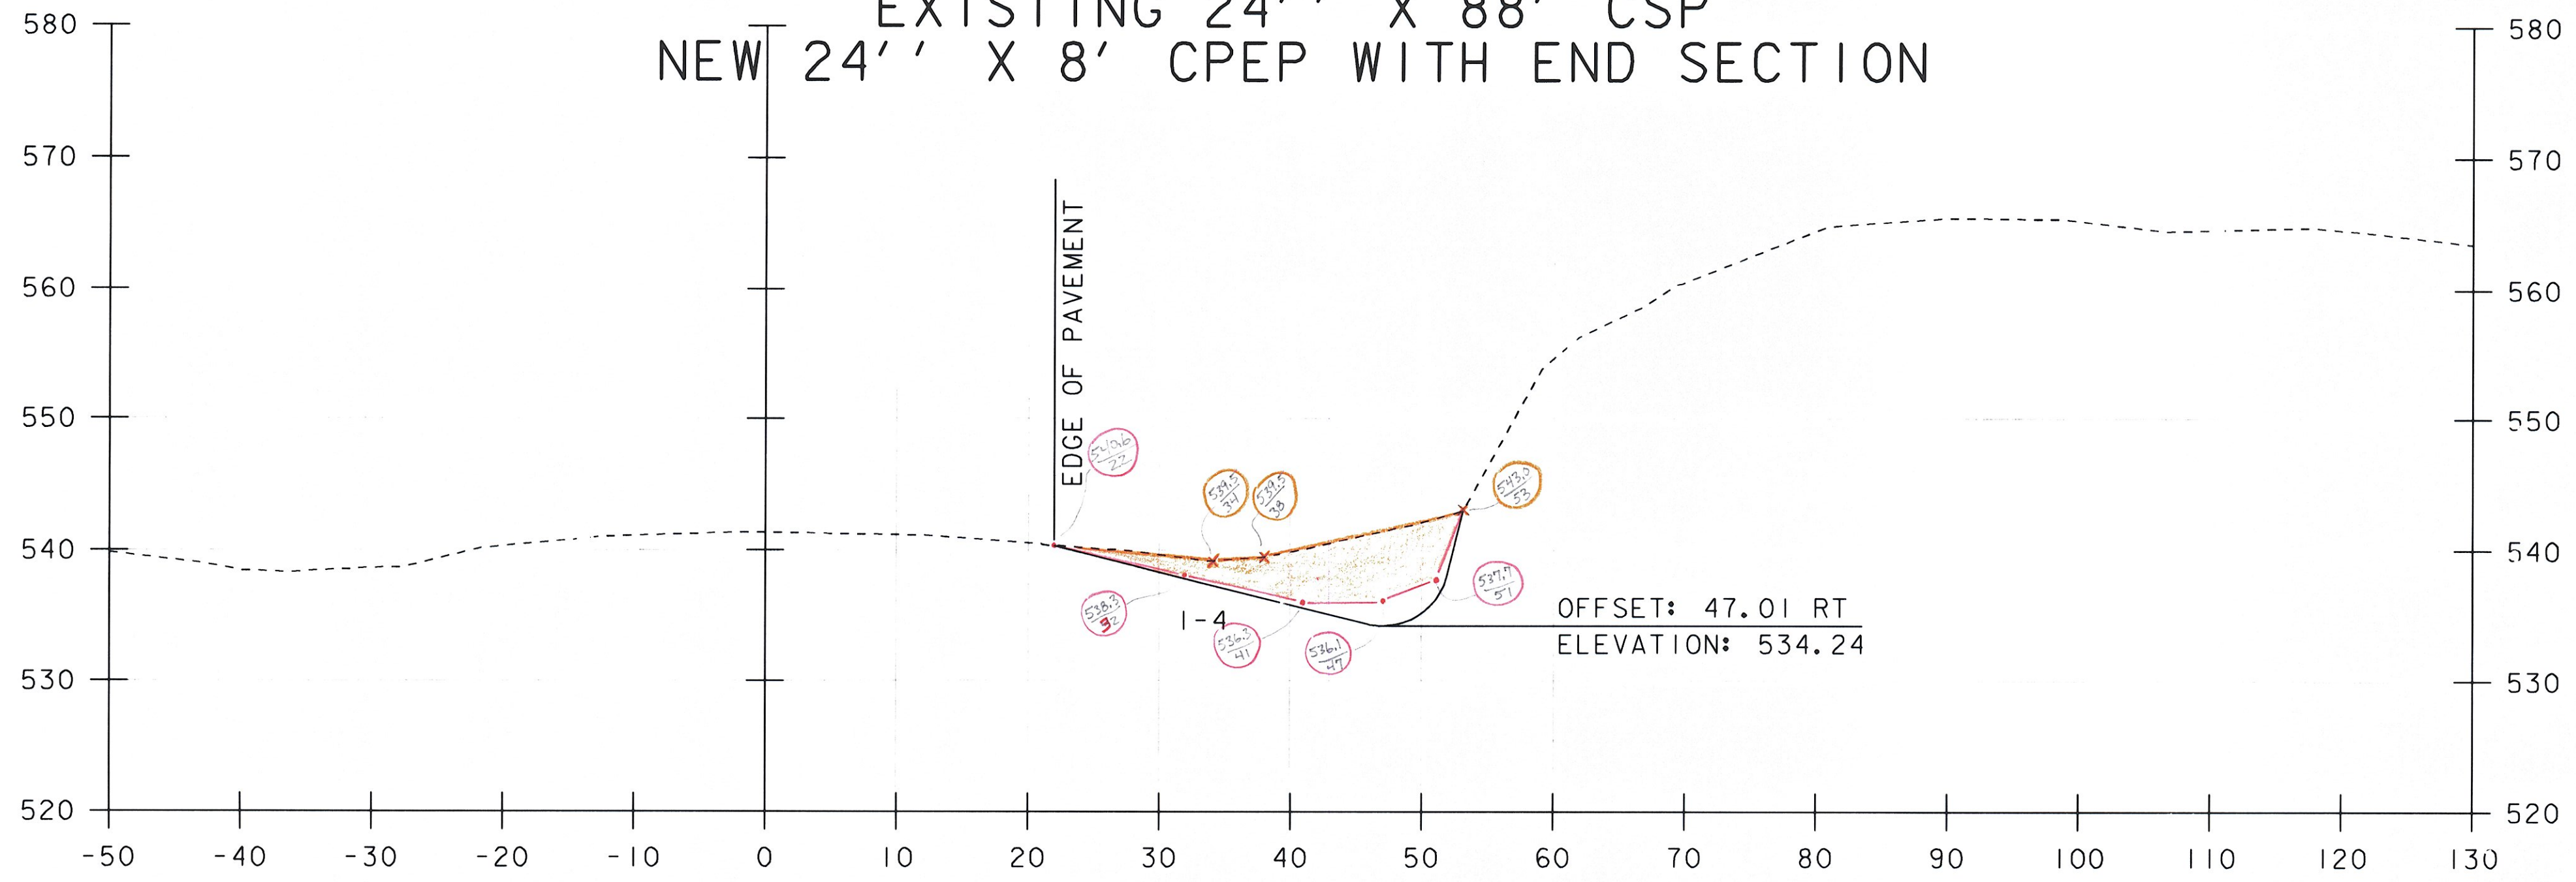

1859+00 ✓



STA. 1859+00 TO STA. 1859+50

MR
2-8-11 *RCO*
5/16/11

PROJECT NAME: ROCKINGHAM	PLLOT DATE: 26-MAY-2010
PROJECT NUMBER: IM 091-I(57)	DRAWN BY: P. PELOQUIN
FILE NAME: 07a158/Design/d07a158xs.dgn	CHECKED BY: S. MENARD
PROJECT LEADER: K. ROBIE	SHEET 61 OF 78
DESIGNED BY: P. PELOQUIN	CROSS SECTION SHEET 35