



1860+50

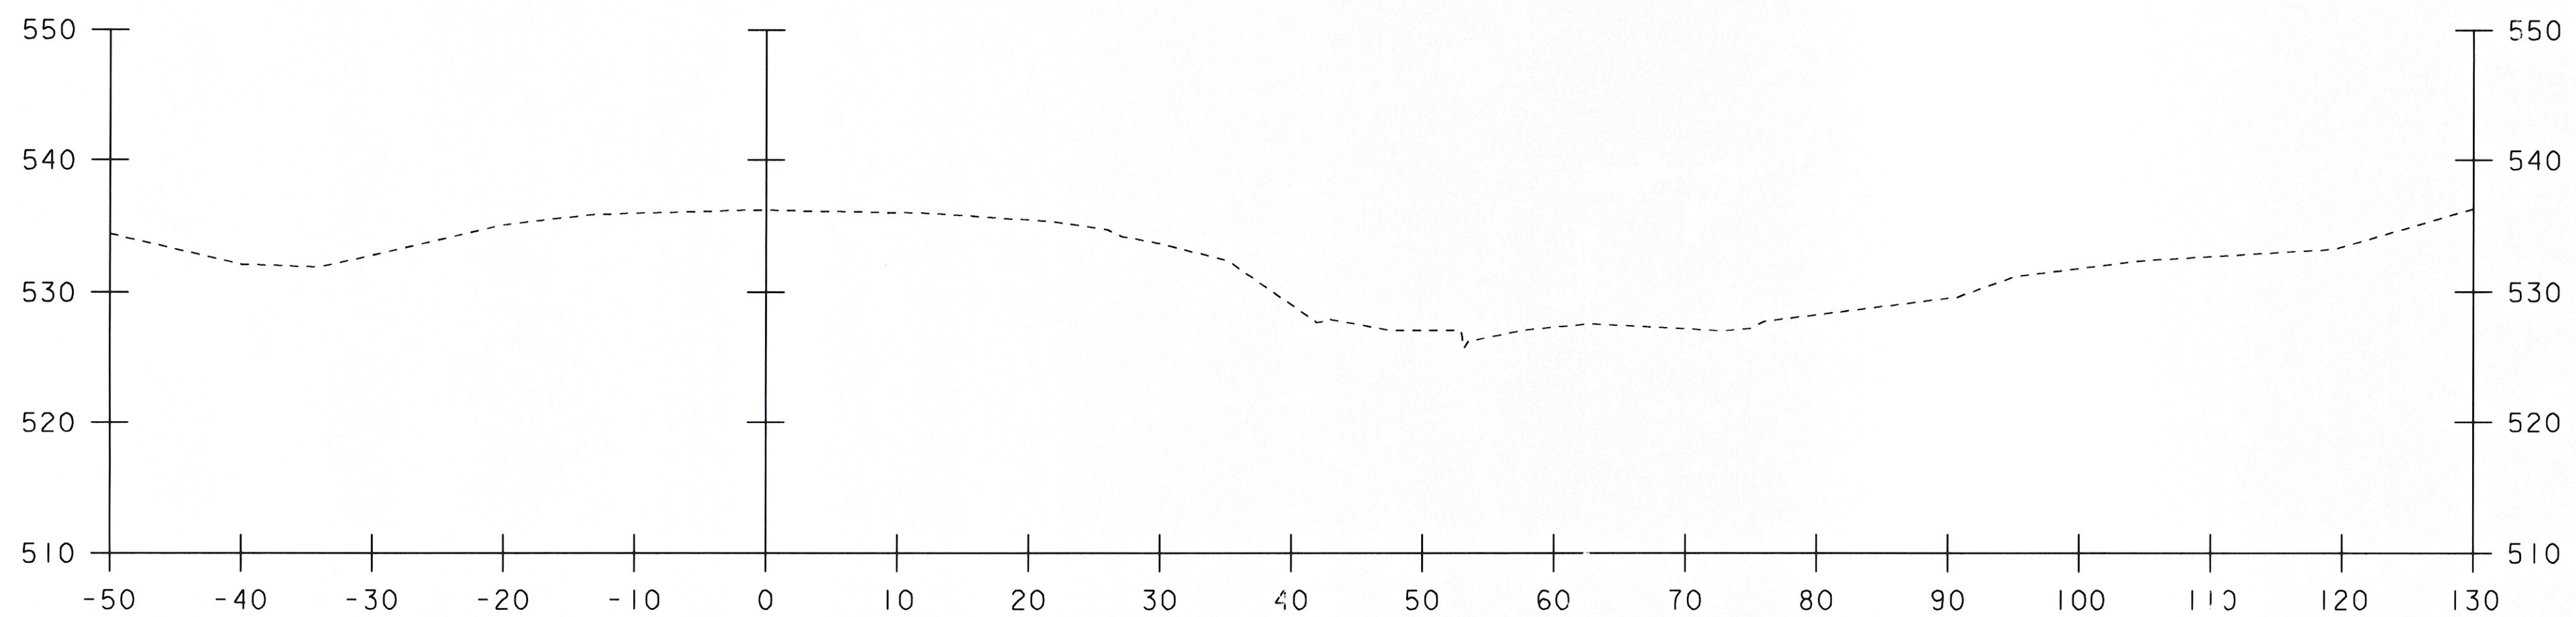

1860+00
END PROJECT

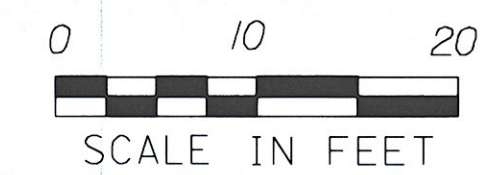

STA. 1860+00 TO STA. 1860+50

MRP
2-8-11

PROJECT NAME: ROCKINGHAM	PLLOT DATE: 26-MAY-2010
PROJECT NUMBER: IM 091-1(57)	DRAWN BY: P. PELOQUIN
FILE NAME: 07a158/Design/d07a158xs.dgn	CHECKED BY: S. MENARD
PROJECT LEADER: K. ROBIE	SHEET 62 OF 78
DESIGNED BY: P. PELOQUIN	CROSS SECTION SHEET 36