



1862+00

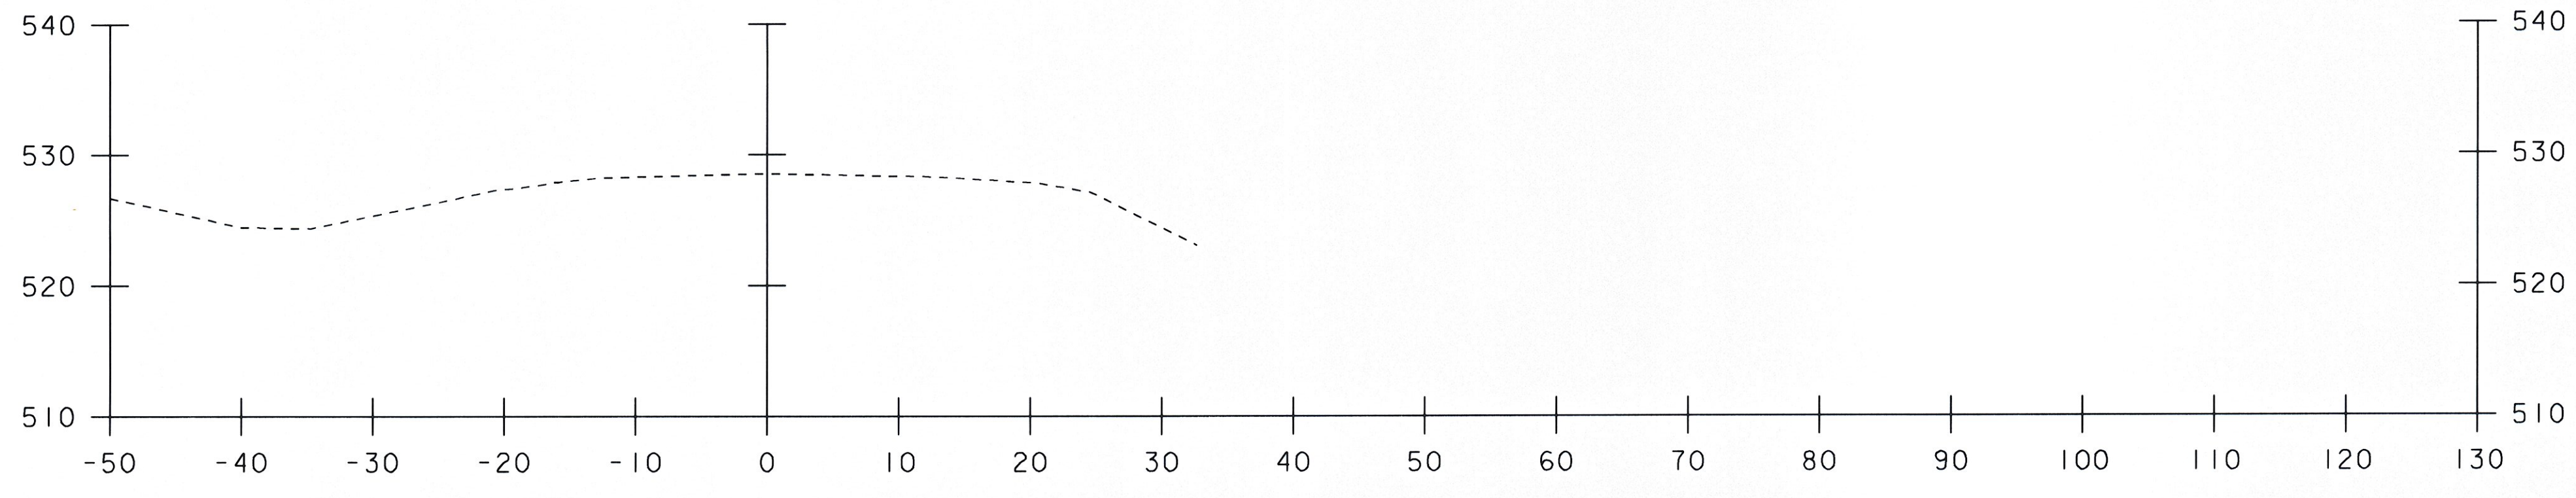

1861+50

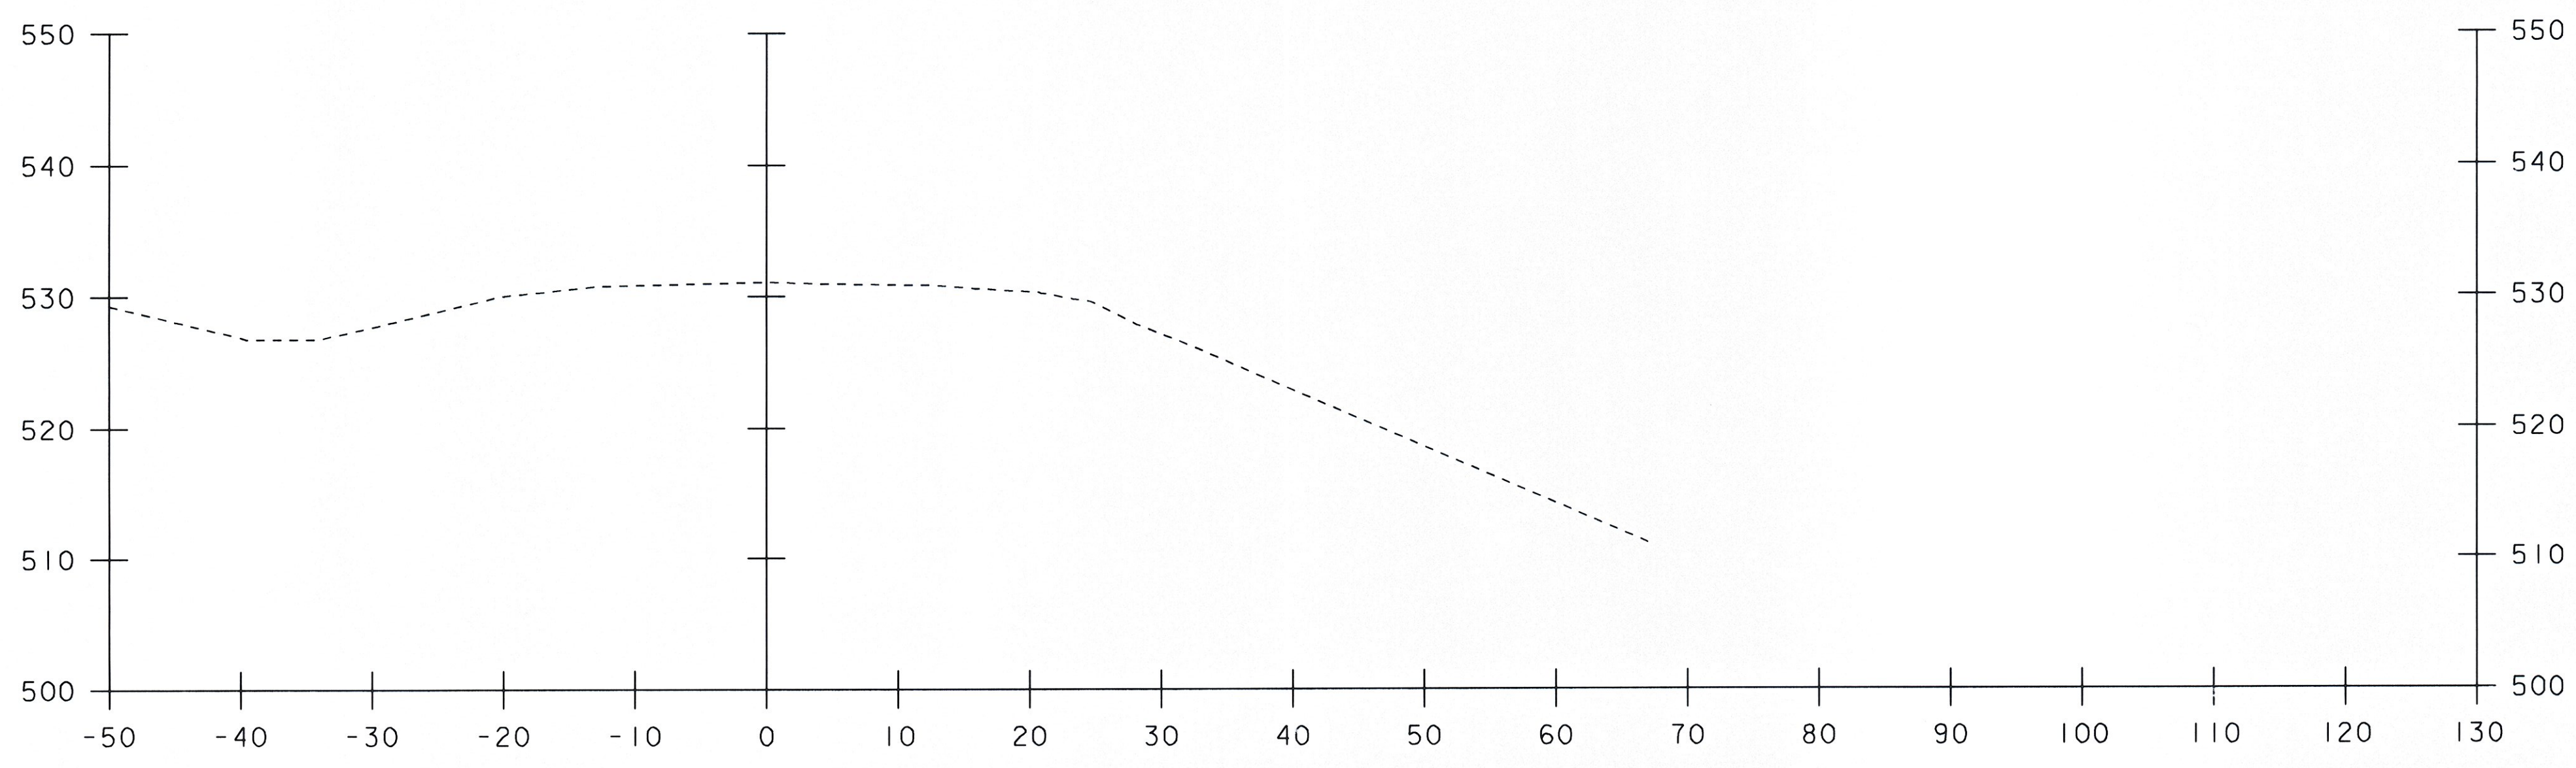

1861+00



STA. 1861+00 TO STA. 1862+00

ACP
2-8-11

PROJECT NAME: ROCKINGHAM	PLOT DATE: 26-MAY-2010
PROJECT NUMBER: IM 091-I(57)	DRAWN BY: P. PELOQUIN
FILE NAME: 07a158/Design/d07a158xs.dgn	CHECKED BY: S. MENARD
PROJECT LEADER: K. ROBIE	SHEET 63 OF 78
DESIGNED BY: P. PELOQUIN	
CROSS SECTION SHEET 37	