


1864+24



1864+00

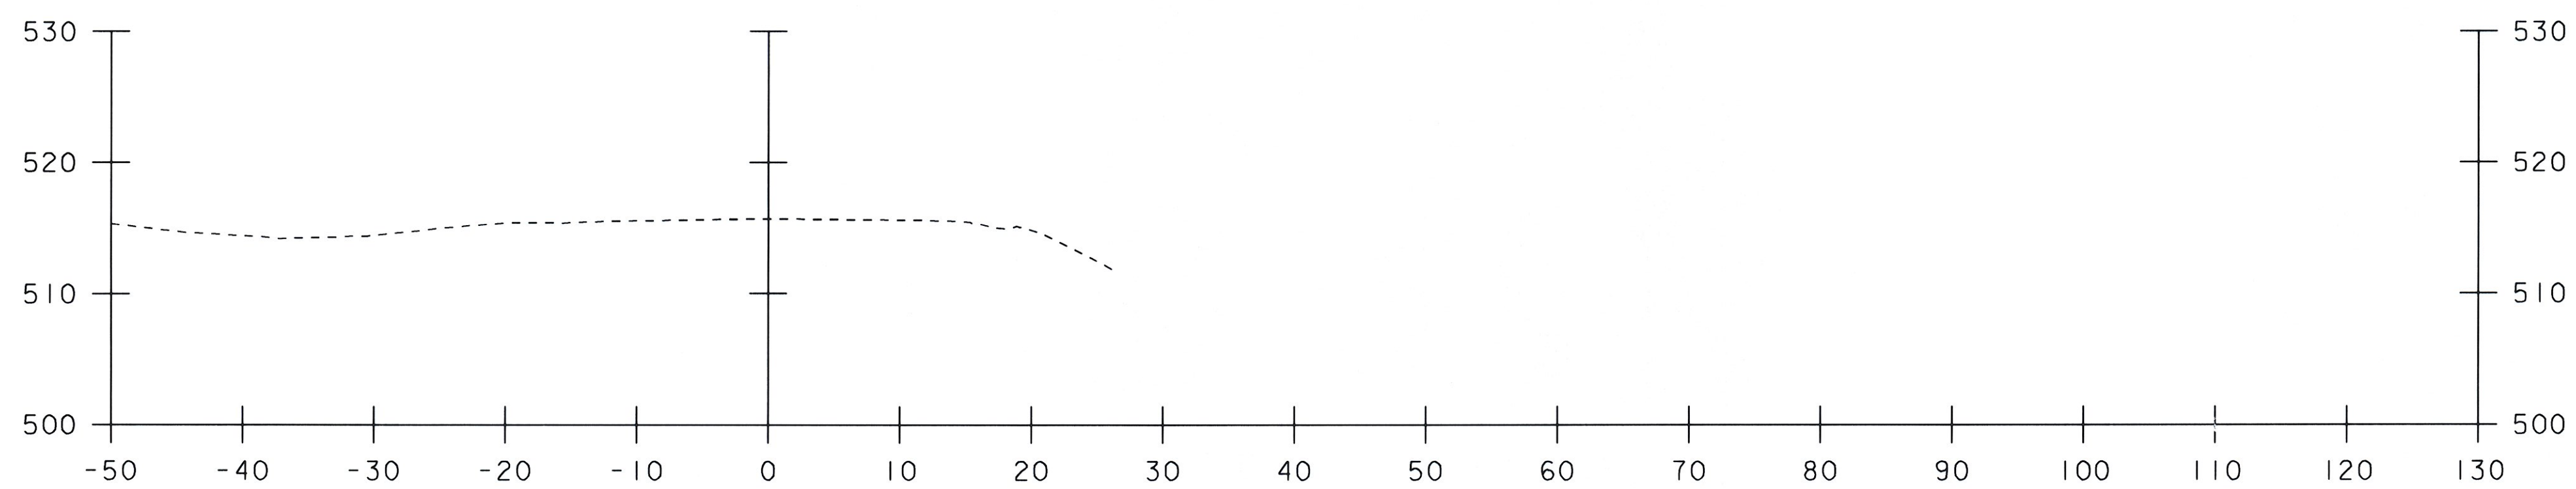

STA. 1864+00 TO STA. 1864+24

PROJECT NAME: ROCKINGHAM	
PROJECT NUMBER: IM 091-1(57)	
FILE NAME: 07d158/Design/d07d158xs.dgn	PLOT DATE: 26-MAY-2010
PROJECT LEADER: K. ROBIE	DRAWN BY: P. PELOQUIN
DESIGNED BY: P. PELOQUIN	CHECKED BY: S. MENARD
CROSS SECTION SHEET 39	SHEET 65 OF 78

Handwritten initials and date:
PJP
2-8-11