
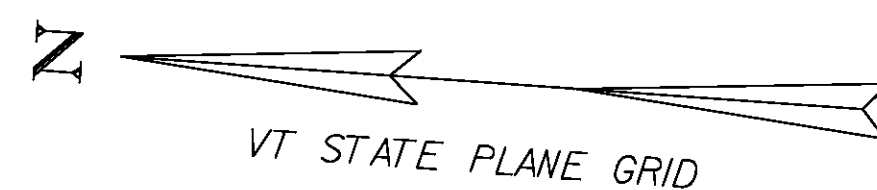


653.20 - TEMPORARY EROSION MATTING
 STA. 1838+22RT TO STA. 1847+00 RT (DITCH) Δ

653.55 - PROJECT DEMARCATION FENCE
 STA. 1837+93 RT TO STA. 1847+00 RT

653.25 - TEMPORARY STONE CHECK DAM, TYPE I
 STA. 1838+43 RT TO STA. 1847+00 RT (3 CHECK DAMS)

649.51 - GEOTEXTILE FOR SILT FENCE
 STA. 1838+45 RT TO STA. 1838+45 RT (CREST OF LEDGE)
 STA. 1838+24 RT TO STA. 1838+46 RT (DITCH)

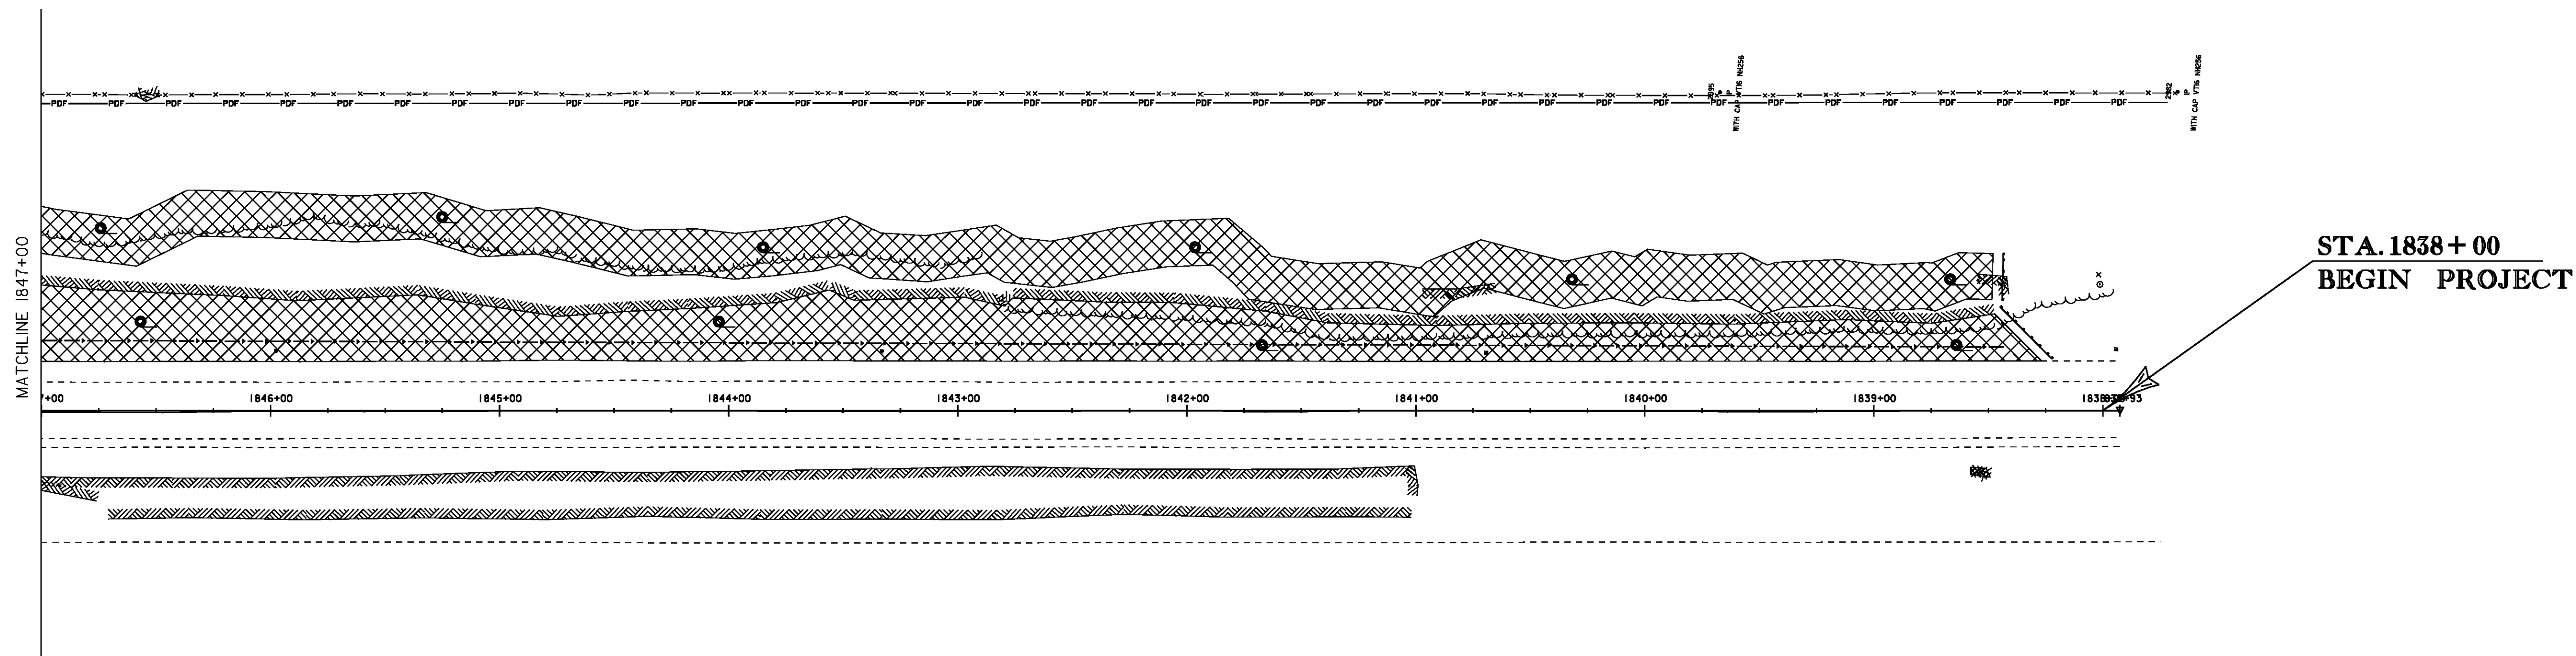

LEGEND	
	CHECK DAMS
	SILT FENCE
	EROSION MATTING/LIMITS OF DISTURBANCE
	PROJECT DEMARCATION FENCE

AREA OF DISTURBANCE:
 CREST OF LEDGE: 17,572 SF; 0.403 ACRES
 DITCH: 19,647 SF; 0.451 ACRES
 SHEET TOTAL: 37,219 SF; 0.854 ACRES
 PROJECT TOTAL: 98,187 SF; 2.253 ACRES

Δ REVISED ITEM, EROSION MATTING FOR CREST OF LEDGE REMOVED 7/8/10



PROJECT NAME: ROCKINGHAM	PLOT DATE: 08-JUL-2010
PROJECT NUMBER: IM 091-(57)	DRAWN BY: P. PELOQUIN
FILE NAME: 07a158/Design/d07a158bdr.dgn	CHECKED BY: S. MENARD
PROJECT LEADER: K. ROBBE	SHEET 66 OF 78
DESIGNED BY: P. PELOQUIN	
EPSC LAYOUT SHEET 1	