
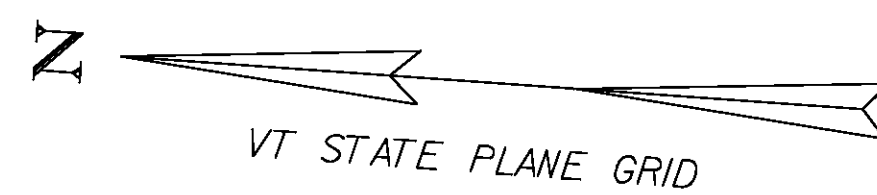


653.20 - TEMPORARY EROSION MATTING
 STA. 1847+00 RT TO STA. 1855+00 RT (DITCH) Δ

653.40 - INLET PROTECTION DEVICE, TYPE I
 STA. 1848+50 RT
 STA. 1854+02 RT

653.55 - PROJECT DEMARCATION FENCE
 STA. 1847+00 RT TO STA. 1855+00 RT

653.25 - TEMPORARY STONE CHECK DAM, TYPE I
 STA. 1847+00 RT TO STA. 1855+00 RT (12 CHECK DAMS)

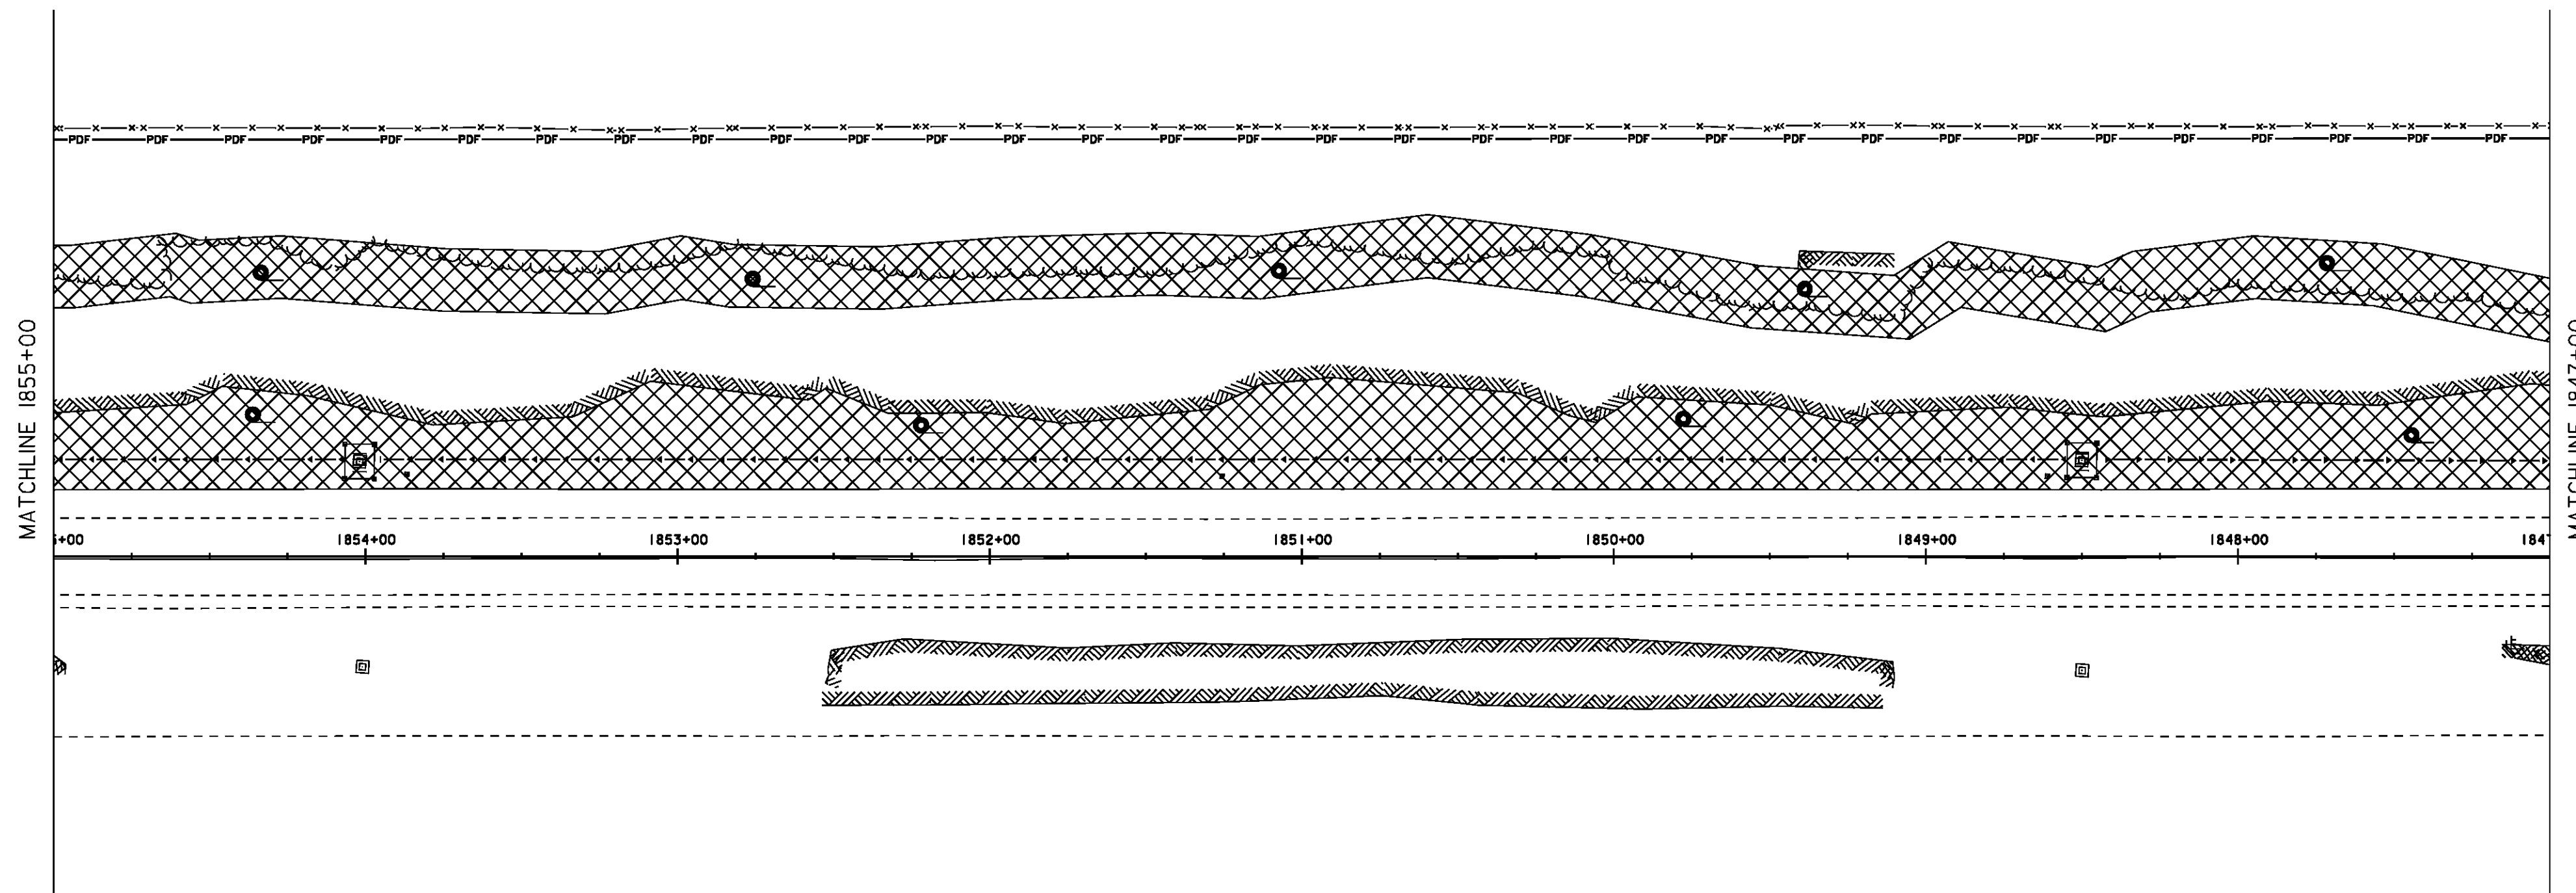

LEGEND	
	CHECK DAMS
	EROSION MATTING/LIMITS OF DISTURBANCE
	PROJECT DEMARCATION FENCE
	INLET PROTECTION

AREA OF DISTURBANCE:
 CREST OF LEDGE: 16,194 SF; 0.372 ACRES
 DITCH: 21,865 SF; 0.501 ACRES
 SHEET TOTAL: 38,059 SF; 0.873 ACRES
 PROJECT TOTAL: 98,187 SF; 2.253 ACRES

Δ REVISED ITEM, EROSION MATTING
 FOR CREST OF LEDGE REMOVED 7/8/10



PROJECT NAME: ROCKINGHAM	PLOT DATE: 08-JUL-2010
PROJECT NUMBER: IM 091-(57)	DRAWN BY: P. PELOQUIN
FILE NAME: 07a158/Design/d07a158bdr.dgn	CHECKED BY: S. MENARD
PROJECT LEADER: K. ROBIE	SHEET 67 OF 78
DESIGNED BY: P. PELOQUIN	
EPSC LAYOUT SHEET 2	