

653.20 - TEMPORARY EROSION MATTING
 STA. 1855+00 RT TO STA. 1859+89 RT (DITCH) Δ



653.40 - INLET PROTECTION DEVICE, TYPE I
 STA. 1859+50 RT

653.55 - PROJECT DEMARCATION FENCE
 STA. 1855+00 RT TO STA. 1860+95 RT

653.25 - TEMPORARY STONE CHECK DAM, TYPE I
 STA. 1855+00 RT TO STA. 1859+47 RT (II CHECK DAMS)

649.51 - GEOTEXTILE FOR SILT FENCE
 STA. 1859+58 RT TO STA. 1859+67 RT (CREST OF LEDGE)
 STA. 1859+57 RT TO STA. 1859+90 RT (DITCH)

653.35 - VEHICLE TRACKING PAD
 STA. 1858+80 RT TO STA. 1859+30 RT

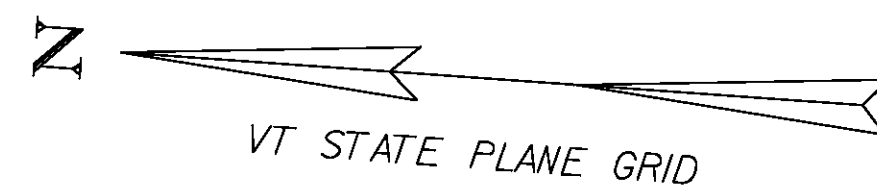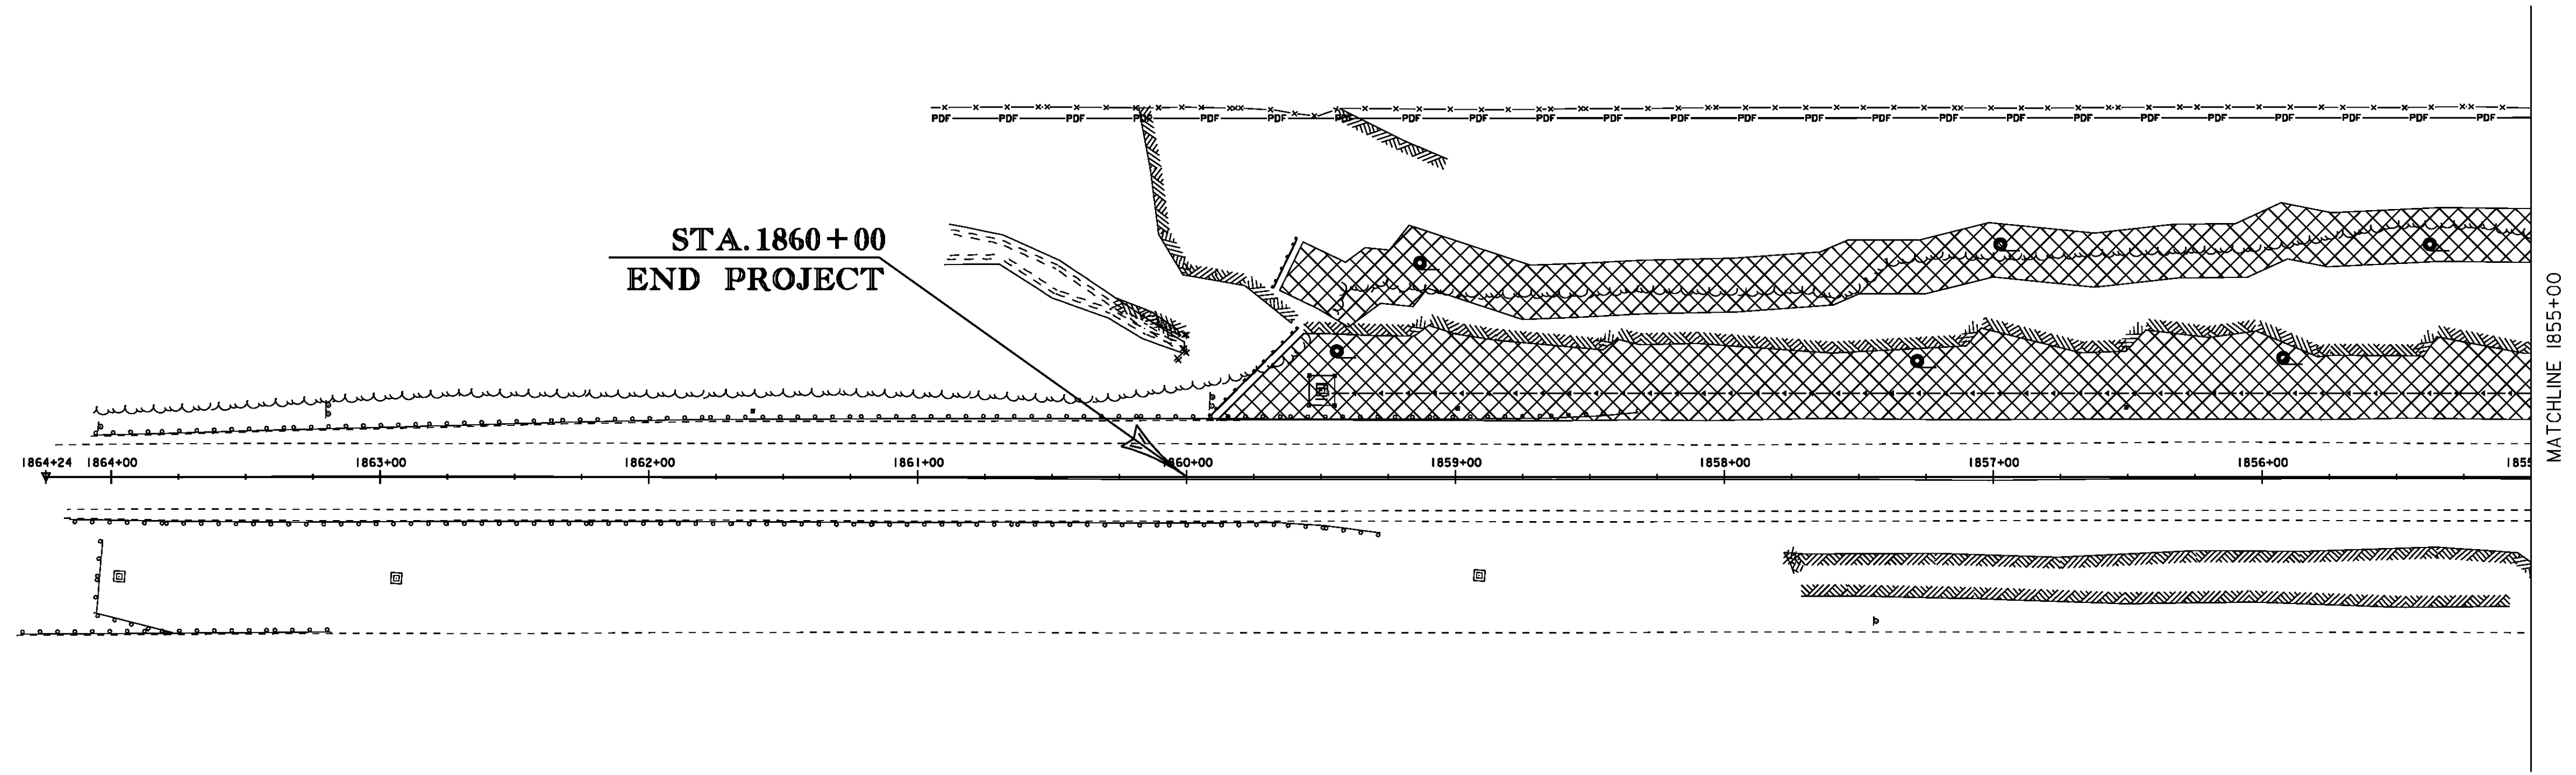

LEGEND	
	CHECK DAMS
	SILT FENCE
	EROSION MATTING/LIMITS OF DISTURBANCE
	PROJECT DEMARCATION FENCE
	INLET PROTECTION

AREA OF DISTURBANCE:
 CREST OF LEDGE: 9,524 SF; 0.219 ACRES
 DITCH: 13,385 SF; 0.307 ACRES
 SHEET TOTAL: 22,909 SF; 0.526 ACRES
 PROJECT TOTAL: 98,187 SF; 2.253 ACRES

Δ REVISED ITEM, EROSION MATTING
 FOR CREST OF LEDGE REMOVED 7/8/10



PROJECT NAME: ROCKINGHAM	PLOT DATE: 08-JUL-2010
PROJECT NUMBER: IM 091-(57)	DRAWN BY: P. PELOQUIN
FILE NAME: 07a158/DesIgn/d07a158bdr.dgn	CHECKED BY: S. MENARD
PROJECT LEADER: K. ROBIE	SHEET 68 OF 78
DESIGNED BY: P. PELOQUIN	
EPSC LAYOUT SHEET 3	