


**STA. 1838+00  
BEGIN PROJECT**

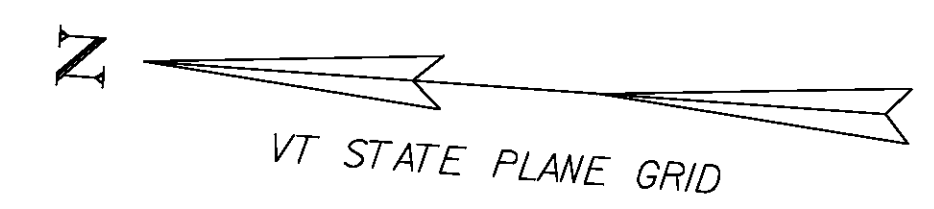

PROJECT NAME: ROCKINGHAM	
PROJECT NUMBER: IM 091-(57)	
FILE NAME: 07a158/Design/d07a158bdr.dgn	PLOT DATE: 26-MAY-2010
PROJECT LEADER: K. ROBIE	DRAWN BY: P. PELOQUIN
DESIGNED BY: P. PELOQUIN	CHECKED BY: S. MENARD
EXISTING CONDITIONS LAYOUT SHEET 1	SHEET 69 OF 78