


**INTERSTATE ROUTE 91
SOUTHBOUND**
MM 155.987-156.006
BEGIN PROJECT IM 091-3(48)

**INTERSTATE ROUTE 91
SOUTHBOUND**
MM 163.000-0.010
END PROJECT IM 091-3(48)

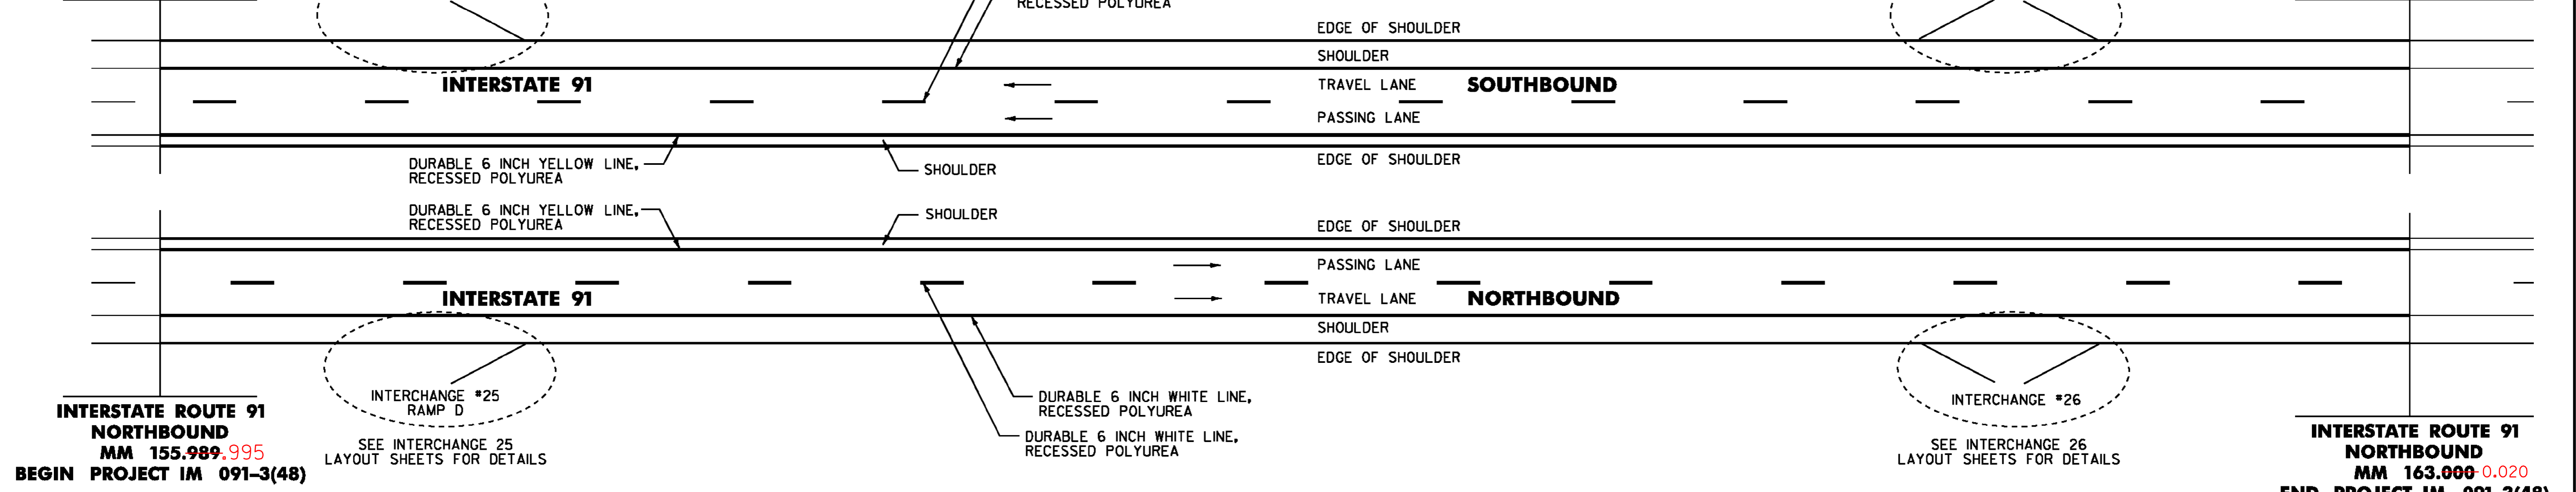

213.10 MILLED RUMBLE STRIPS (SEE NOTE 1)
 NORTHBOUND:
 MM 155.989 - MM 163.000 LT (37018 LF)
 MM 155.989 - MM 163.000 RT (37018 LF)
 .995 .020
 SOUTHBOUND:
 MM 155.987 - MM 163.000 LT (37029 LF)
 MM 155.987 - MM 163.000 RT (37029 LF)
 156.006 .010
 604.412 OR 604.415 REHAB. DROP INLETS, CATCH BASINS
 OR MANHOLES CLASS I OR II(SEE NOTE 2)
 NORTHBOUND: SOUTHBOUND:
~~MM 156.383 RT~~ ~~MM 156.090 LT~~
 MM 156.437 RT MM 157.232 LT
 MM 159.784 RT ~~MM 157.392 LT~~
~~MM 159.830 RT~~ ~~MM 158.740 LT~~
~~MM 160.020 LT~~ MM 161.428 LT
~~MM 161.378 RT~~ ~~MM 161.476 LT~~
~~MM 161.432 RT~~ EXIT 25 D MM 0.056 RT
~~MM 161.479 RT~~ EXIT 26 A MM 0.208 RT
~~MM 161.619 RT~~ EXIT 26 B MM 0.011 RT
 MM 155.996 RT EXIT 26 B MM 0.072 RT

646.436 DURABLE 6 INCH YELLOW LINE, RECESSED POLYUREA
 NORTHBOUND:
 MM 155.989 - MM 163.000 LT (SOLID)
 .995 .020
 SOUTHBOUND:
 MM 155.987 - MM 163.000 RT (SOLID)
 156.006 .010
 646.622 TEMPORARY 6 INCH WHITE LINE, PAINT
 NORTHBOUND:
 MM 155.989 - MM 163.000 CL (DASHED)
 MM 155.989 - MM 163.000 RT (SOLID)
 .995 .020
 SOUTHBOUND:
 MM 155.987 - MM 163.000 CL (DASHED)
 MM 155.987 - MM 163.000 LT (SOLID)
 156.006 .010
 646.632 TEMPORARY 6 INCH YELLOW LINE, PAINT
 NORTHBOUND:
 MM 155.989 - MM 163.000 LT (SOLID)
 .995 .020
 SOUTHBOUND:
 MM 155.987 - MM 163.000 RT (SOLID)
 156.006 .010
 676.10 DELINEATOR WITH STEEL POST
 SEE ITEM DETAIL SUMMARY SHEETS
 676.12 REMOVAL OF EXISTING DELINEATOR
 SEE ITEM DETAIL SUMMARY SHEETS
 900.620 SPECIAL PROVISION (CABLE GUARDRAIL J-BOLT, GALVANIZED)
 SEE ITEM DETAIL SUMMARY SHEETS
 900.620 SPECIAL PROVISION (CABLE GUARDRAIL SPLICE UNIT)
 SEE ITEM DETAIL SUMMARY SHEETS

900.620 SPECIAL PROVISION (DECOMMISSION CURB DROP INLET)
 NORTHBOUND: SOUTHBOUND:
 REHABED (155.996 RT) ~~MM 156.000 RT~~ MM 159.397 RT
 MM 157.702 RT ~~MM 159.421 RT~~ NO DI
 MM 157.750 RT MM 159.444 RT
 MM 158.028 RT MM 159.444 LT
 MM 158.142 RT MM 160.237 RT
 MM 158.171 RT MM 160.237 LT
 MM 158.333 RT MM 160.277 RT
 158.527 MM 158.595 RT MM 160.277 LT
 MM 158.715 RT MM 160.313 RT
 MM 158.978 RT MM 160.313 LT
 MM 159.011 RT MM 160.352 RT
 NO DI THERE ~~MM 159.013 RT~~ MM 160.352 LT
 MM 159.248 RT MM 160.426 RT
 NO DI THERE ~~MM 159.272 RT~~ MM 160.929 RT
 MM 159.286 RT MM 160.981 RT
 MM 159.324 RT MM 161.033 RT
 NO DI THERE ~~MM 159.348 RT~~ MM 162.603 RT
 MM 159.362 RT MM 162.631 RT
 NO DI THERE ~~MM 159.386 RT~~ MM 161.033 RT
 MM 161.085 RT
 MM 156.090 LT
 900.640 SPECIAL PROVISION (REPLACEMENT OF GUARDRAIL CABLE)
 SEE ITEM DETAIL SUMMARY SHEETS

NORTHBOUND CONT.
 RAMP D 0.056 RT
 RAMP D 0.103 RT
 156.383 RT
 160.389 RT & LT
 161.378 RT

616.41 REMOVAL OF EXISTING CURB
 SEE ITEM DETAIL SUMMARY SHEETS
 621.20 STEEL BEAM GUARDRAIL, GALVANIZED
 SEE ITEM DETAIL SUMMARY SHEETS
 621.50 MANUFACTURED TERMINAL SECTION, FLARED
 SEE ITEM DETAIL SUMMARY SHEETS
 621.60 ANCHOR FOR STEEL BEAM RAIL
 SEE ITEM DETAIL SUMMARY SHEETS
 621.65 ANCHOR FOR CABLE RAIL
 SEE ITEM DETAIL SUMMARY SHEETS
 621.76 REPLACE GUARDRAIL POST ASSEMBLY
 SEE ITEM DETAIL SUMMARY SHEETS
 621.77 REPLACE GUARDRAIL BEAM UNIT
 SEE ITEM DETAIL SUMMARY SHEETS
 621.80 REMOVAL AND DISPOSAL OF GUARDRAIL
 SEE ITEM DETAIL SUMMARY SHEETS

646.426 DURABLE 6 INCH WHITE LINE, RECESSED POLYUREA
 NORTHBOUND:
 MM 155.989 - MM 163.000 CL (DASHED)
 MM 155.989 - MM 163.000 RT (SOLID)
 .995 .020
 SOUTHBOUND:
 MM 155.987 - MM 163.000 CL (DASHED)
 MM 155.987 - MM 163.000 LT (SOLID)
 156.006 .010

- NOTES:
- THE CONTRACTOR SHALL INSTALL MILLED RUMBLE STRIPS WITHIN THE PROJECT LIMITS AND AS SHOWN ON THE MILLED RUMBLE STRIPS DETAIL SHEET OR AS DIRECTED BY THE RESIDENT ENGINEER.
 - THE CONTRACTOR SHALL REHAB. THE EXISTING DROP INLETS, CATCH BASINS OR MANHOLES TO A DEPTH AS DIRECTED BY THE RESIDENT ENGINEER. ALL REHAB. WORK WILL BE PAID FOR UNDER THE APPLICABLE REHAB. ITEM AS DIRECTED BY THE RESIDENT ENGINEER.

**MAINLINE
LAYOUT
SHEET**

PROJECT NAME: BARTON-IRASBURG
 PROJECT NUMBER: IM 091-3(48)
 FILE NAME: p07a286.dgn PLOT DATE: 06-JUL-2011
 PROJECT LEADER: JLL DRAWN BY: STANTEC
 DESIGNED BY: STANTEC CHECKED BY: STANTEC
 IPARM FILE: p07a286pls.i SHEET 14 OF 40

