



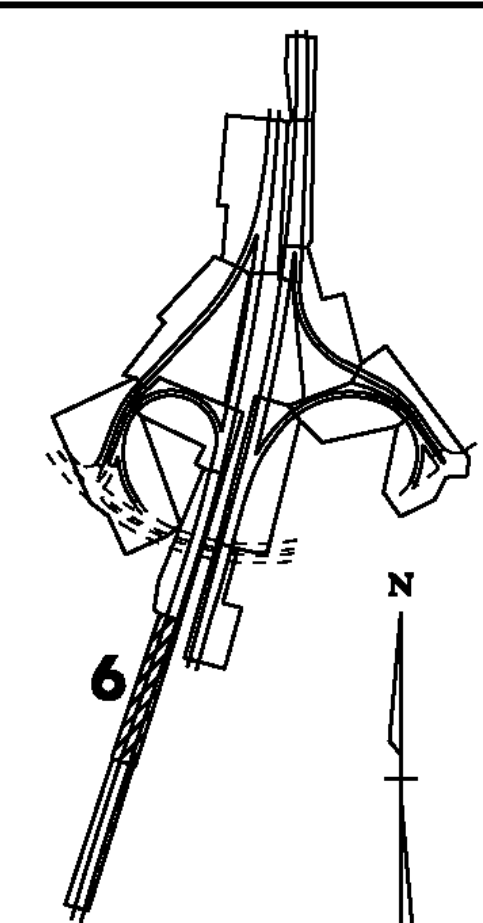

KEY PLAN

646.426 DURABLE 6 INCH WHITE LINE, RECESSED POLYUREA
STA. B16+50 TO B22+50, SOLID RT (EDGE LINE)
STA. B16+50 TO B22+50, DOTTED LT

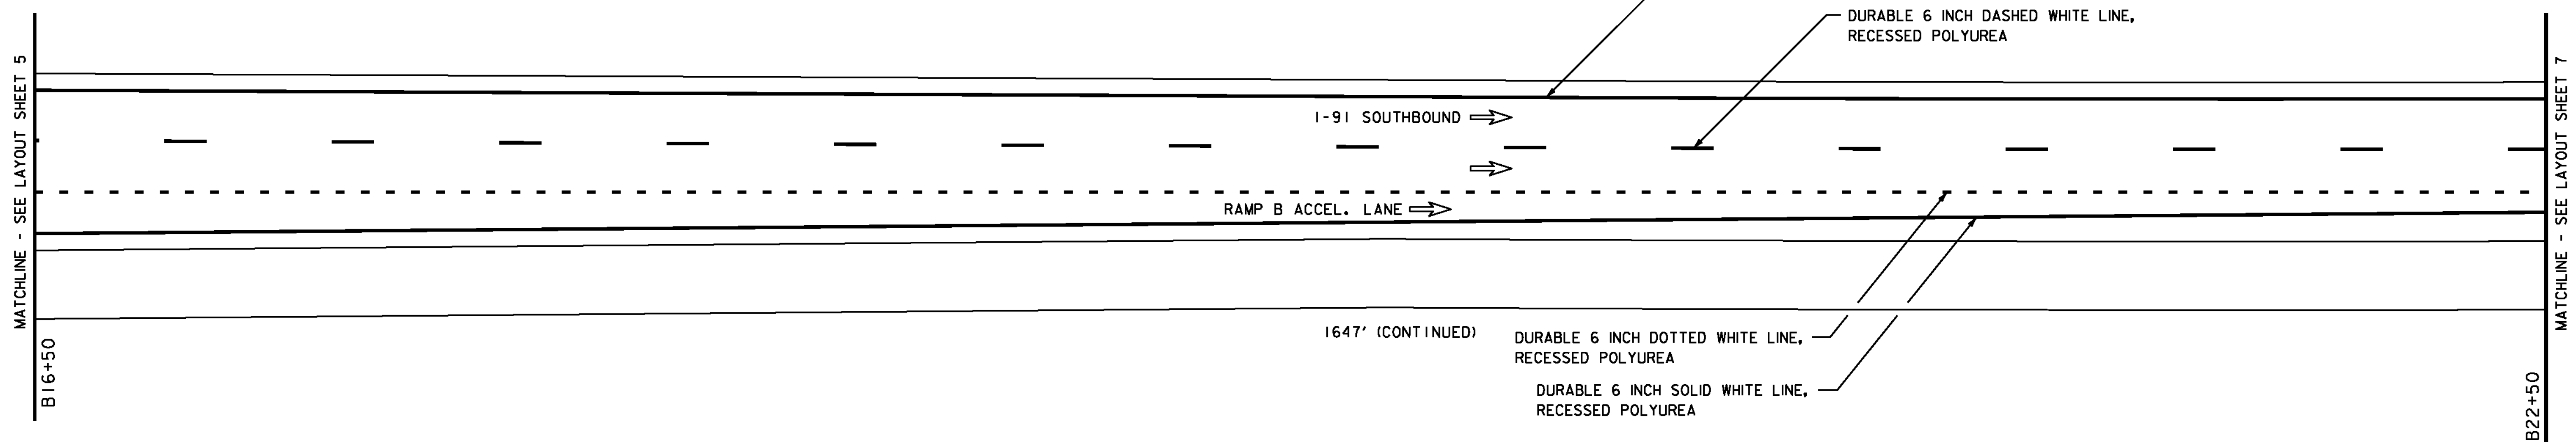

UTILITY LEGEND

= EXISTING DI

= EXISTING SIGN POST

= EXISTING GUARDRAIL

= EXISTING CULVERT

SIGN LEGEND

N = NEW

R = REMOVE

R&S = REMOVE & SALVAGE

S = SALVAGE SIGN

RET = RETAIN

B-B = BACK TO BACK



INTERCHANGE 26 LAYOUT SHEET #6

NOTE: ALL EXISTING SIGNS NOT SHOWN SHALL BE RETAINED.

PROJECT NAME: BARTON-IRASBURG

PROJECT NUMBER: IM 09I-3(48)

FILE NAME: p07a286.dgn

PROJECT LEADER: JLL

DESIGNED BY: STANTEC

IPARM FILE: p07a286I12.i

PLOT DATE: 06-JUL-2011

DRAWN BY: STANTEC

CHECKED BY: STANTEC

SHEET 27 OF 40