
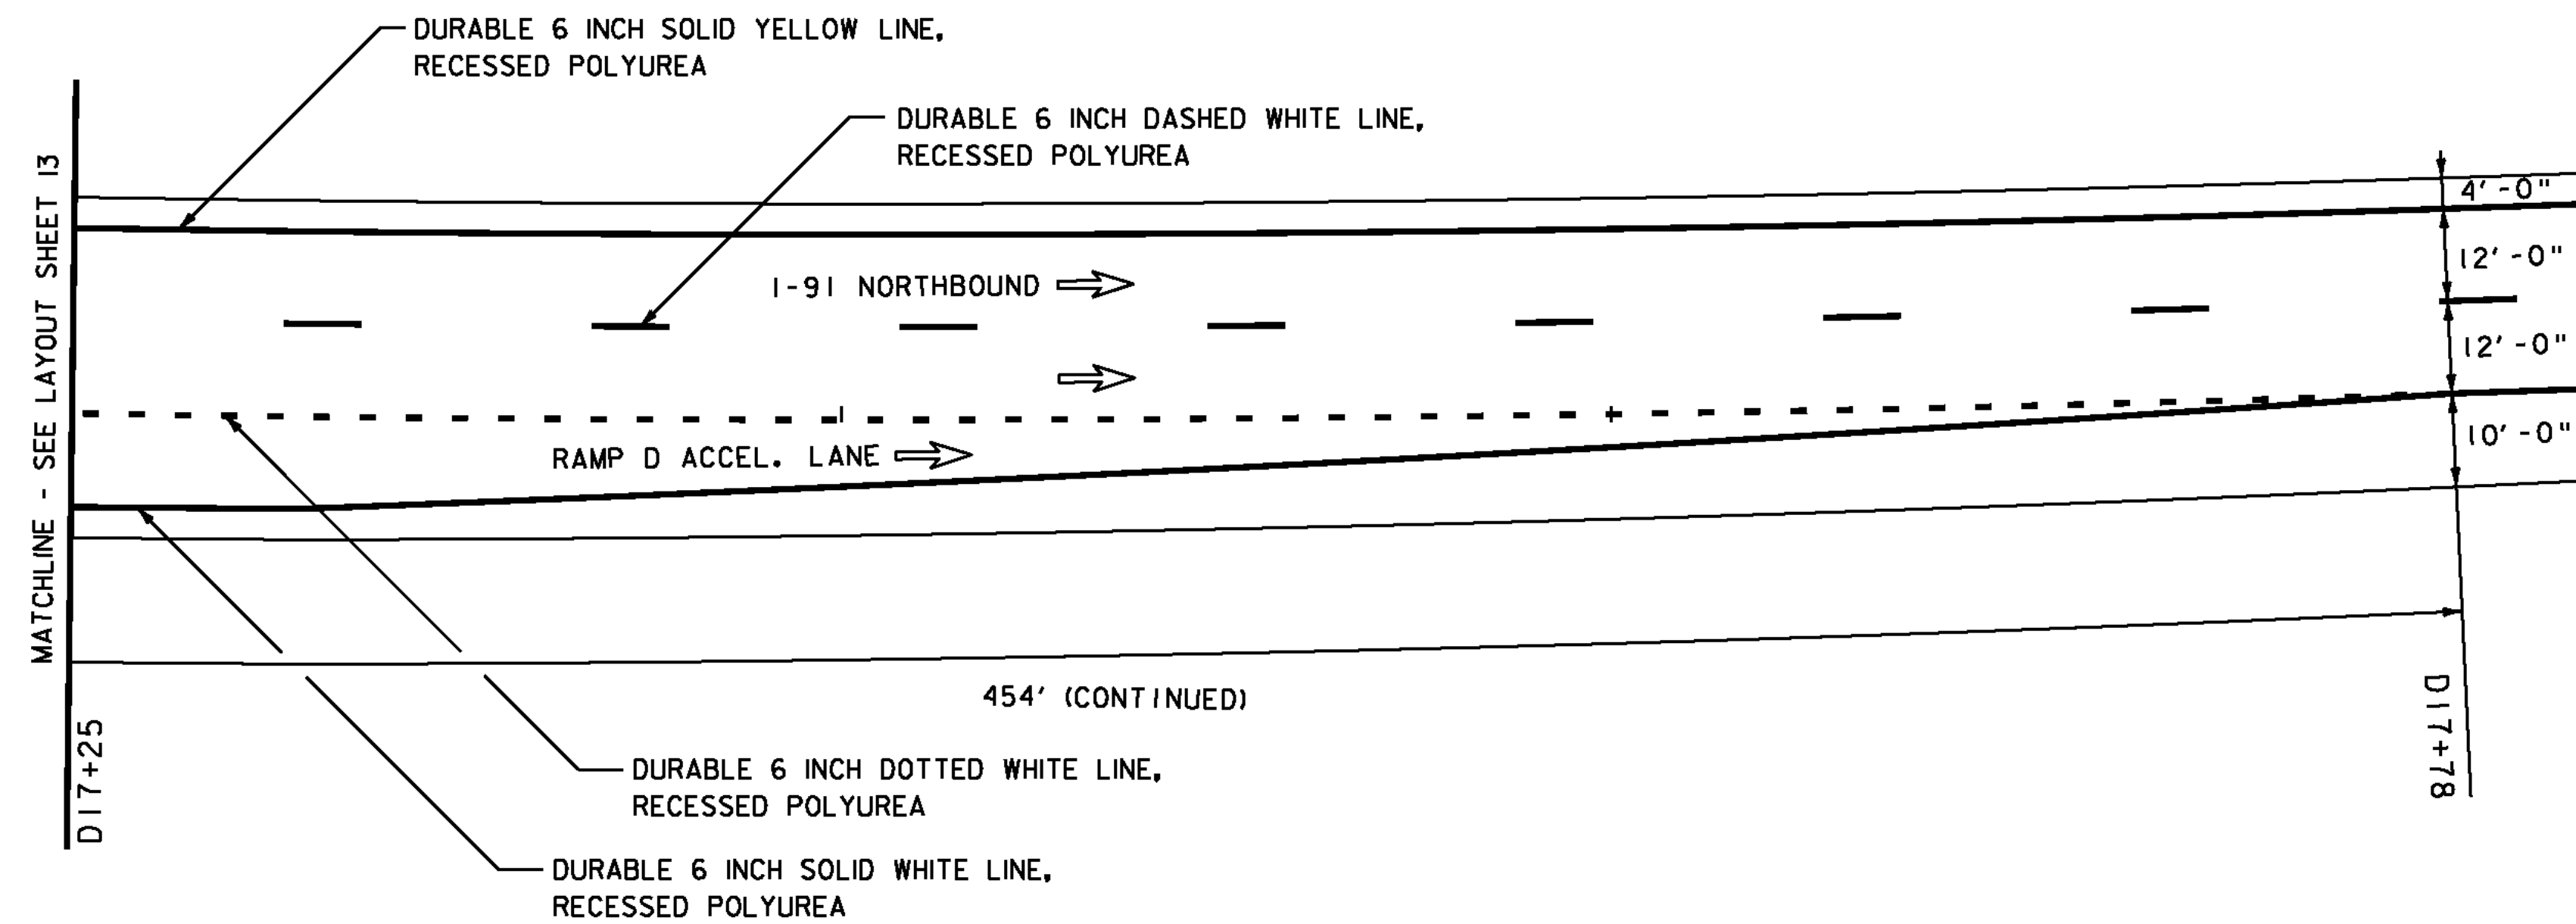


646,426 DURABLE 6 INCH WHITE LINE, RECESSED POLYUREA  
 STA. D17+25 TO D19+78, SOLID RT (EDGE LINE)  
 STA. D17+25 TO D19+78 LT DOTTED

646,622 TEMPORARY 6 INCH WHITE LINE, PAINT  
 STA. D17+25 TO D19+78, SOLID RT (EDGE LINE)  
 STA. D17+25 TO D19+78 LT DOTTED

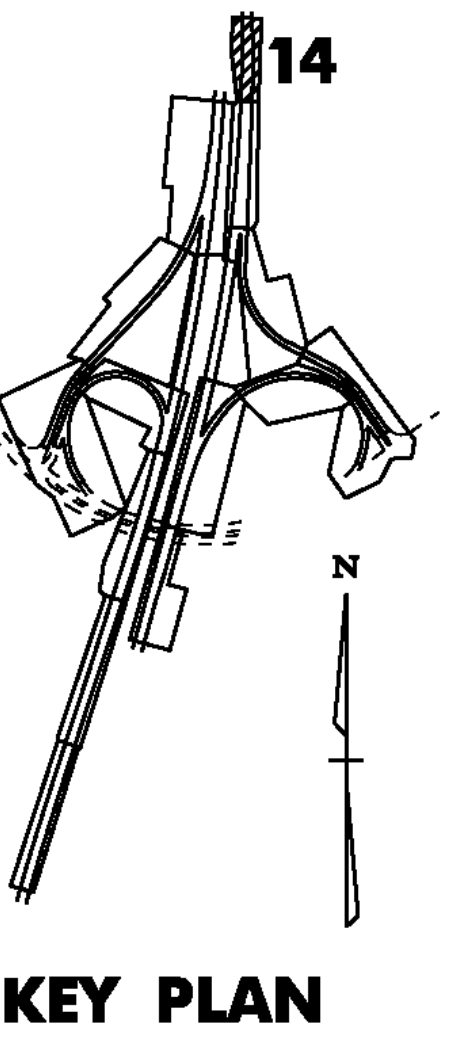

UTILITY LEGEND	
	= EXISTING DI
	= EXISTING SIGN POST
	= EXISTING GUARDRAIL
	= EXISTING CULVERT

SIGN LEGEND	
N	= NEW
R	= REMOVE
R&S	= REMOVE & SALVAGE
S	= SALVAGE SIGN
RET	= RETAIN
B-B	= BACK TO BACK

NOT TO SCALE

NOTE:  
 ALL EXISTING SIGNS NOT SHOWN SHALL BE RETAINED.

**INTERCHANGE  
 26 LAYOUT  
 SHEET #14**

PROJECT NAME: BARTON-IRASBURG  
 PROJECT NUMBER: IM 091-3(48)

FILE NAME: p07a286.dgn  
 PROJECT LEADER: JLL  
 DESIGNED BY: STANTEC  
 IPARM FILE: p07a286120.i

PLOT DATE: 06-JUL-2011  
 DRAWN BY: STANTEC  
 CHECKED BY: STANTEC  
 SHEET 35 OF 40

