



646.426 DURABLE 6 INCH WHITE LINE, RECESSED POLYUREA
 STA. B10+50 TO B16+50, SOLID RT (EDGE LINE)
 STA. B10+50 TO B16+50, DOTTED LT

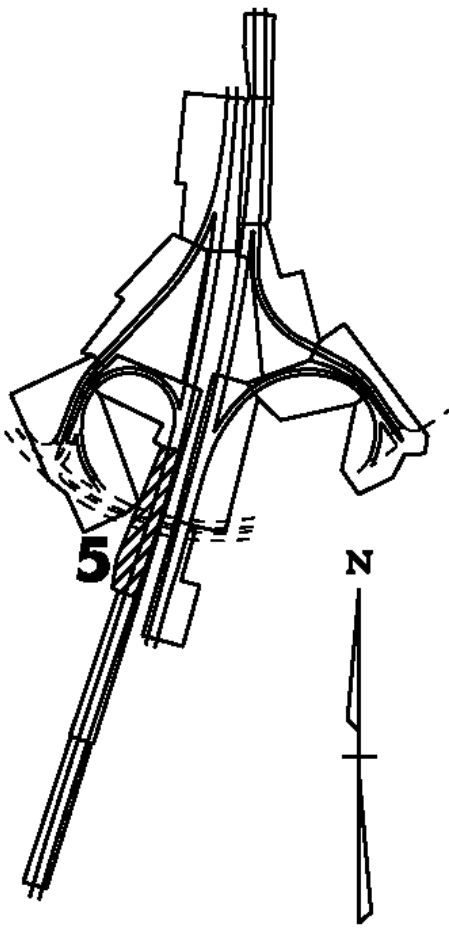

KEY PLAN

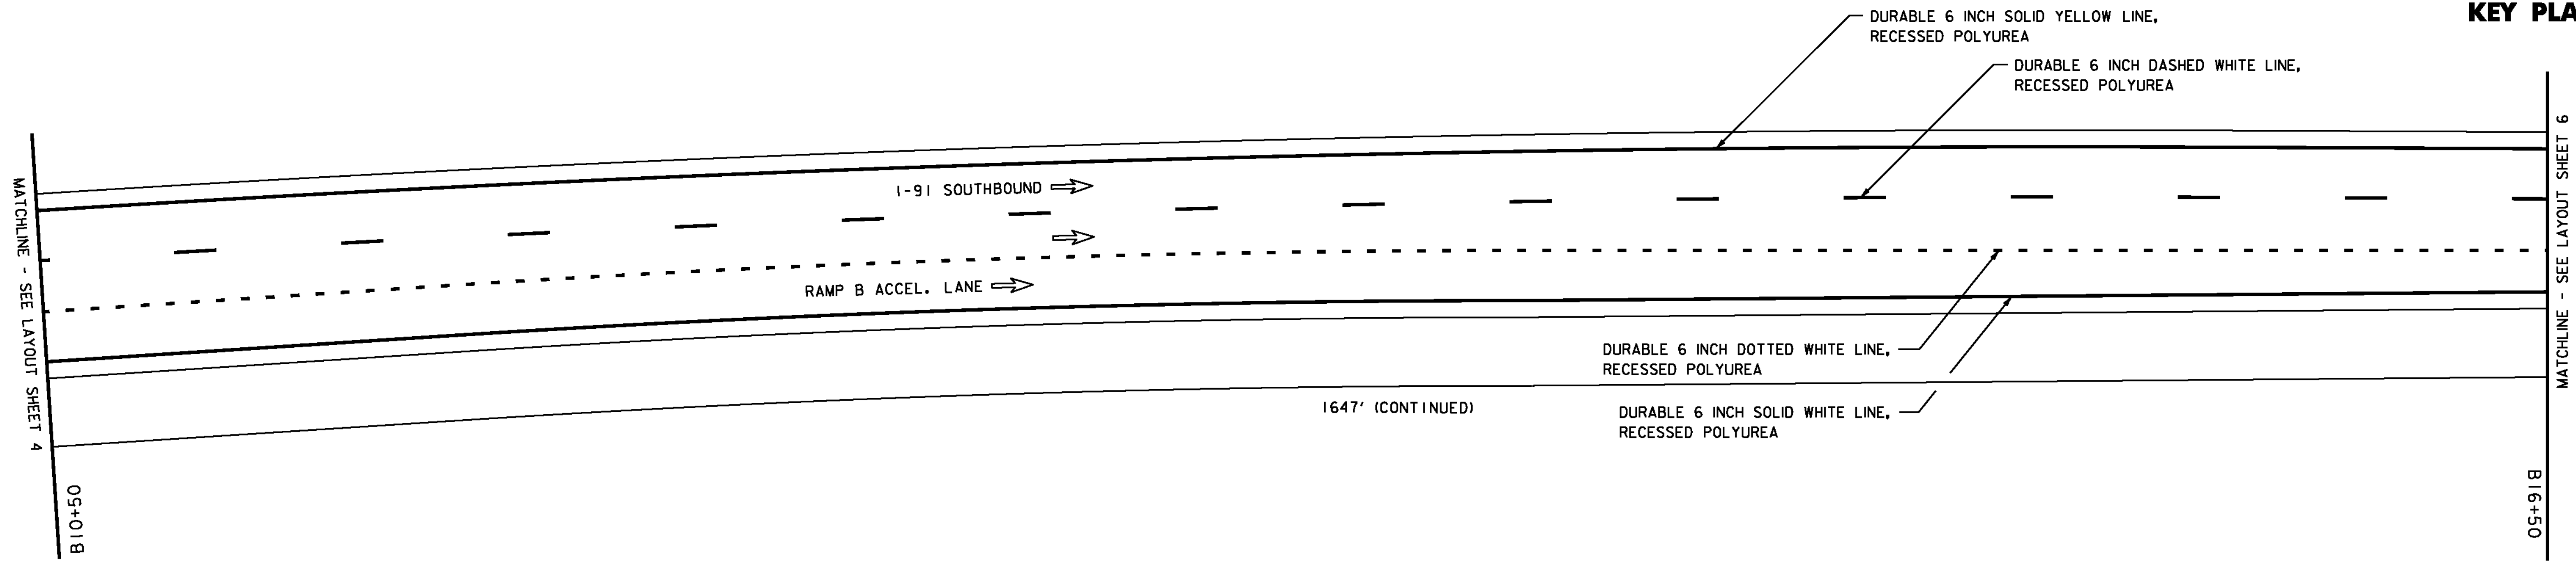

| UTILITY LEGEND | |
|----------------|----------------------|
| | = EXISTING DI |
| | = EXISTING SIGN POST |
| | = EXISTING GUARDRAIL |
| | = EXISTING CULVERT |

| SIGN LEGEND | |
|-------------|--------------------|
| N | = NEW |
| R | = REMOVE |
| R&S | = REMOVE & SALVAGE |
| S | = SALVAGE SIGN |
| RET | = RETAIN |
| B-B | = BACK TO BACK |

NOT TO SCALE
 NOTE: ALL EXISTING SIGNS NOT SHOWN SHALL BE RETAINED.



| | | |
|---|---------------------------------|------------------------|
| INTERCHANGE 26 LAYOUT SHEET #5 | PROJECT NAME: BARTON-IRASBURG | PLOT DATE: 06-JUL-2011 |
| | PROJECT NUMBER: IM 091-3(48) | DRAWN BY: STANTEC |
| | FILE NAME: p07a286.dgn | CHECKED BY: STANTEC |
| | DESIGNED BY: STANTEC | SHEET 26 OF 40 |
| | IPARM FILE: p07a286111.i | |