

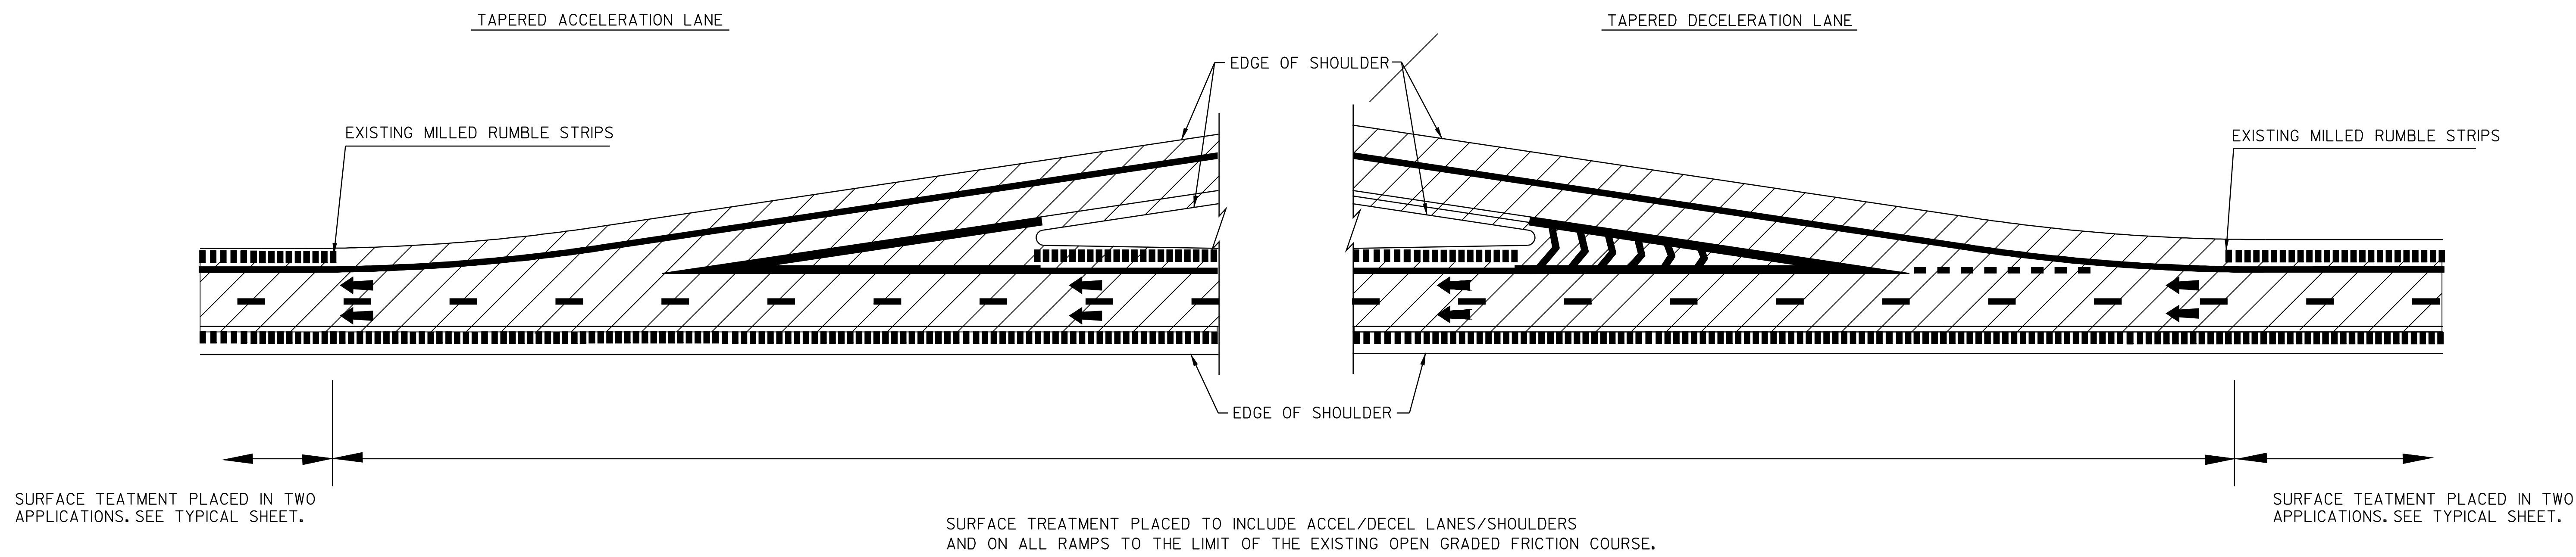


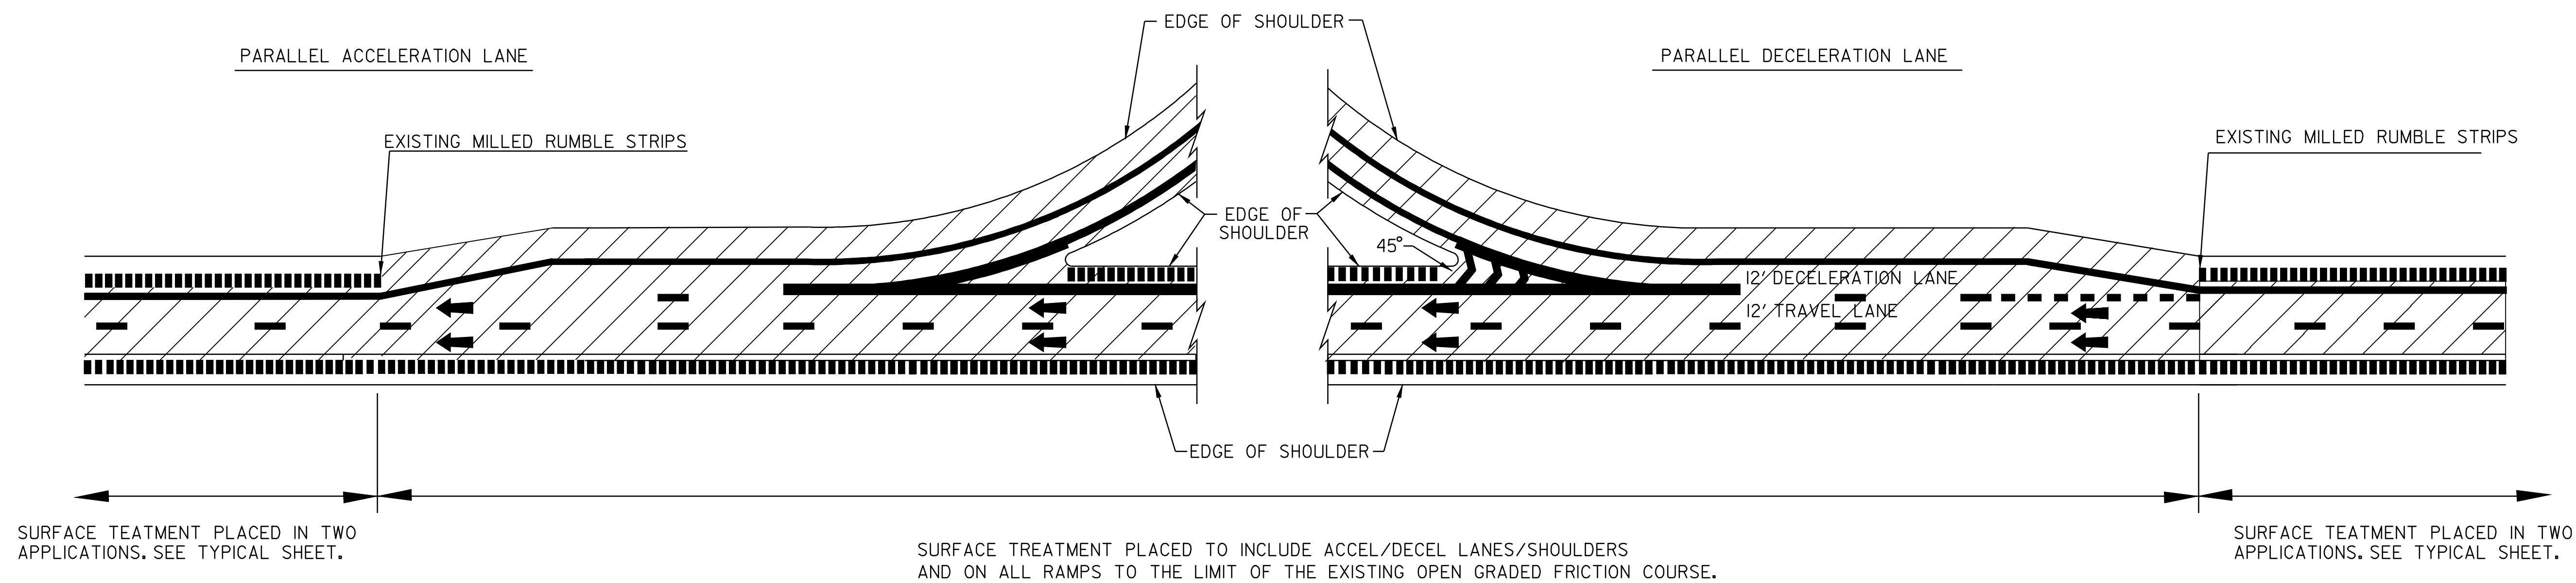

TYPICAL INTERCHANGE SURFACING DETAILS

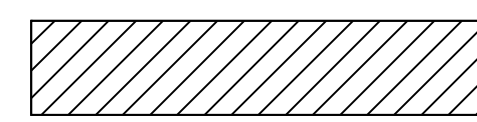

LEGEND

-  = AREA OF MICROSURFACE TREATMENT, TYPE II
-  DIRECTION OF TRAFFIC FLOW
-  MILLED RUMBLE STRIPS

NOTES:
1. LINE STRIPING SHOWN FOR REFERENCE ONLY.

N.T.S.

INTERCHANGE SURFACING DETAILS

PROJECT NAME: NEWBURY-BARNET
PROJECT NUMBER: IM SURF(6)

FILE NAME: /pave/07a290/p07a290.dgn
PROJECT LEADER: DOMEY
DESIGNED BY: KAS
pa290d+02.1

PLOT DATE: 18-FEB-2010
DRAWN BY: KAS
CHECKED BY: JLR
SHEET 5 OF 7