

INDEX OF SHEETS

SEE SHEET 2

VAOT STANDARD SHEETS

SEE SHEET 2

RECORD PLANS

CONTRACTOR: PARENT CONSTRUCTION - HINESBURG, VT
 RESIDENT ENGINEER: DAVID HOSKING
 CONSTRUCTION BEGAN: JULY 20, 2010
 CONSTRUCTION COMPLETE: OCTOBER 6, 2010
 RECORD PLANS BY: DAVID HOSKING & JENNA HYDE

I HEREBY CERTIFY THAT ALL THE CONSTRUCTION REQUIRED BY THIS SET OF DRAWINGS HAS BEEN ACCOMPLISHED AS INDICATED HEREIN.


BY: *David Hosking* RESIDENT ENGINEER
 DATE: 9/5/12

NOTE: Any further information concerning final quantities, amounts or other details relative to this project may be found at Central Files in the electronic archives.

STATE OF VERMONT
 AGENCY OF TRANSPORTATION



PROPOSED IMPROVEMENT
 CULVERT REHABILITATION PROJECT
 TOWNS OF RICHMOND AND WILLISTON
 COUNTY OF CHITTENDEN
 BRIDGE NUMBERS 59-2 AND 59-4S CULVERTS
 ON INTERSTATE 89

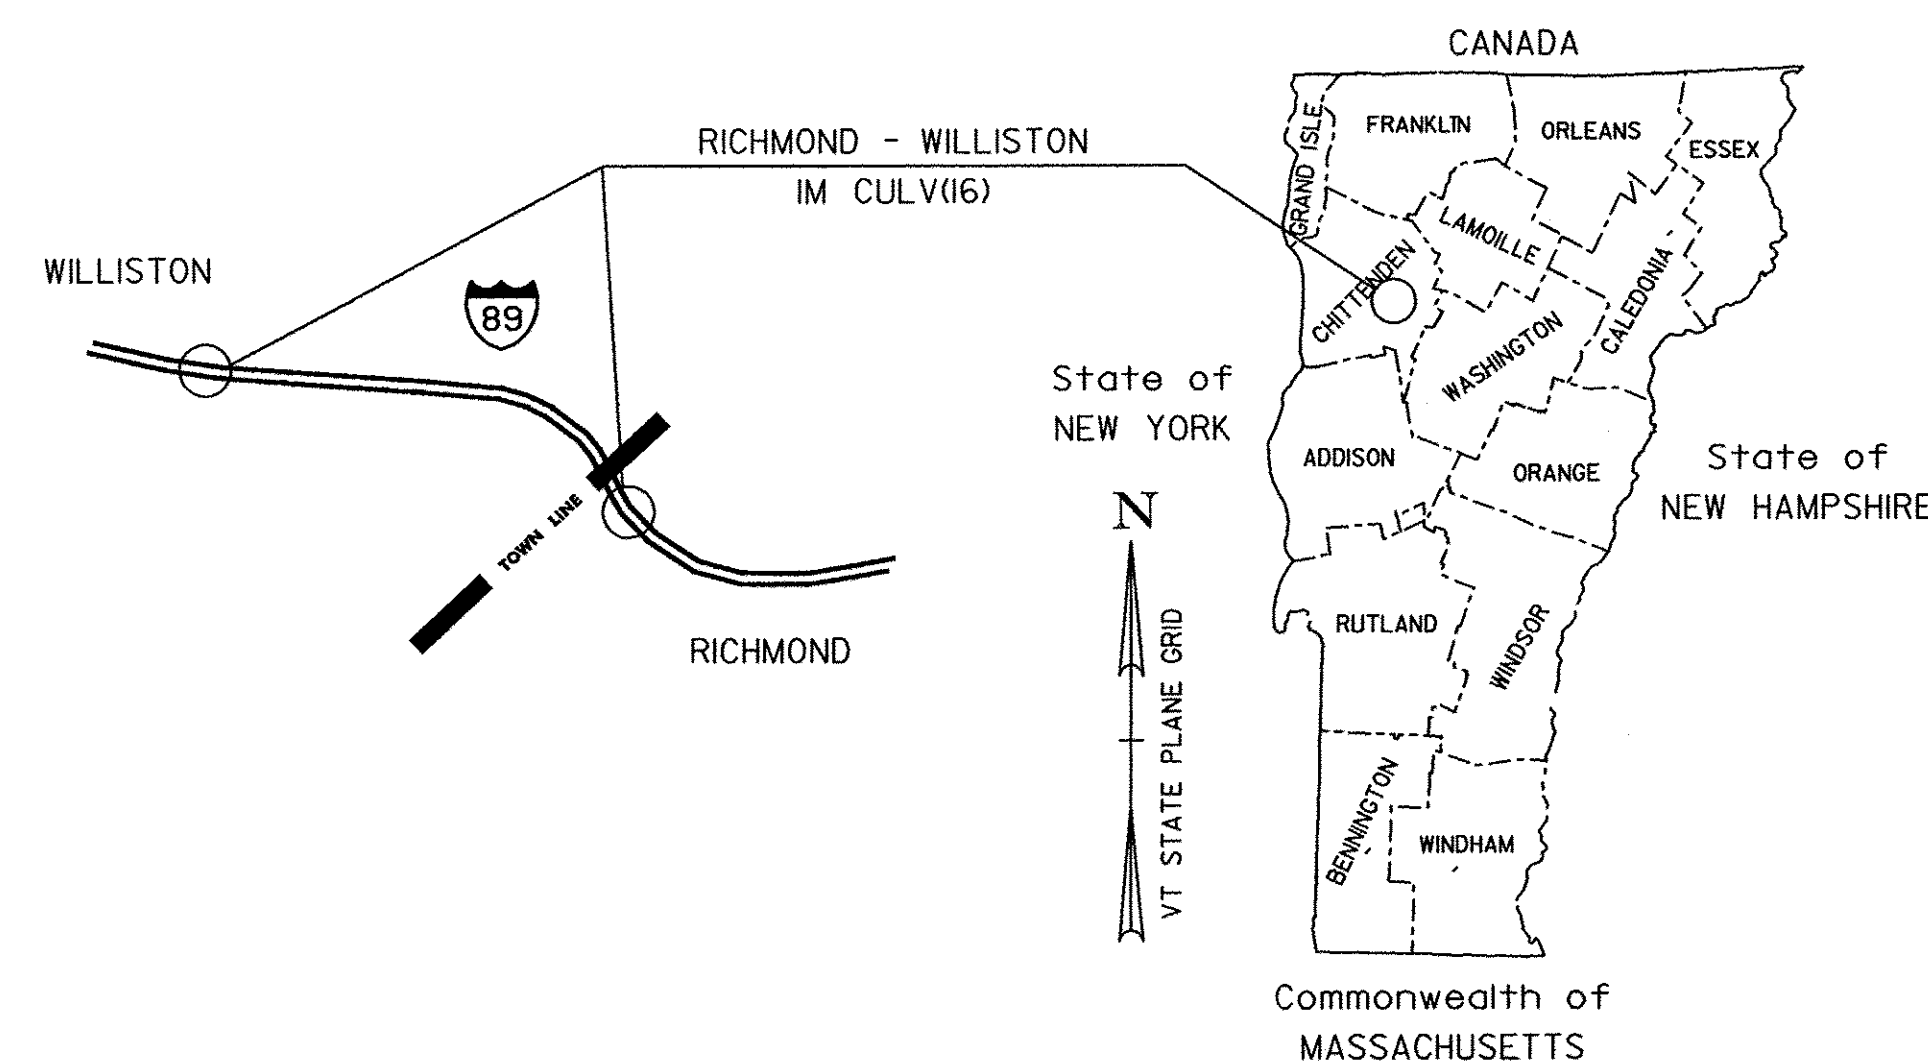

PROJECT LOCATIONS: BRIDGE 59-2 IS LOCATED ON INTERSTATE 89 IN RICHMOND AT MILE MARKER 79.5
 BRIDGE 59-4S IS LOCATED ON INTERSTATE 89 IN WILLISTON AT MILE MARKER 81.5



PROJECT DESCRIPTION: THIS PROJECT INVOLVES PREVENTATIVE MAINTENANCE TO EXISTING CULVERTS INCLUDING LINING CULVERT 59-2 AND CONCRETE PAVING THE INVERT OF CULVERT 59-4S AND ASSOCIATED CHANNEL WORK.

CONVENTIONAL SYMBOLS

COUNTY LINE	
TOWN LINE	
LIMITS OF ACCESS	
POINT OF ACCESS	
FENCE LINE	
STONE WALL	
TRAVELED WAY	
GUARD RAIL	
RAILROAD	
SURVEY LINE	
CULVERT	
POWER POLE	
TELEPHONE POLE	
TREES	
CONTROL OF ACCESS	
PROPERTY LINE	
R.O.W. TAKING LINE	
SLOPE RIGHTS	
TOP OF CUT	
TOE OF SLOPE	


SURVEYED BY : N/A
 SURVEYED DATE :

DATUM
 VERTICAL : N/A
 HORIZONTAL : N/A

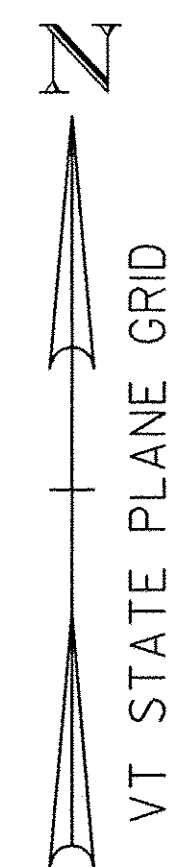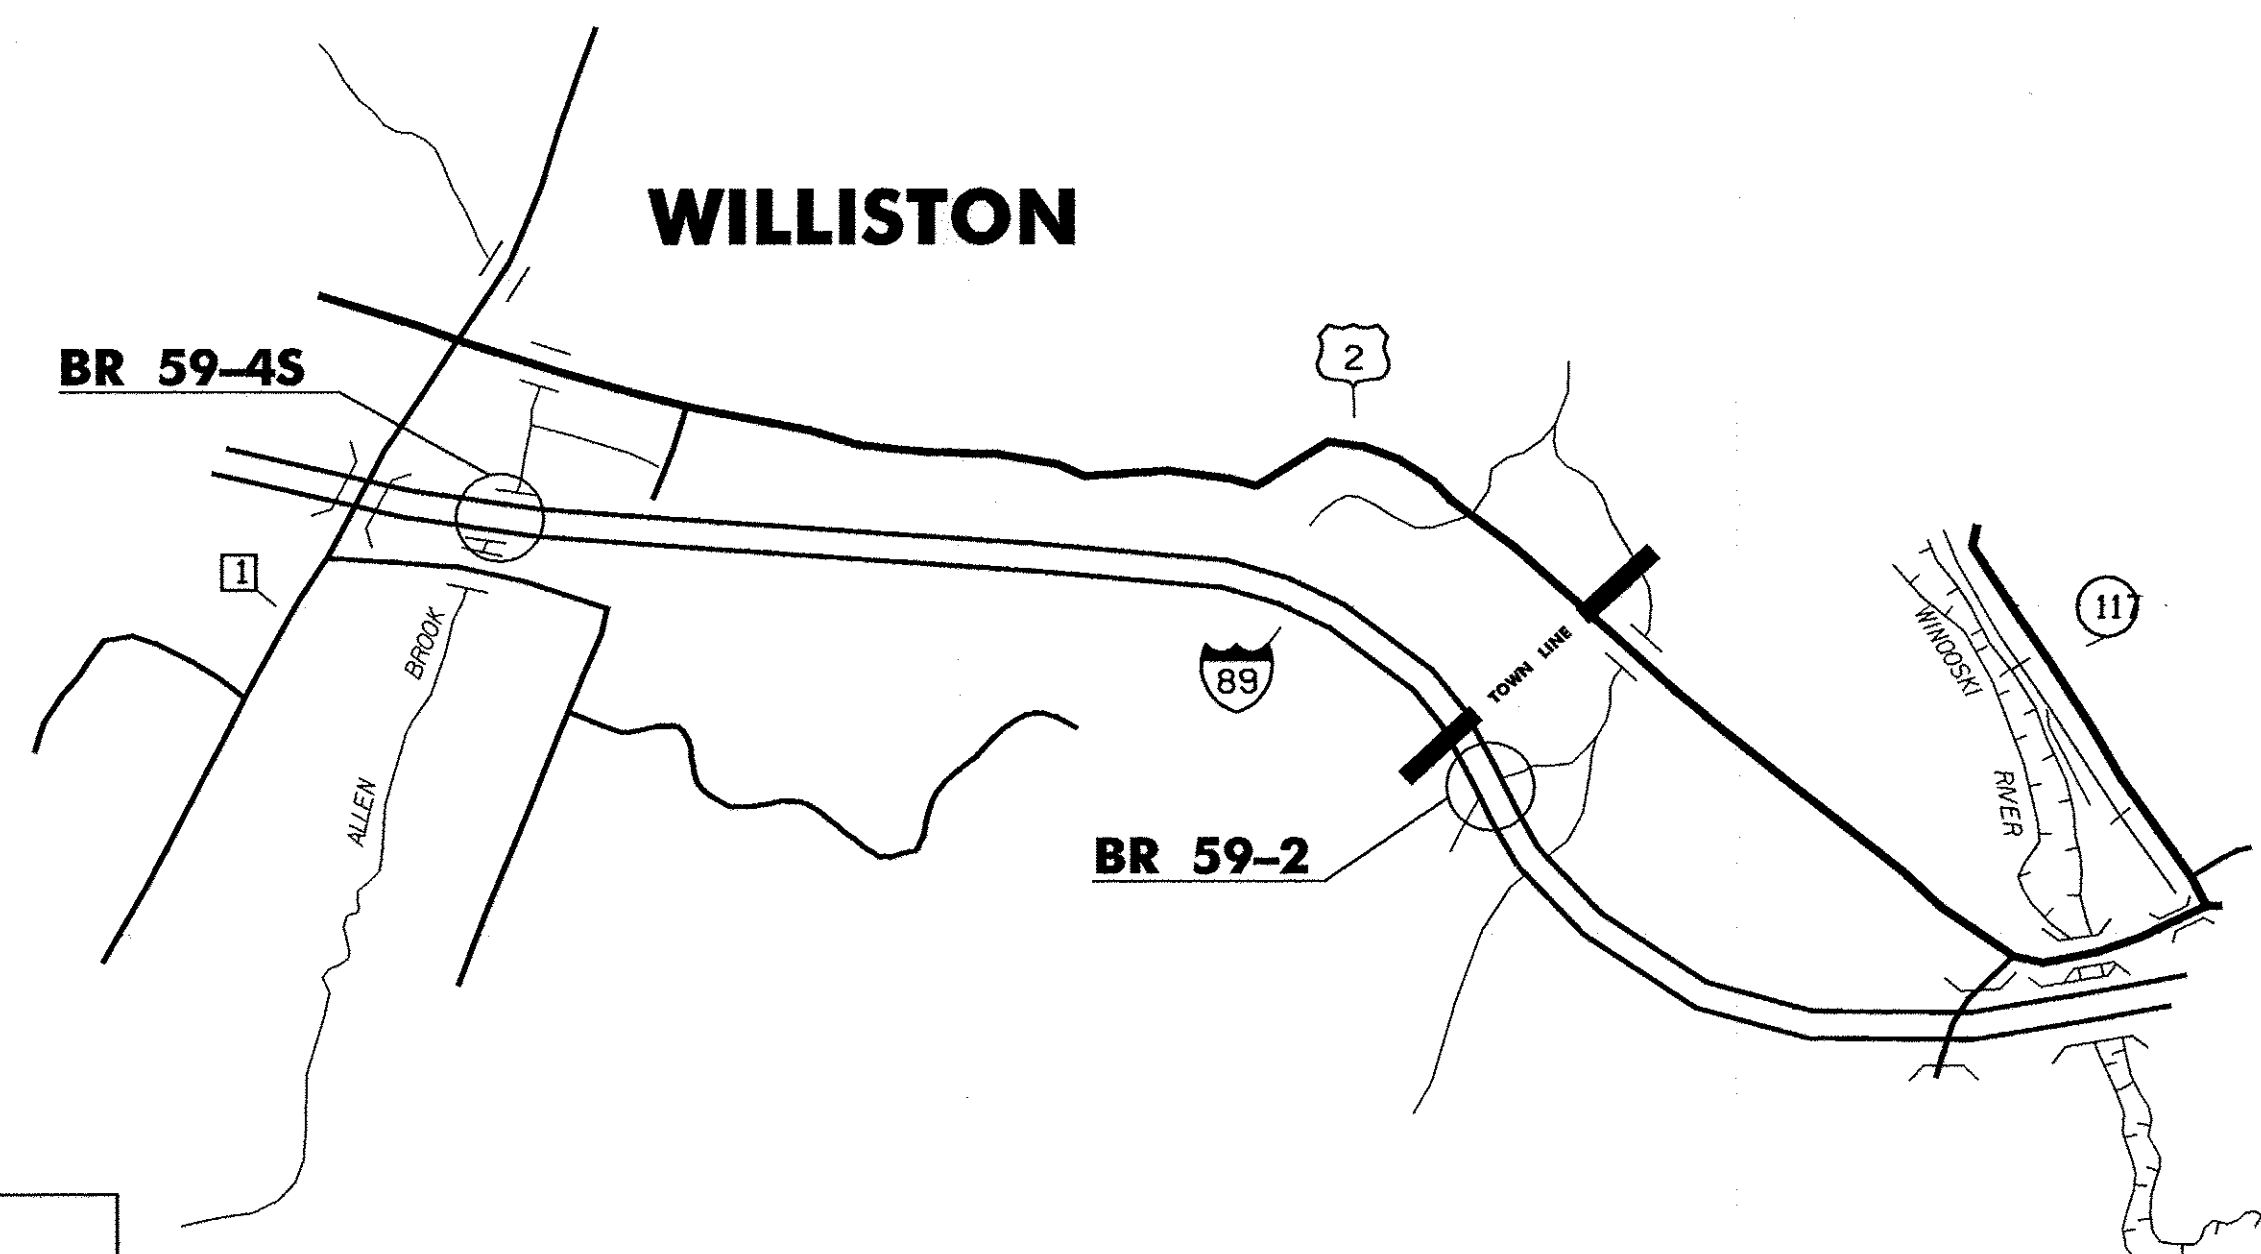

THESE PLANS ARE SUBJECT TO SUCH ENGINEERING CHANGES AS MAY BE REQUIRED BY THE FEDERAL HIGHWAY ADMINISTRATION OR THE DIRECTOR OF PROGRAM DEVELOPMENT.
 CONSTRUCTION IS TO BE CARRIED ON IN ACCORDANCE WITH THESE PLANS AND THE STANDARD SPECIFICATIONS FOR CONSTRUCTION DATED 2006, AS APPROVED BY THE FEDERAL HIGHWAY ADMINISTRATION ON JUNE 15, 2006 FOR USE ON THIS PROJECT, INCLUDING ALL SUBSEQUENT REVISIONS AND SUCH REVISED SPECIFICATIONS AND SPECIAL PROVISIONS AS ARE INCORPORATED IN THESE PLANS.

RICHMOND

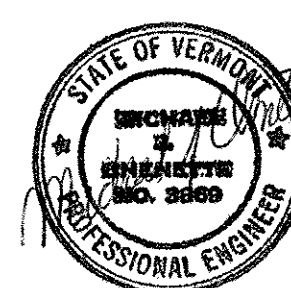

Stantec Consulting Services Inc.
 55 Green Mountain Drive
 South Burlington VT U.S.A. 05403
 Tel. 802.864.0223
 Fax. 802.864.0165
 www.stantec.com

DIRECTOR OF PROGRAM DEVELOPMENT
 APPROVED: *Sherward G. Farnsworth* DATE 3-3-10
 PROJECT MANAGER: SHERWARD G. FARNSWORTH
 PROJECT NAME : RICHMOND - WILLISTON
 PROJECT NUMBER : 1M CULV (16)
 SHEET 1 OF 18 SHEETS