

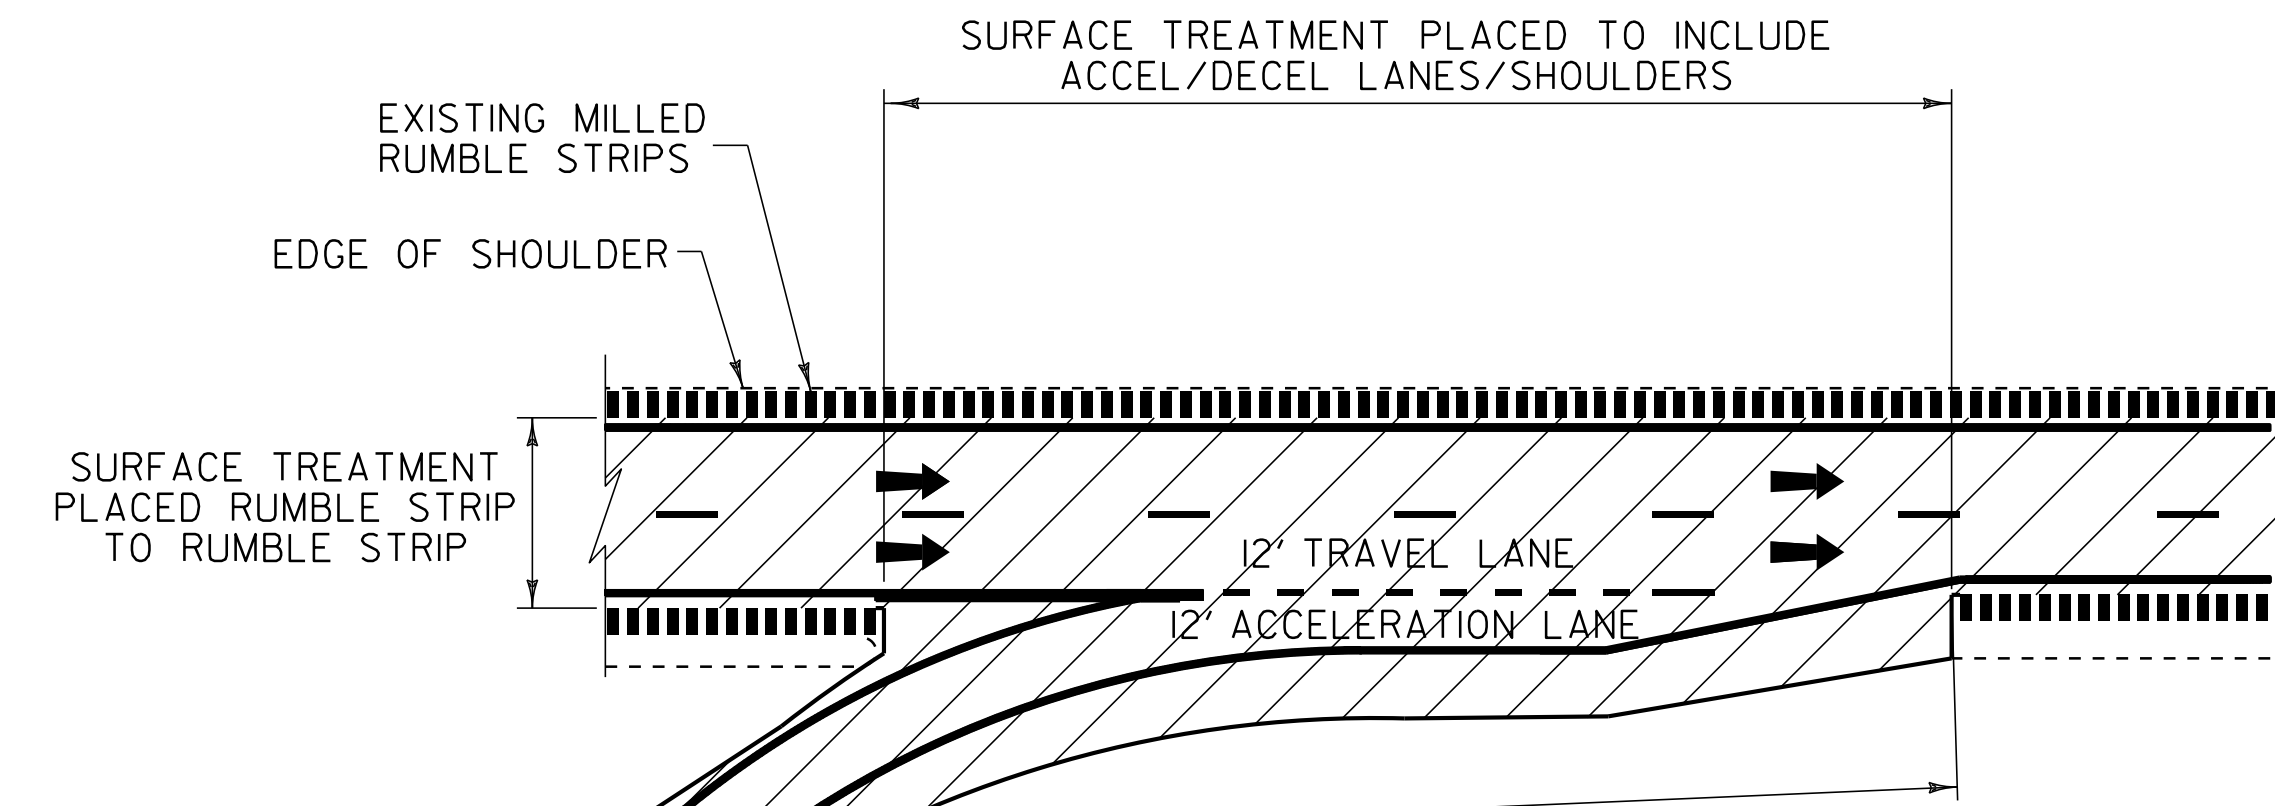


TYPICAL INTERCHANGE #5 CONSTRUCTION DETAILS

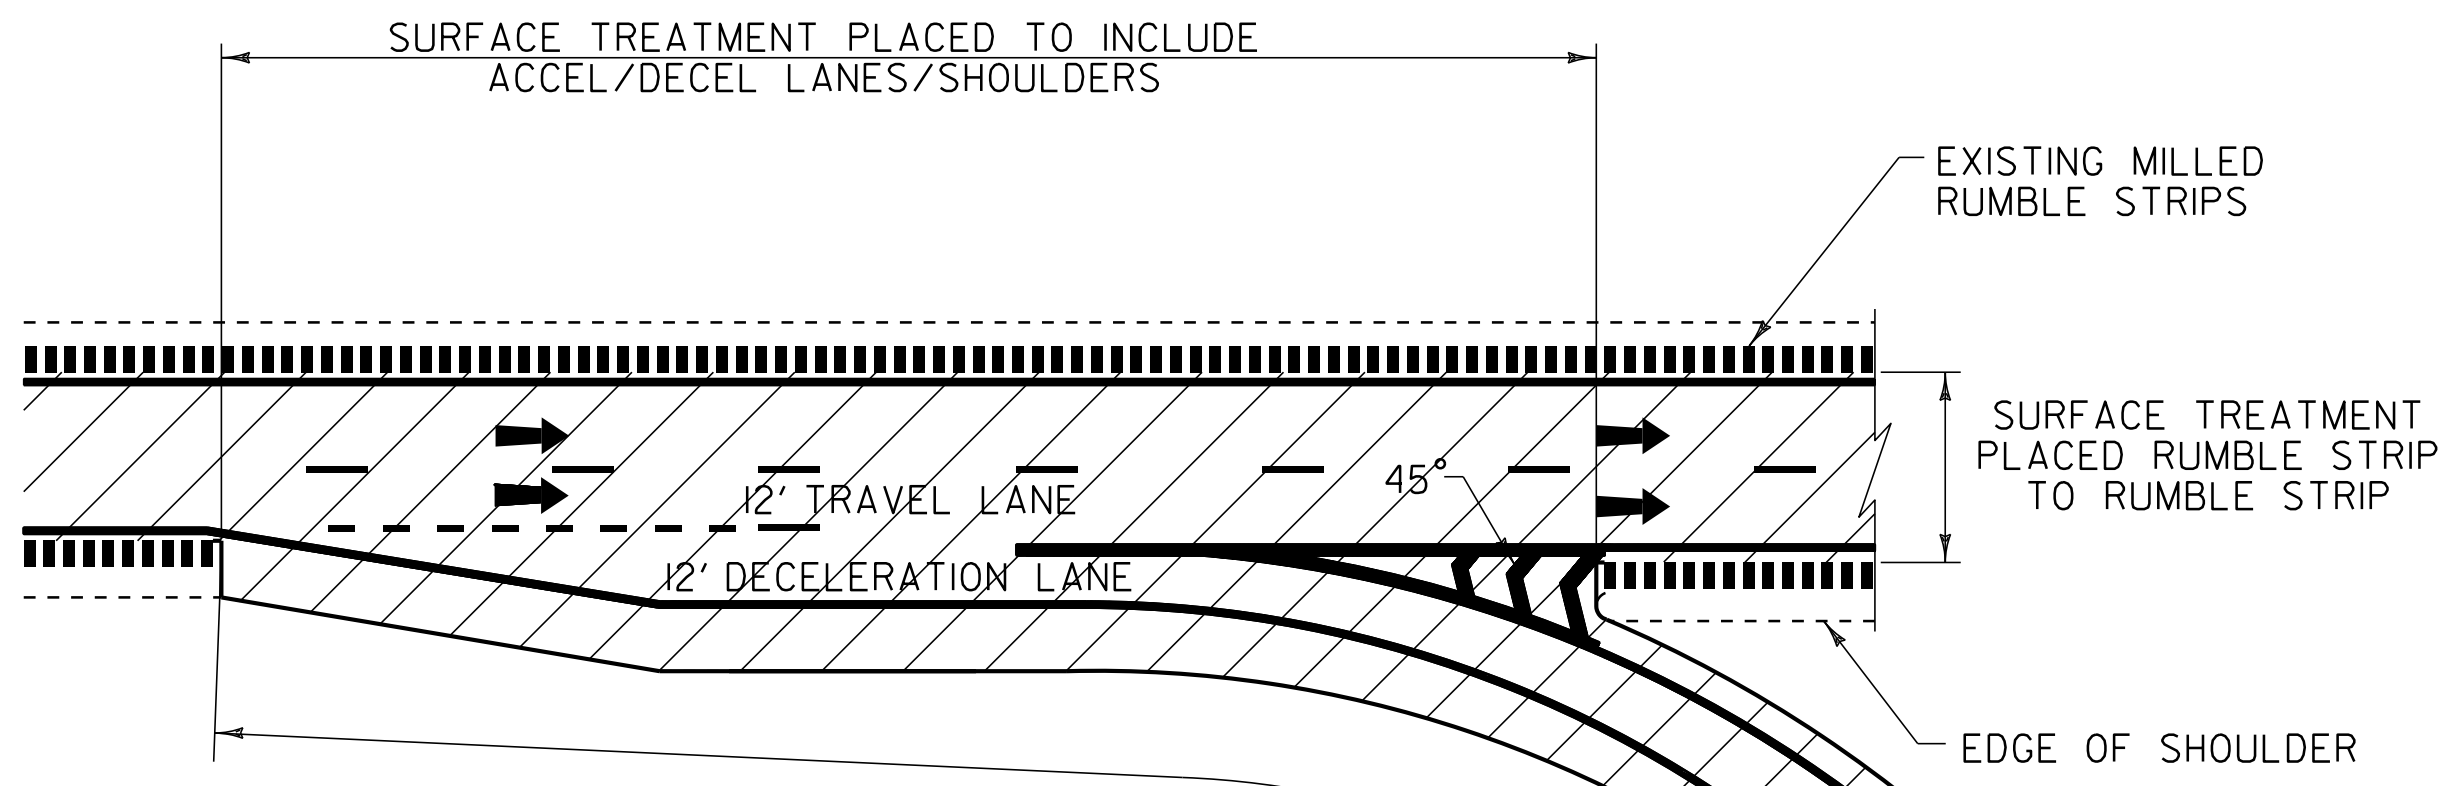


EXIT 5 OFF RAMP CONSTRUCTION DETAILS

EXIT 5 ON RAMP CONSTRUCTION DETAILS

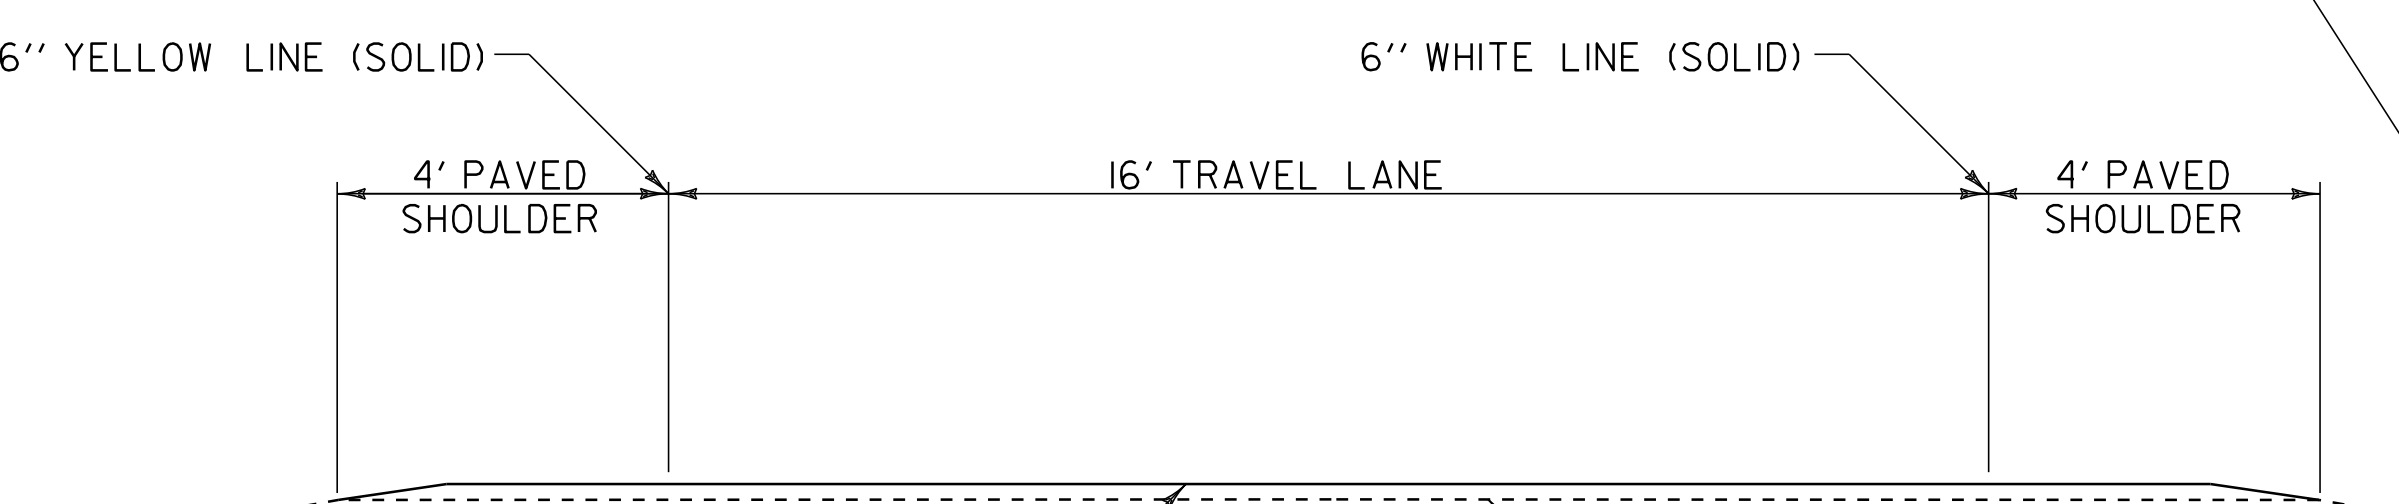

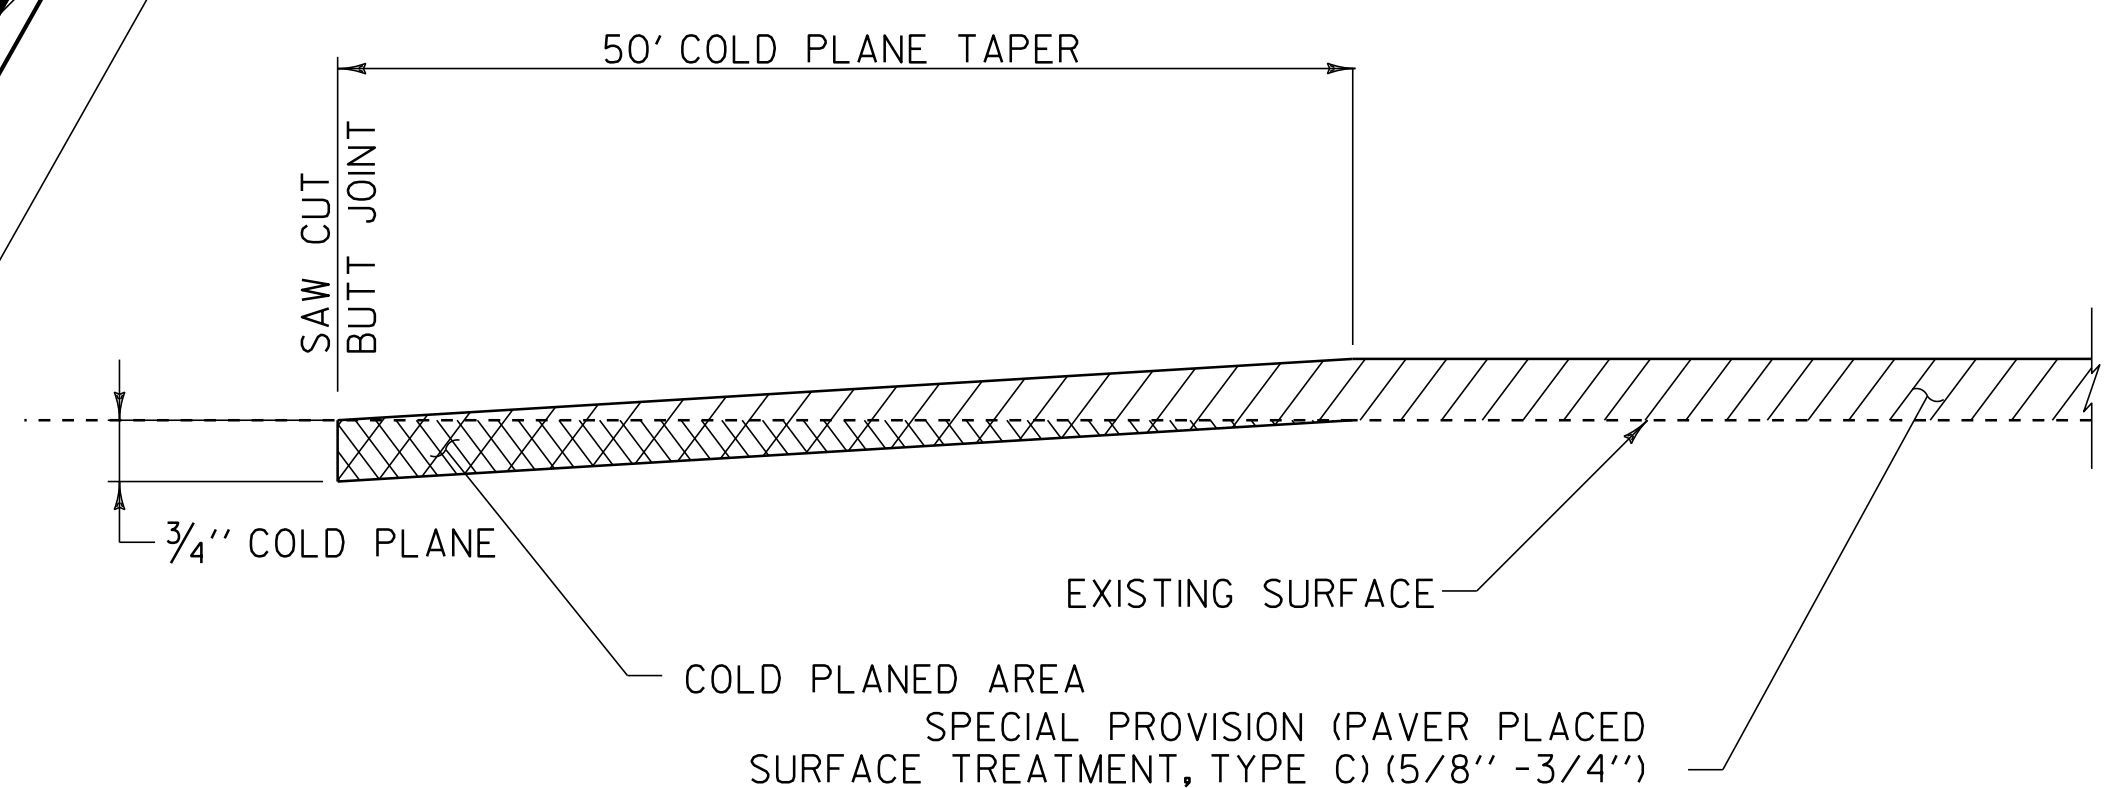


TYPICAL RAMP SECTION ALTERNATE A



COLD PLANE DETAIL AT RAMPS ALTERNATE A

NOTES:
1. SURFACE PREPARATION IS REQUIRED ON ALL RAMPS.

LEGEND

-  AREA OF TREATMENT
-  DIRECTION OF TRAFFIC FLOW
-  EXISTING MILLED RUMBLE STRIPS

NOT TO SCALE

TYPICAL INTERCHANGE #5 CONSTRUCTION DETAILS

PROJECT NAME: BROOKFIELD-BERLIN	
PROJECT NUMBER: IM SURF (II)	
FILE NAME: ...08A152\...08A152.dgn	PLOT DATE: 31-OCT-2011
PROJECT LEADER: DOMEY	DRAWN BY: HUNT
DESIGNED BY: HUNT	CHECKED BY: PAVT MGMT
IPARM FILE NAME: 08A152_08.i	SHEET 9 OF 15