

STATE OF VERMONT
DEPARTMENT OF HIGHWAYS

PROPOSED IMPROVEMENT

INTERSTATE PROJECT

TOWNS OF WEATHERSFIELD-WINDSOR-HARTLAND
COUNTY OF WINDSOR
INTERSTATE ROUTE 91
BRATTLEBORO-WHITE RIVER JCT. ROAD

CONTRACT # 4

BEGINNING AT A POINT 4.571 ± MILES SOUTHERLY OF THE WINDSOR-HARTLAND TOWN LINE AND EXTENDING NORTHERLY 2.434 MILES

LENGTH OF ROADWAY 12,734.13 FEET = 2.412 MILES

LENGTH OF BRIDGE 119.21 FEET = 0.022 MILE

LENGTH OF CONTRACT 12,853.34 FEET = 2.434 MILES

R.O.T. (1964)	3000
ADT (1964)	7060
D.M.V. (1964)	985
	53%
	70 MPH



INDEX OF SHEETS

SHEET NO. 1	Title Sheet
2	Alignment Sheet
3	Interstate Typical Cross Sections, Standard Median
4	Interstate Typical Cross Sections, Variable Median
5	Ramp Typical Cross Sections
6	Route 6 Typical Cross Sections
7-9	Quantity Sheets
10-12A	Item Details and Drainage Sheets
13-15	Particulars Sheets
20-20A(17)	Right-of-Way Detail Sheets
22-44	Plan and Profile Sheets
45-47	20 Scale Drawing Plans
48	Standard Drawing 6-41
49	Standard Drawing 6-1
50	Standard Drawing 6-3
51	Standard Drawing 6-4
52	Standard Drawing 6-15
53	Standard Drawing 6-17
54	Standard Drawing 6-2
55	Standard Drawing 6-5
56	Standard Drawing 6-6
57	Standard Drawing 6-8
58	Standard Drawing 6-11
59	Standard Drawing 6-13
60	Standard Drawing 6-14
61	Standard Drawing 6-16
62	Standard Drawing 6-17
63	Standard Drawing 6-21
64-65	66 100 Series, Structures S.D.A. #1 (See Sheet 65 for Details)
66-69	Bridge Standard Sheet, SDPG-30-45-Sheets 1 thru 4
70	Bridge Standard Sheet-30-11-02
71	Bridge Standard Sheet-30-15-02
72	Bridge Standard Sheet-30-15-02
73	Bridge Standard Sheet-30-15-02
74	Bridge Standard Sheet-30-15-02-Sheets 1 and 2
75	Plan and Elevation, 66' CGM Wash Brook
76-102	Channel Cross Sections (Standard Brook)
103-114	66 200 Series, Structures S.D.S. #5 (See Sheet 103 for Details)
115-125	Bridge Standard Drawings (See Sheet 103 for Details)
126-257	Ready Cross Sections
258-267	U.S. #1 Cross Sections
268-273	Ramp #1 Cross Sections
274-276	Ramp #2 Cross Sections
277-279	Ramp #3 Cross Sections
280-282	Ramp #4 Cross Sections
283-287	State #1 #1 Cross Sections




THESE PLANS HAVE BEEN REDUCED PHOTOGRAPHICALLY TO APPROXIMATELY 1/2 SCALE

FED. ROAD DISTRICT NO.	STATE	PROJECT NO.	YEAR	SHEET NO.	TOTAL SHEETS
1	VT	191-1(21)	1964	1	39

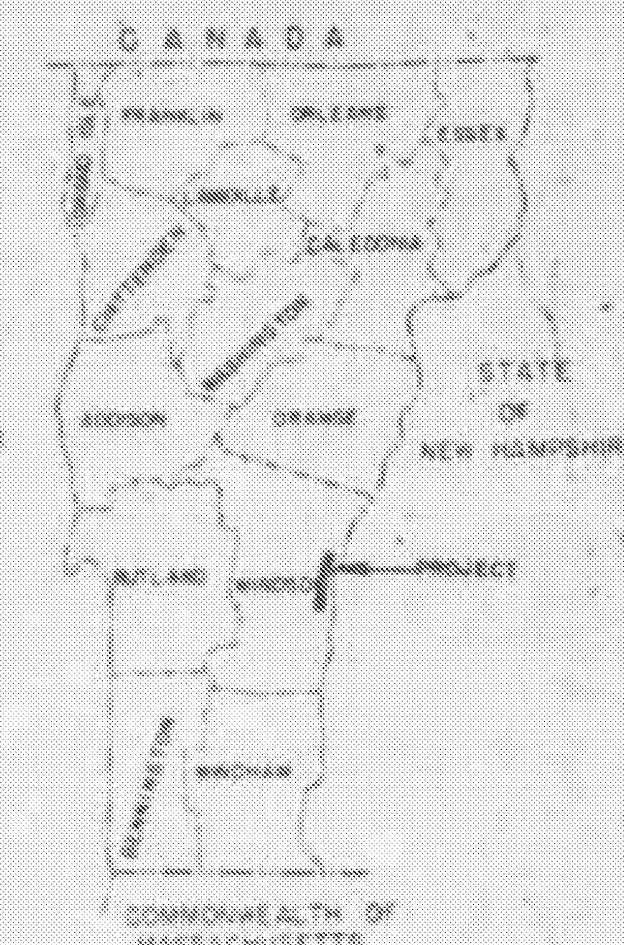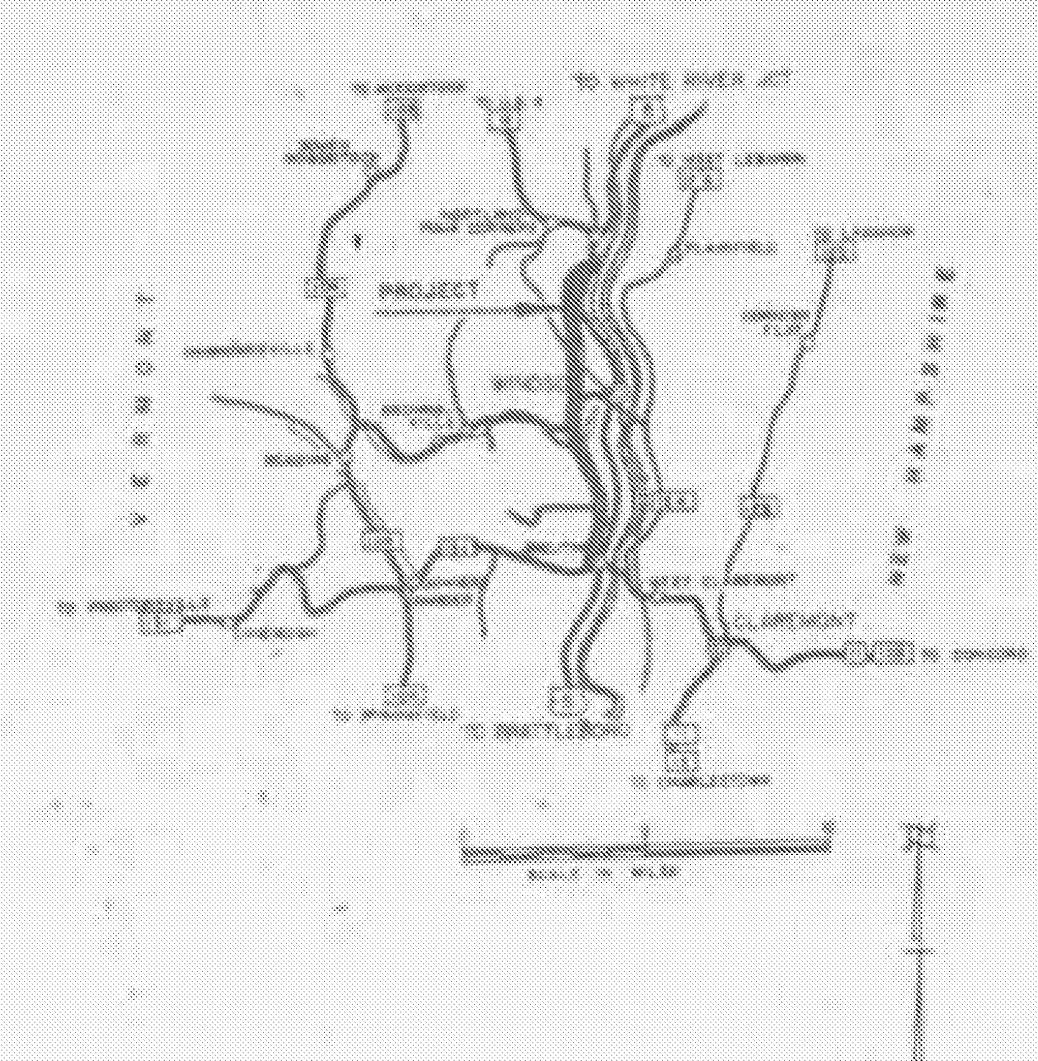

WINDSOR-HARTLAND
IM MEMB(14)

SHEET 24 OF 39
BRIDGE 35N&S
FOR REFERENCE ONLY

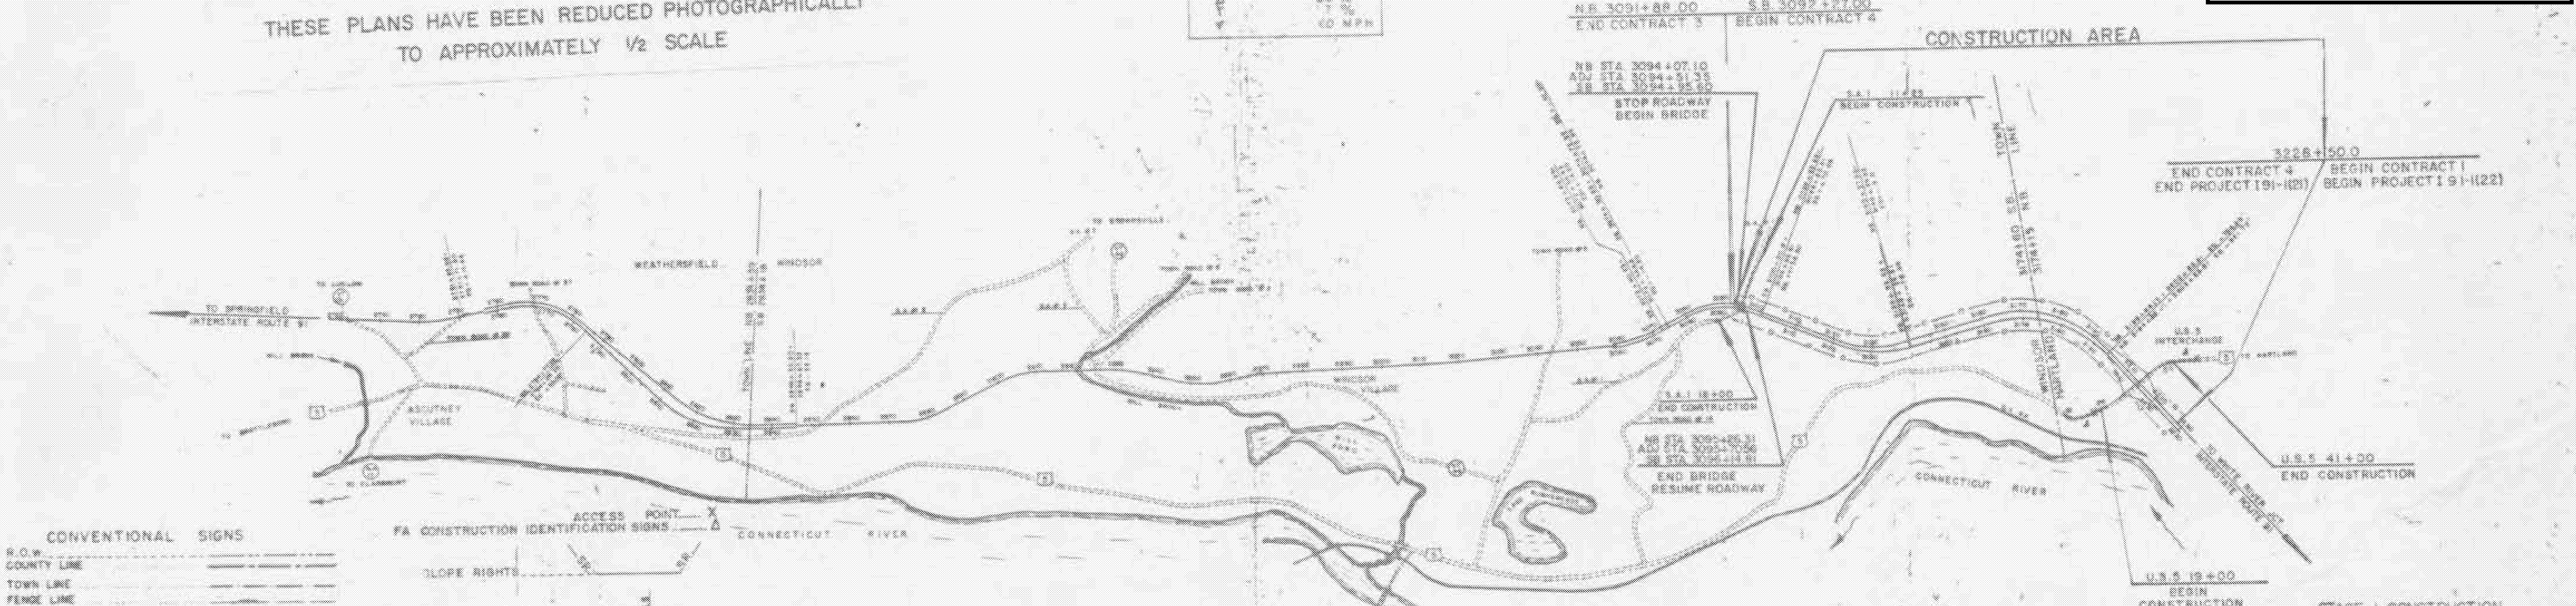

CONVENTIONAL SIGNS		FA CONSTRUCTION IDENTIFICATION SIGNS	
R.O.C. COUNTY LINE	---	GROUND ELEVATION	---
TOWN LINE	---	GRADE ELEVATION	---
FENCE LINE	---	CURVE DATA	---
STONE WALL	---	DEFLECTION OF ANGLE	A
UNFENCED PROPERTY	---	DEGREE OF CURVE	D
GUARD RAIL	---	RADIUS OF CURVE	A
TRAVELED WAY	---	TANGENT DISTANCE	T
RAILROAD	---	LENGTH OF CURVE	L
RETAINING WALL	---	EXTERNAL DISTANCE	S, E
CENTER LINE	---	POINT OF INTERSECTION	PI
SURVEY LINE	---	POINT OF CURVE	P.C.
CULVERT	---	POINT OF TANGENT	P.T.
DROP INLET	---	POINT ON TANGENT	P.O.T.
TROLLEY POLE	---	POINT ON SUBTANGENT	P.O.S.
POWER POLE	---		
TELEPHONE POLE	---		
TREES	---		
WEDGES	---		
LIMITED ACCESS	---		



THESE PLANS ARE SUBJECT TO SUCH REVISIONS AS MAY BE REQUIRED BY THE BUREAU OF PUBLIC ROADS OR THE COMMISSIONER OF HIGHWAYS.
CONSTRUCTION IS TO BE CARRIED ON IN ACCORDANCE WITH THE PLANS AND THE STANDARD SPECIFICATIONS FOR HIGHWAY AND BRIDGE CONSTRUCTION OF JANUARY 1956 SUBMITTED TO THE BUREAU OF PUBLIC ROADS AS APPROVED JULY 5, 1956, INCLUDING ALL SUBSEQUENT APPROVED REVISIONS AND SUCH REVISED SPECIFICATIONS, AND SPECIAL PROVISIONS AS ARE SUBMITTED WITH THE PLANS.

APPROVED DATE 12/11/62	APPROVED DATE 12/11/62	APPROVED DATE 12/11/62	APPROVED DATE 12/11/62	APPROVED DATE 12/11/62	APPROVED DATE 12/11/62	APPROVED DATE 12/11/62	APPROVED DATE 12/11/62
DEPARTMENT OF COMMERCE BUREAU OF PUBLIC ROADS							PROJECT I NO. 91-1(21)
STAGE I CONSTRUCTION CONTRACT # 4							SHEET 1 OF 28 SHEETS