


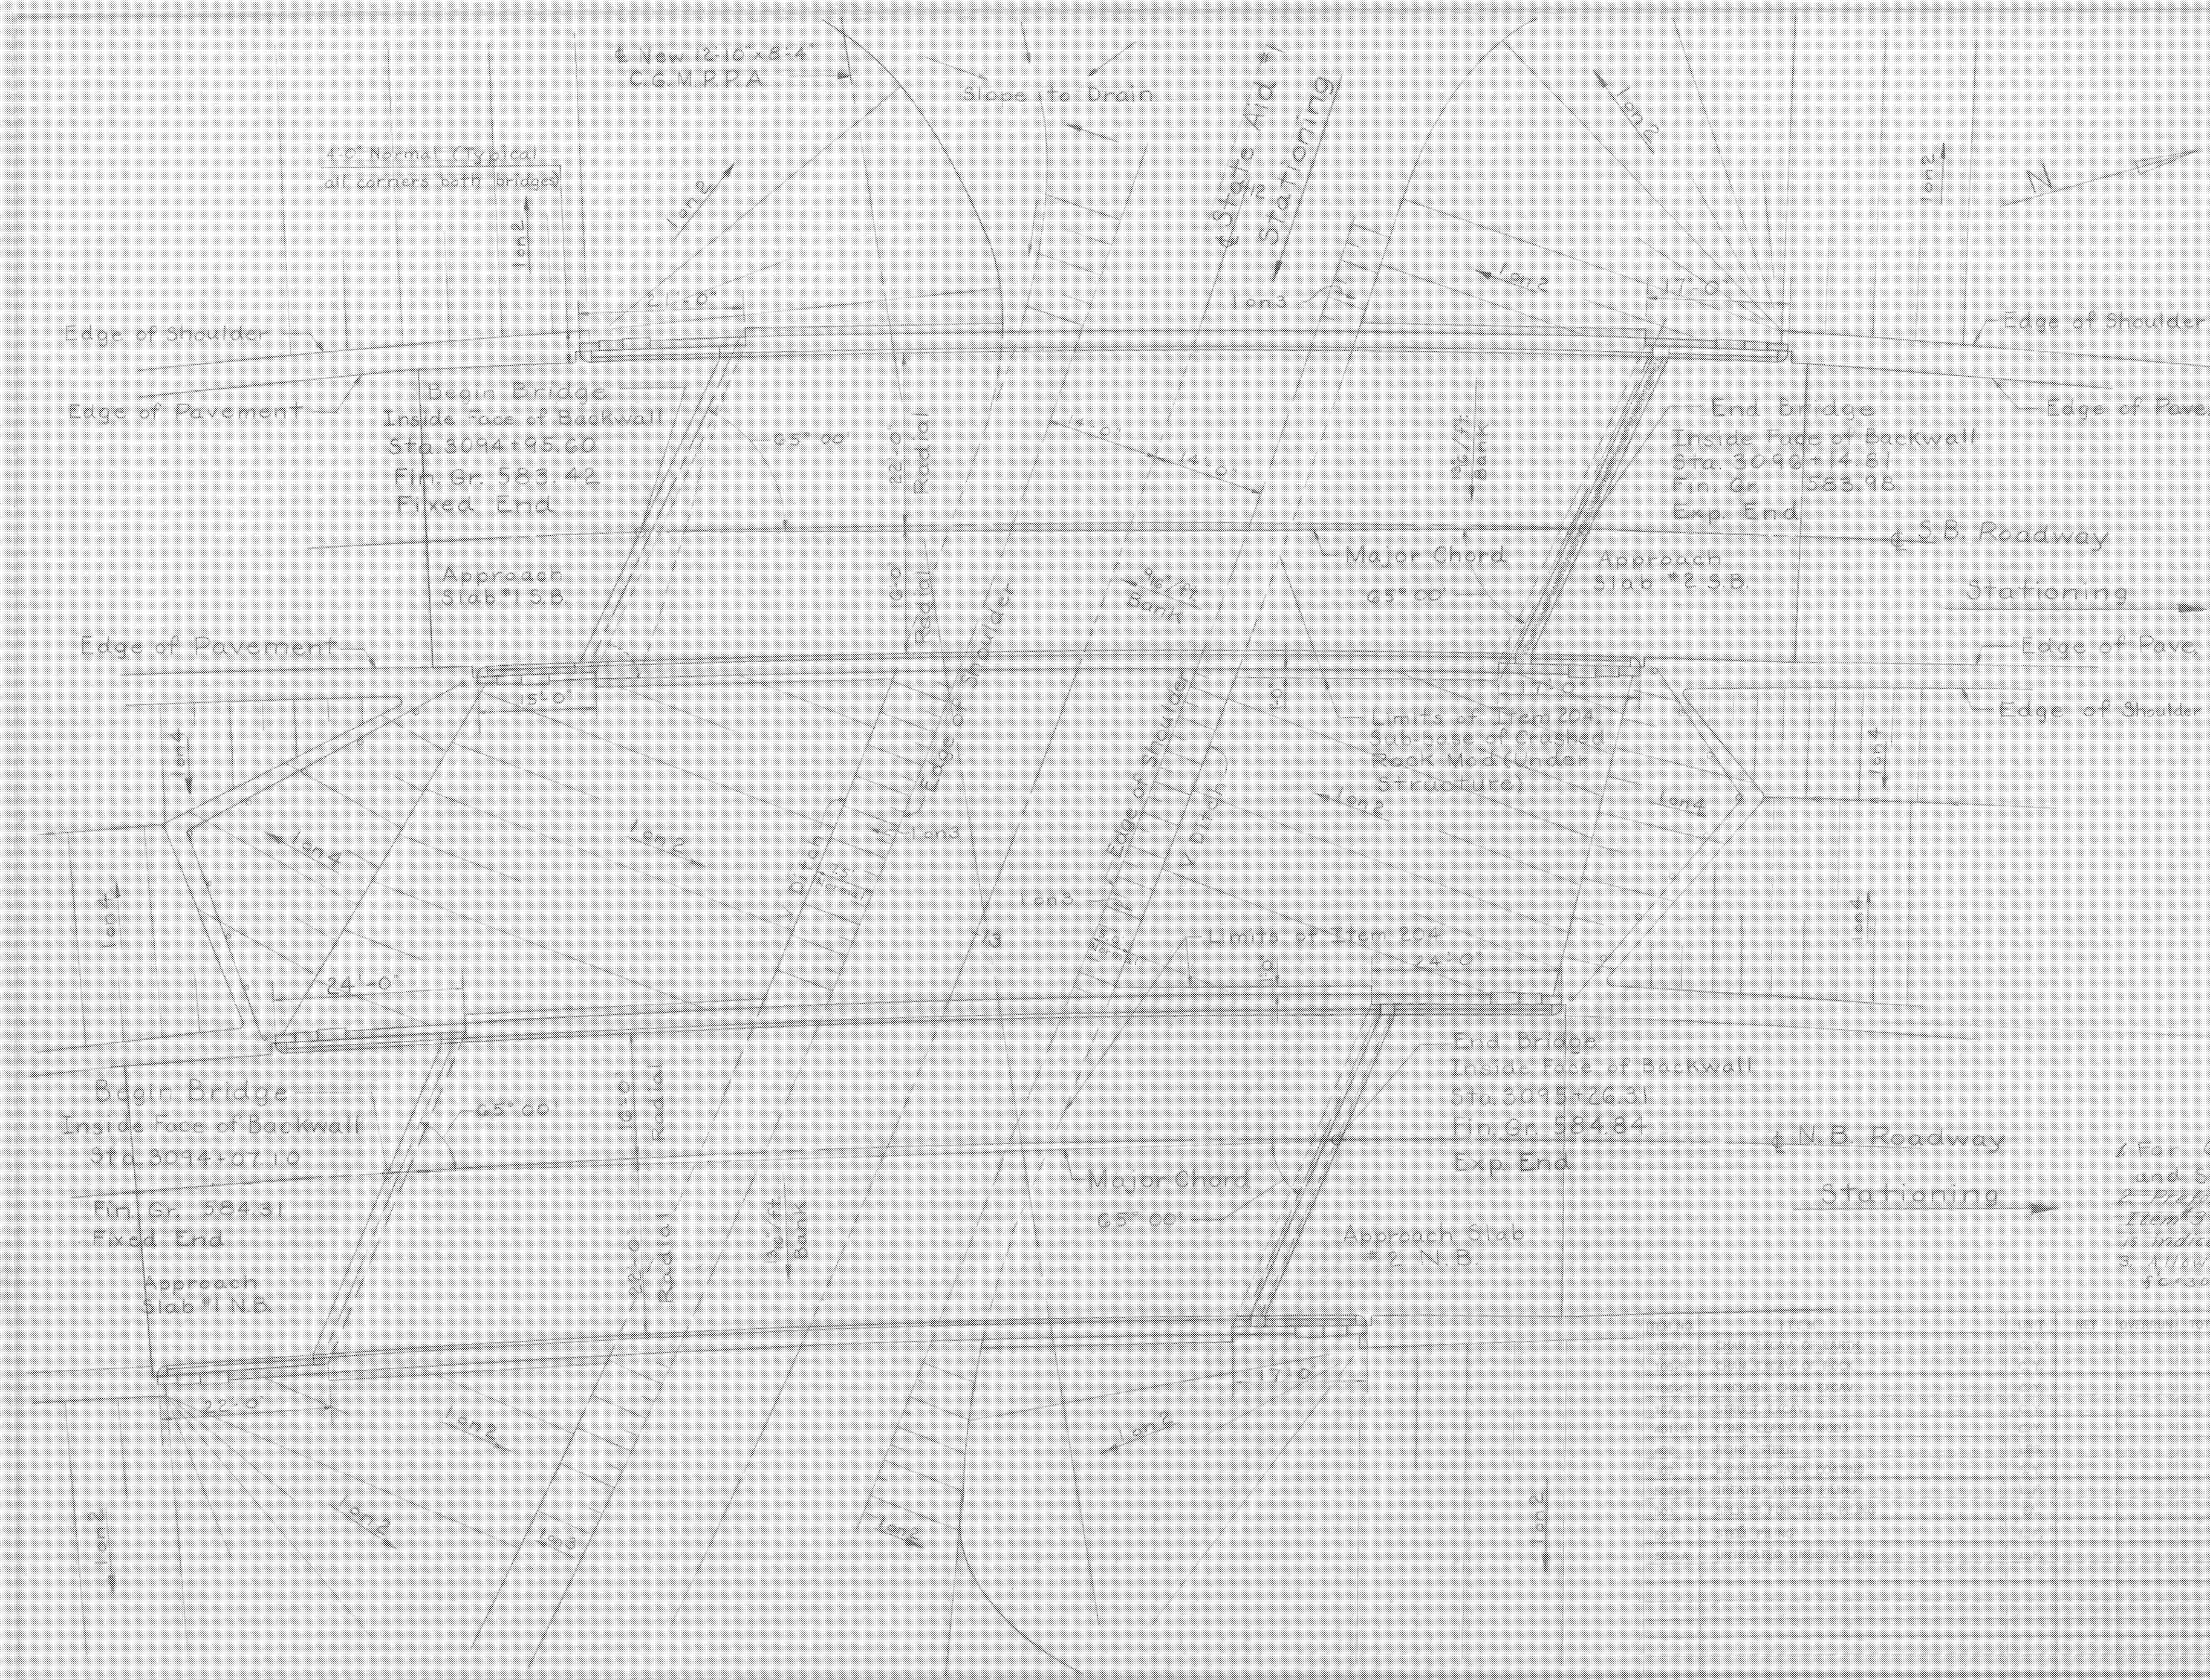

List of Bridge Sheets

- BR100 General Plan (Scale 1"=20')
- BR101 General Plan (Scale 1"=10')
- BR102 Bridge Quantity Sheet
- BR103 Preliminary Information Sheet
- BR104 Boring Logs
- BR105 Elev. & Curb and Railing Plan
- BR106 Framing Plan
- BR107 Typical Section
- BR108 Details of Abut. #1 S.B.
- BR109 Details of Abut. #2 S.B.
- BR110 Details of Abut. #1 N.B.
- BR111 Details of Abut. #2 N.B.
- BR112 SB-AS-G2 Approach Slab #1 S.B.
- BR113 SB-AS-G2 Approach Slab #2 S.B.
- BR114 SB-AS-G2 Approach Slab #1 N.B.
- BR115 SB-AS-G2 Approach Slab #2 N.B.
- BR116 C.G.M.P.P.A. 12'10" x 8'4" x 260'
- BR117-118 Reinforcing Steel Schedule
- BR119-121 Channel Cross Sections
- B.S. Std. Sh. SCWPG-30-G2, Sheets 1 thru 4
- B.S. Std. Sh. SCB-D1-G2, SCB-D2-G2, SCB-D6-G2
- B.S. Std. Sh. SB-5G-G2, sheets 1 and 2
- Ref. Plan (Scale 1"=50')
- Ref. Profile of Interstate NB&SB Sta. 3091+00 to Sta. 310+00
- Ref. Profile of State Aid #1
- Ref. Roadway Cross Sections, State Aid #1
- Ref. Roadway Cross Sections, Interstate Sta. 3093+00 to 3096+50

**WINDSOR-HARTLAND
IM MEMB(14)**

**SHEET 25 OF 39
BRIDGE 35N&S
FOR REFERENCE ONLY**

Notes

1. For General Notes see Std. Sh. SCB-D1-G2 and SCWPG-30-G2, sh. 1 of 4.
2. Preformed Neoprene Rubber Joint Material Item #372-C shall be used wherever Item 373 is indicated in the Standards.
3. Allowable Unit Stresses
 $f_c = 3000 \text{ psi}$ $f_s = 1200 \text{ psi}$ $f_t = 20,000 \text{ psi}$

ITEM NO.	ITEM	UNIT	NET	OVERRUN	TOTAL	FINAL
106-A	CHAN. EXCAV. OF EARTH	C.Y.				
106-B	CHAN. EXCAV. OF ROCK	C.Y.				
106-C	UNCLASS. CHAN. EXCAV.	C.Y.				
107	STRUCT. EXCAV.	C.Y.				
401-B	CONC. CLASS B (MOD.)	C.Y.				
402	REINF. STEEL	LBS.				
407	ASPHALTIC-ASR. COATING	S.Y.				
502-B	TREATED TIMBER PILING	L.F.				
503	SPLICES FOR STEEL PILING	EA.				
504	STEEL PILING	L.F.				
502-A	UNTREATED TIMBER PILING	L.F.				

STATE OF VERMONT DEPARTMENT OF HIGHWAYS

Weathersfield-
 TOWN OF Windsor-Hartland
 ROUTE NO. 191 LOG STA.
 General Plan 1"=10'
 Interstate over S.A. #1 & Brk.
 SCALE 1"=10'-0"
 SURVEYED BY Jewett
 DRAWN BY A.J.C. CHECKED BY J.J.C.
 PROJECT NO. I 91-182
 SHEET 65 OF 287
 BR-101 Sheet 124 of 188