

\* STANDARD STEEL BEAM GUARD RAIL  
w/ STEEL POSTS, ITEM 545-E  
NB 1697+56 - 1699+10 Rt.  
Ramp D 17+32 - 18+86 Lt.

\* TREATED TIMBER CURB, ITEM 558

\* LIGHT STEEL POSTS, ITEM 538

DI. FENCE TO BE ERECTED PRIOR  
TO CONSTRUCTION  
1700+10 - 1705+00 NB of  
1694+00 - 1700+62 SB Lt.

55 75 25  
36 42  
30  
Damp D 18+98 Lt - NB 1698+56 Rt.  
NB 1698+50 - 1698+62 Lt.  
TR 45 22+95 - 23+05 Lt.

TR 45  
7 26 7 90  
7 90 54  
22+64 - 23+12 Lt.  
22+68 - 23+16 Rt.

\* DENOTES STAGE 2 CONSTRUCTION

TR 45  
Δ 11° 20' Lt  
D 3°  
R 1909.86  
T 191.75  
L 382.22  
E 96'  
Bank 5/16" per ft.

Ramp D 25+61.6  
TR 29+00

END PROJECT T 49+11.15 (27)  
BEGIN PROJECT T 19+11.15 (22)

POT 27+91.15

POT 32+75.20

Ramp C PI.  
11+86.33 =  
11+84.73

TR 45 PI.  
25+01.65 =  
25+00.37

Ramp D PI.  
23+45.20 =  
23+79.73

NB 1699+66 - 1699+90 Rt.  
Special Ditch, Item 106


Ramp D 18+98 Lt - NB 1698+56 Rt.  
Special Ditch, Item 106-C

Ramp D 18+36 Rt - 18+98 Lt  
New 72" x 116" ACCOMP  
8 00 Strutt  
on 3' Ditch

Ramp D 18+35  
3.5X4.5 Stone Box Remove

STONE FILL FOR SLOPE PROTECTION  
ITEM 512  
TR 46 16+00 - 17+45 Rt.  
TR 46 17+35 - 17+60 Rt.  
TR 46 17+65 - 17+90 Rt.  
Ramp D 18+10 - 18+30 Rt.  
Ramp D 18+42 - 18+62 Lt.  
TR 46 19+85 - 20+10 Lt.  
NB 1698+30 - 1698+50 Lt.  
NB 1698+62 - 1698+82 Lt.  
TR 45 22+75 - 22+95 Lt.  
TR 45 23+05 - 23+25 Rt.

HARTFORD - SHARON  
IM 089-1(55)  
189 - BR. NO. 29-ID  
SHEET 19 of 20  
FOR REFERENCE ONLY

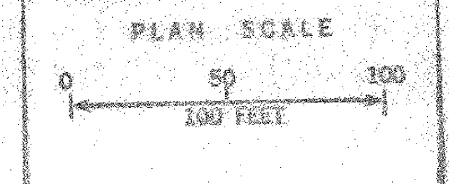

Stage II Construction

CONTROL OF ACCESS COMPLETE ON THIS SHEET

105  
81 132