


CURBED CENTER ISLAND
 GRANITE SLOPE EDGING, ITEM 556-A
 R.S.H. 134+71-136+53

JUTE MATTING, ITEM 623
 Ramp B 23+00-25+00 Rt.


* DENOTES STAGE 2 CONSTRUCTION.

R.S.H. 134+00 Lt. - 134+43 Lt.
 * R.S.H. 134+43 Lt. - Ramp D 15+00 Lt.
 TR 46 10+96 Rt. - R.S.H. 139+00 Lt.

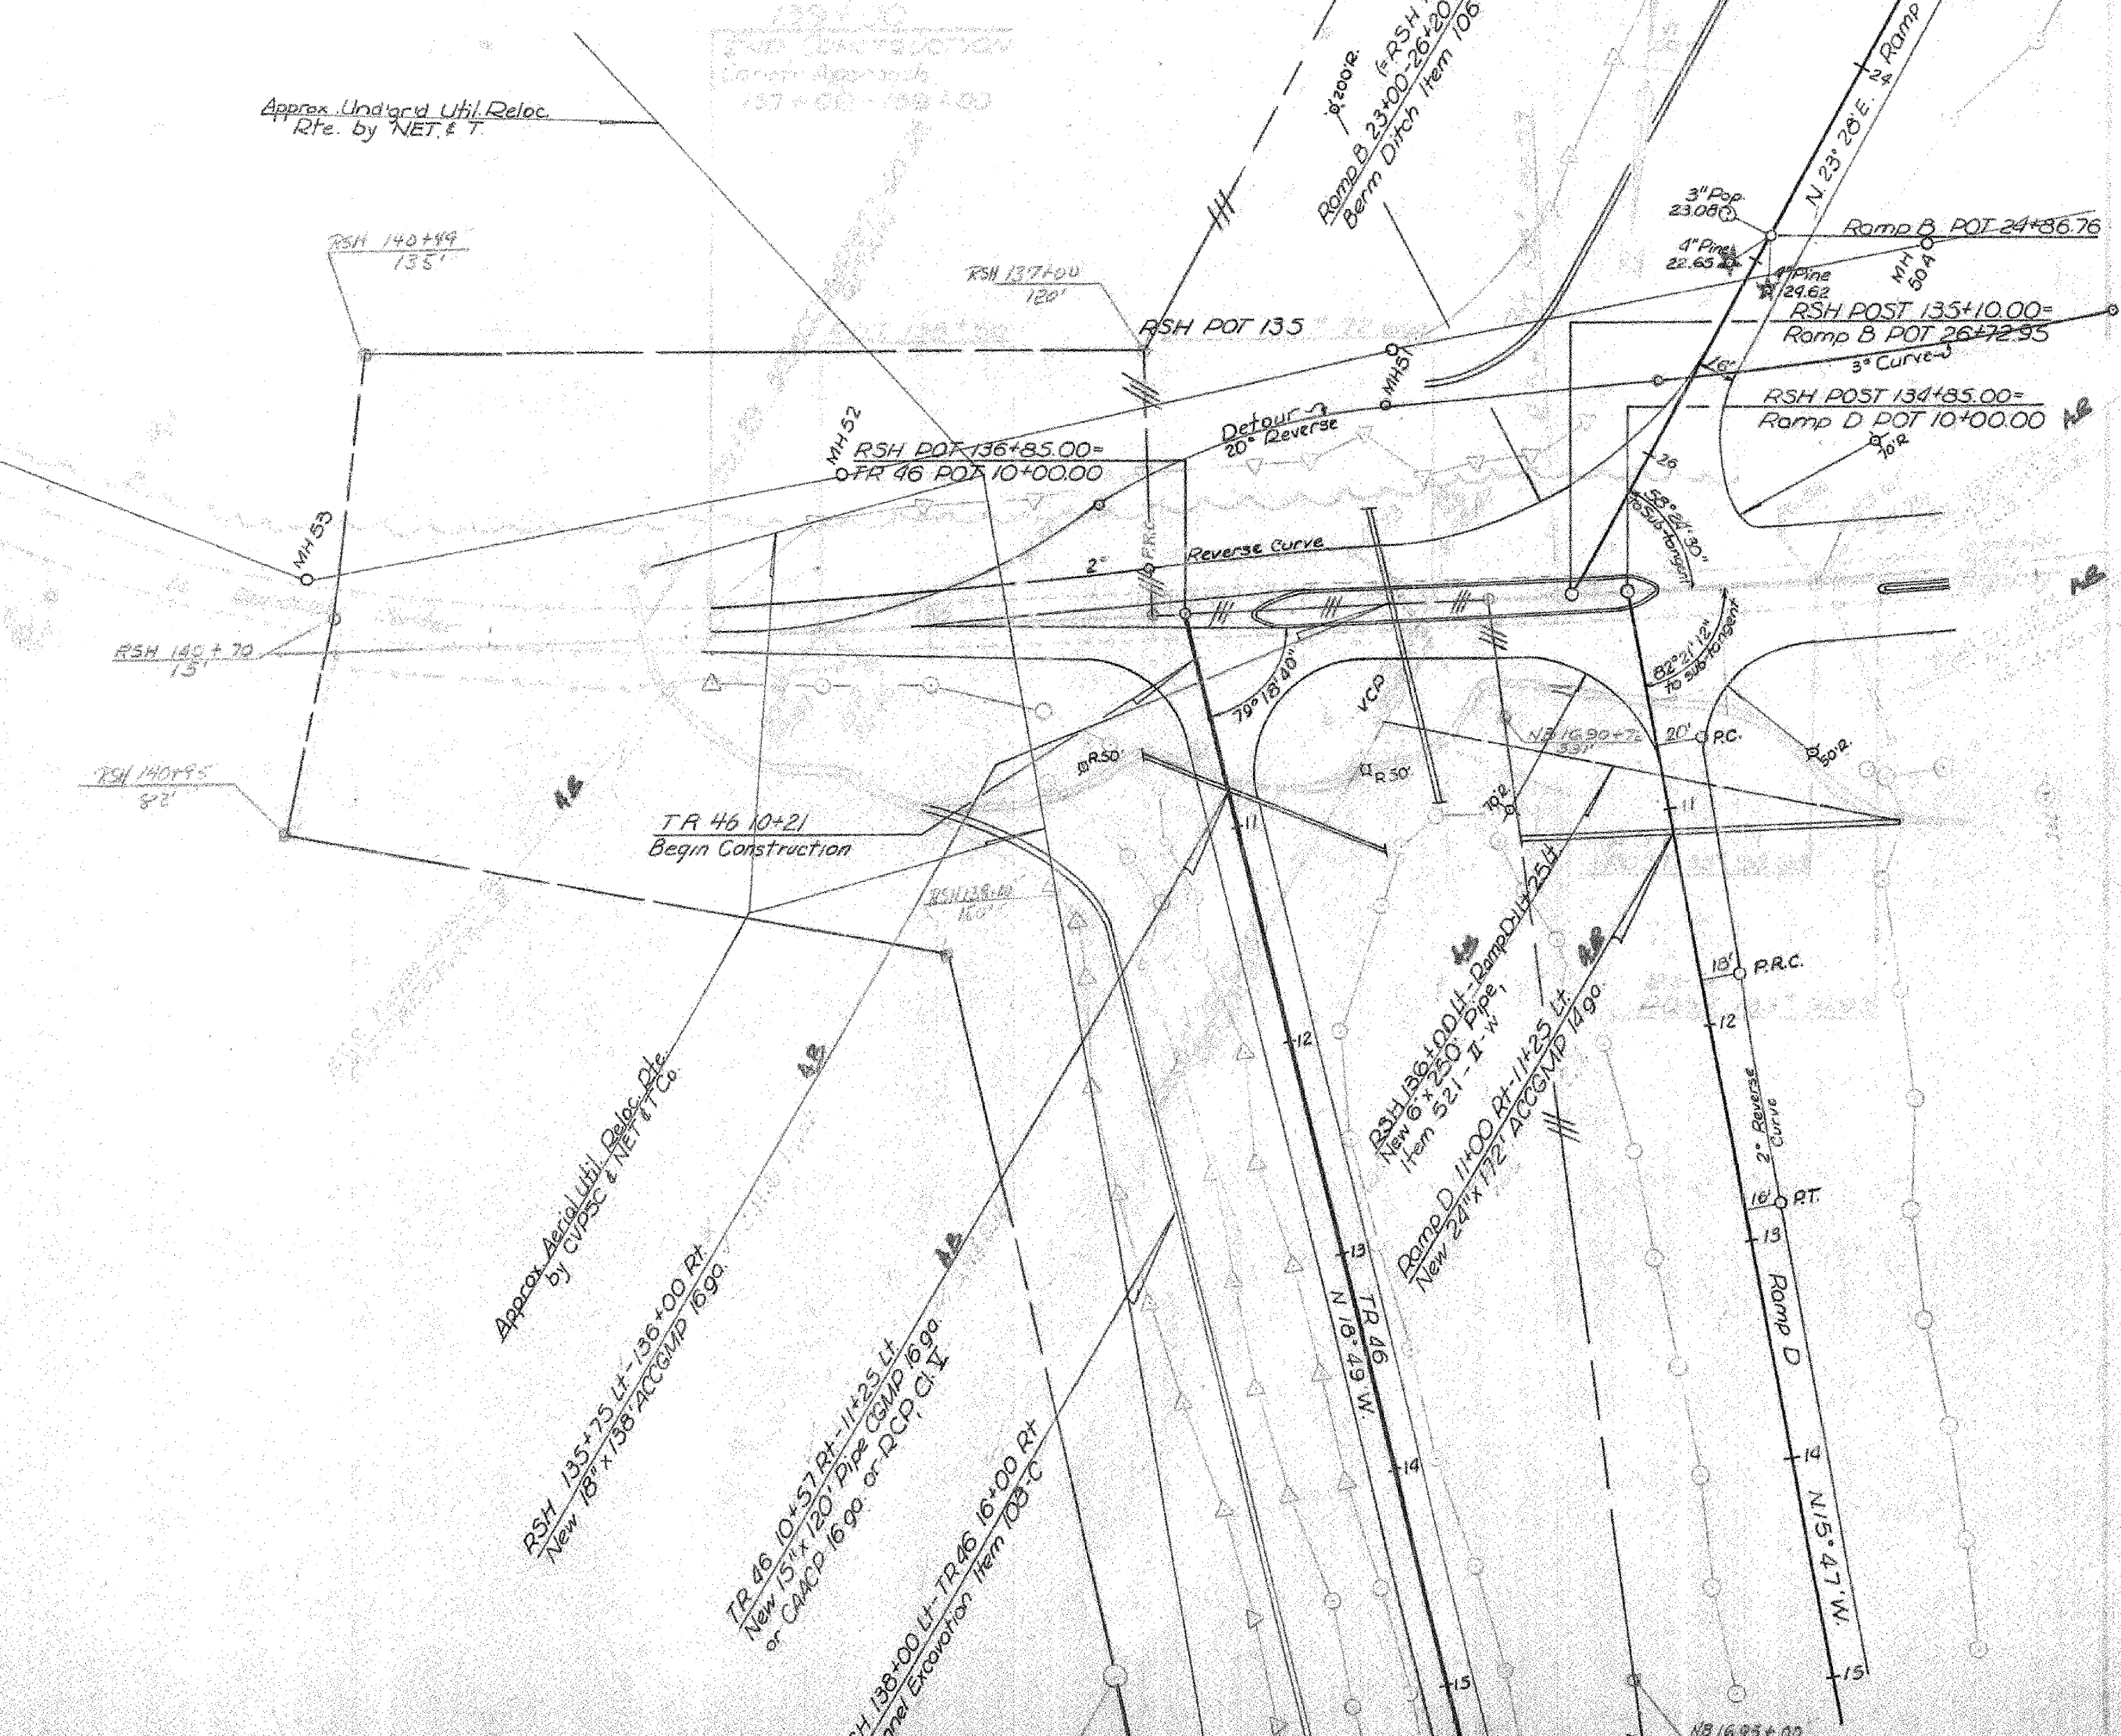

CONTROL OF ACCESS TO THE INTERSTATE
 IS COMPLETE ON THIS SHEET EXCEPT FOR
 ACCESS TO RAMP D & THE NORTH-BOUND
 LANE FROM THE RANDOLPH STATE HIGHWAY

HARTFORD - SHARON
 IM 089-K551
 189 - BR. NO. 29-ID
 SHEET 20 of 20
 FOR REFERENCE ONLY

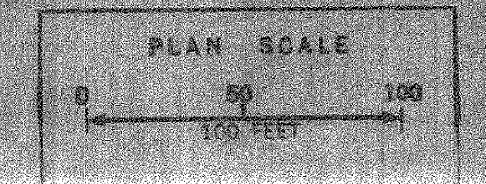

109
 78 152