


# PAVEMENT AND MARKING DETAIL

## INTERCHANGE #22

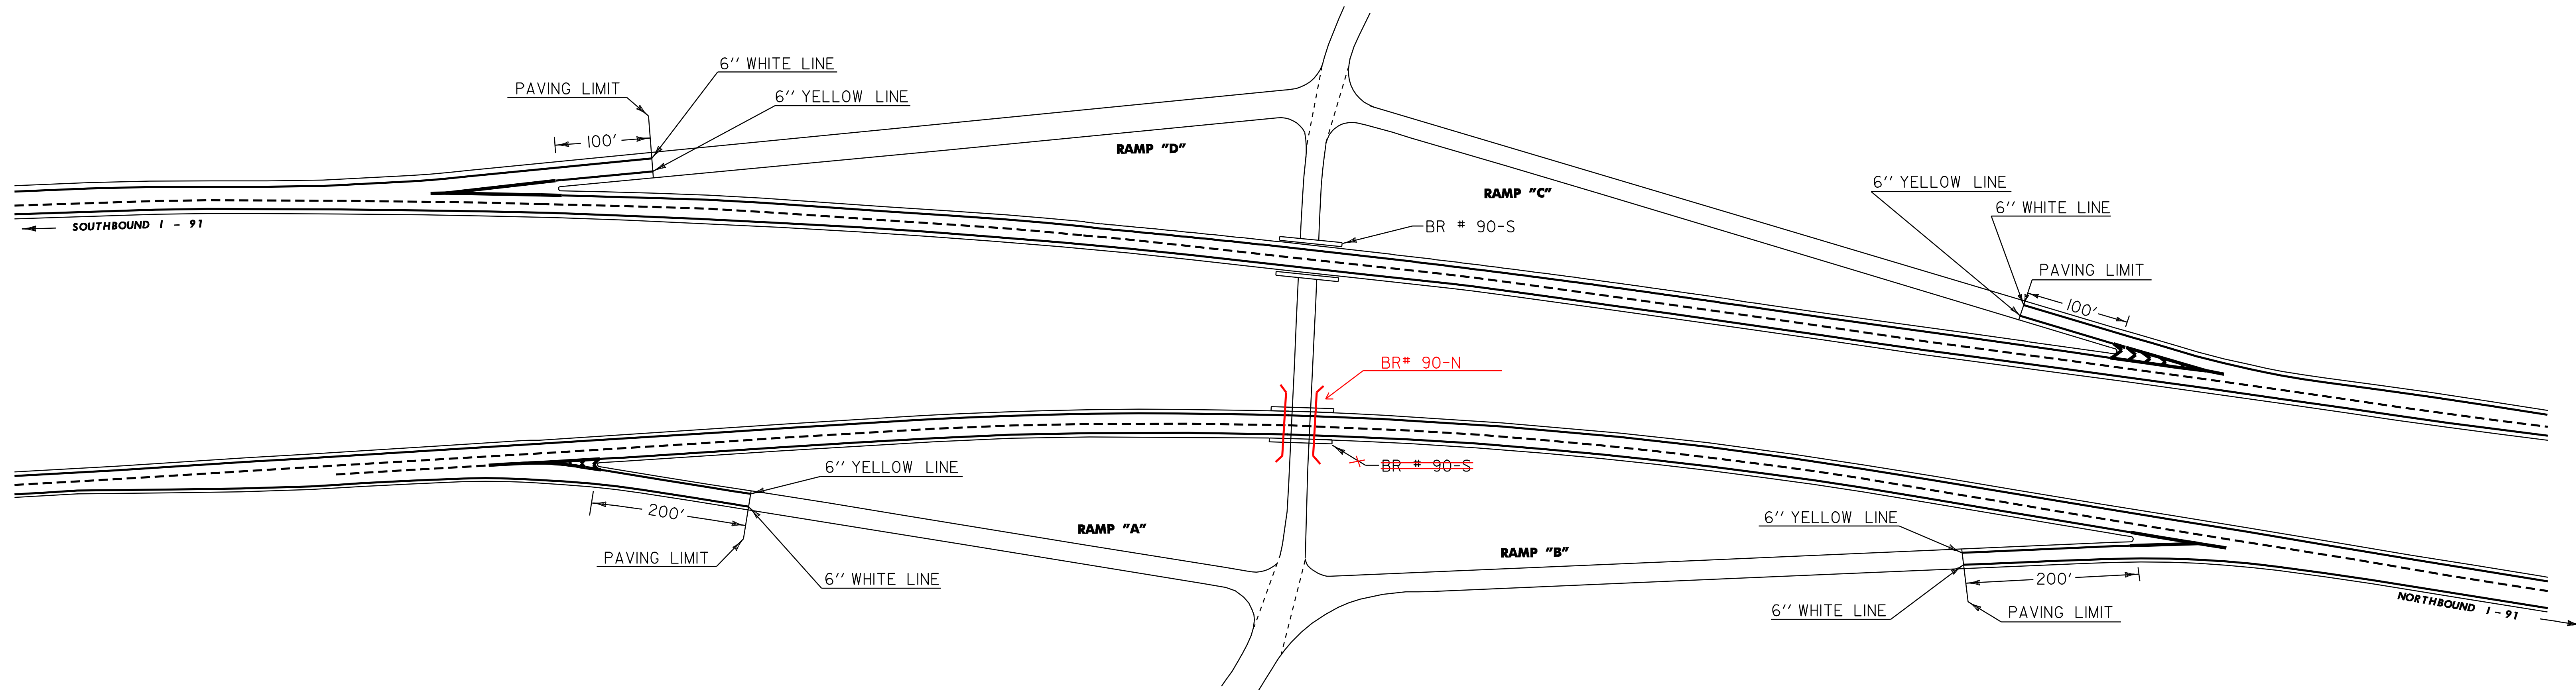

NOT TO SCALE

PROJECT:	WATERFORD - LYNDON	PROJECT NO.:	IM_SURE(14)
DESIGN FILE NAME:	p08al72.dgn	PLOT DATE:	18-MAR-2010 15:5
IPARM FILE NAME:	p08al72*9.1	SURVEY DATE:	N/A
SURVEYED BY:	NZA	DRAWN BY:	WILDER
SQUAD LEADER:	DOMEY	SHEET:	9 OF 17