


PAVEMENT AND MARKING DETAIL

INTERCHANGE #23

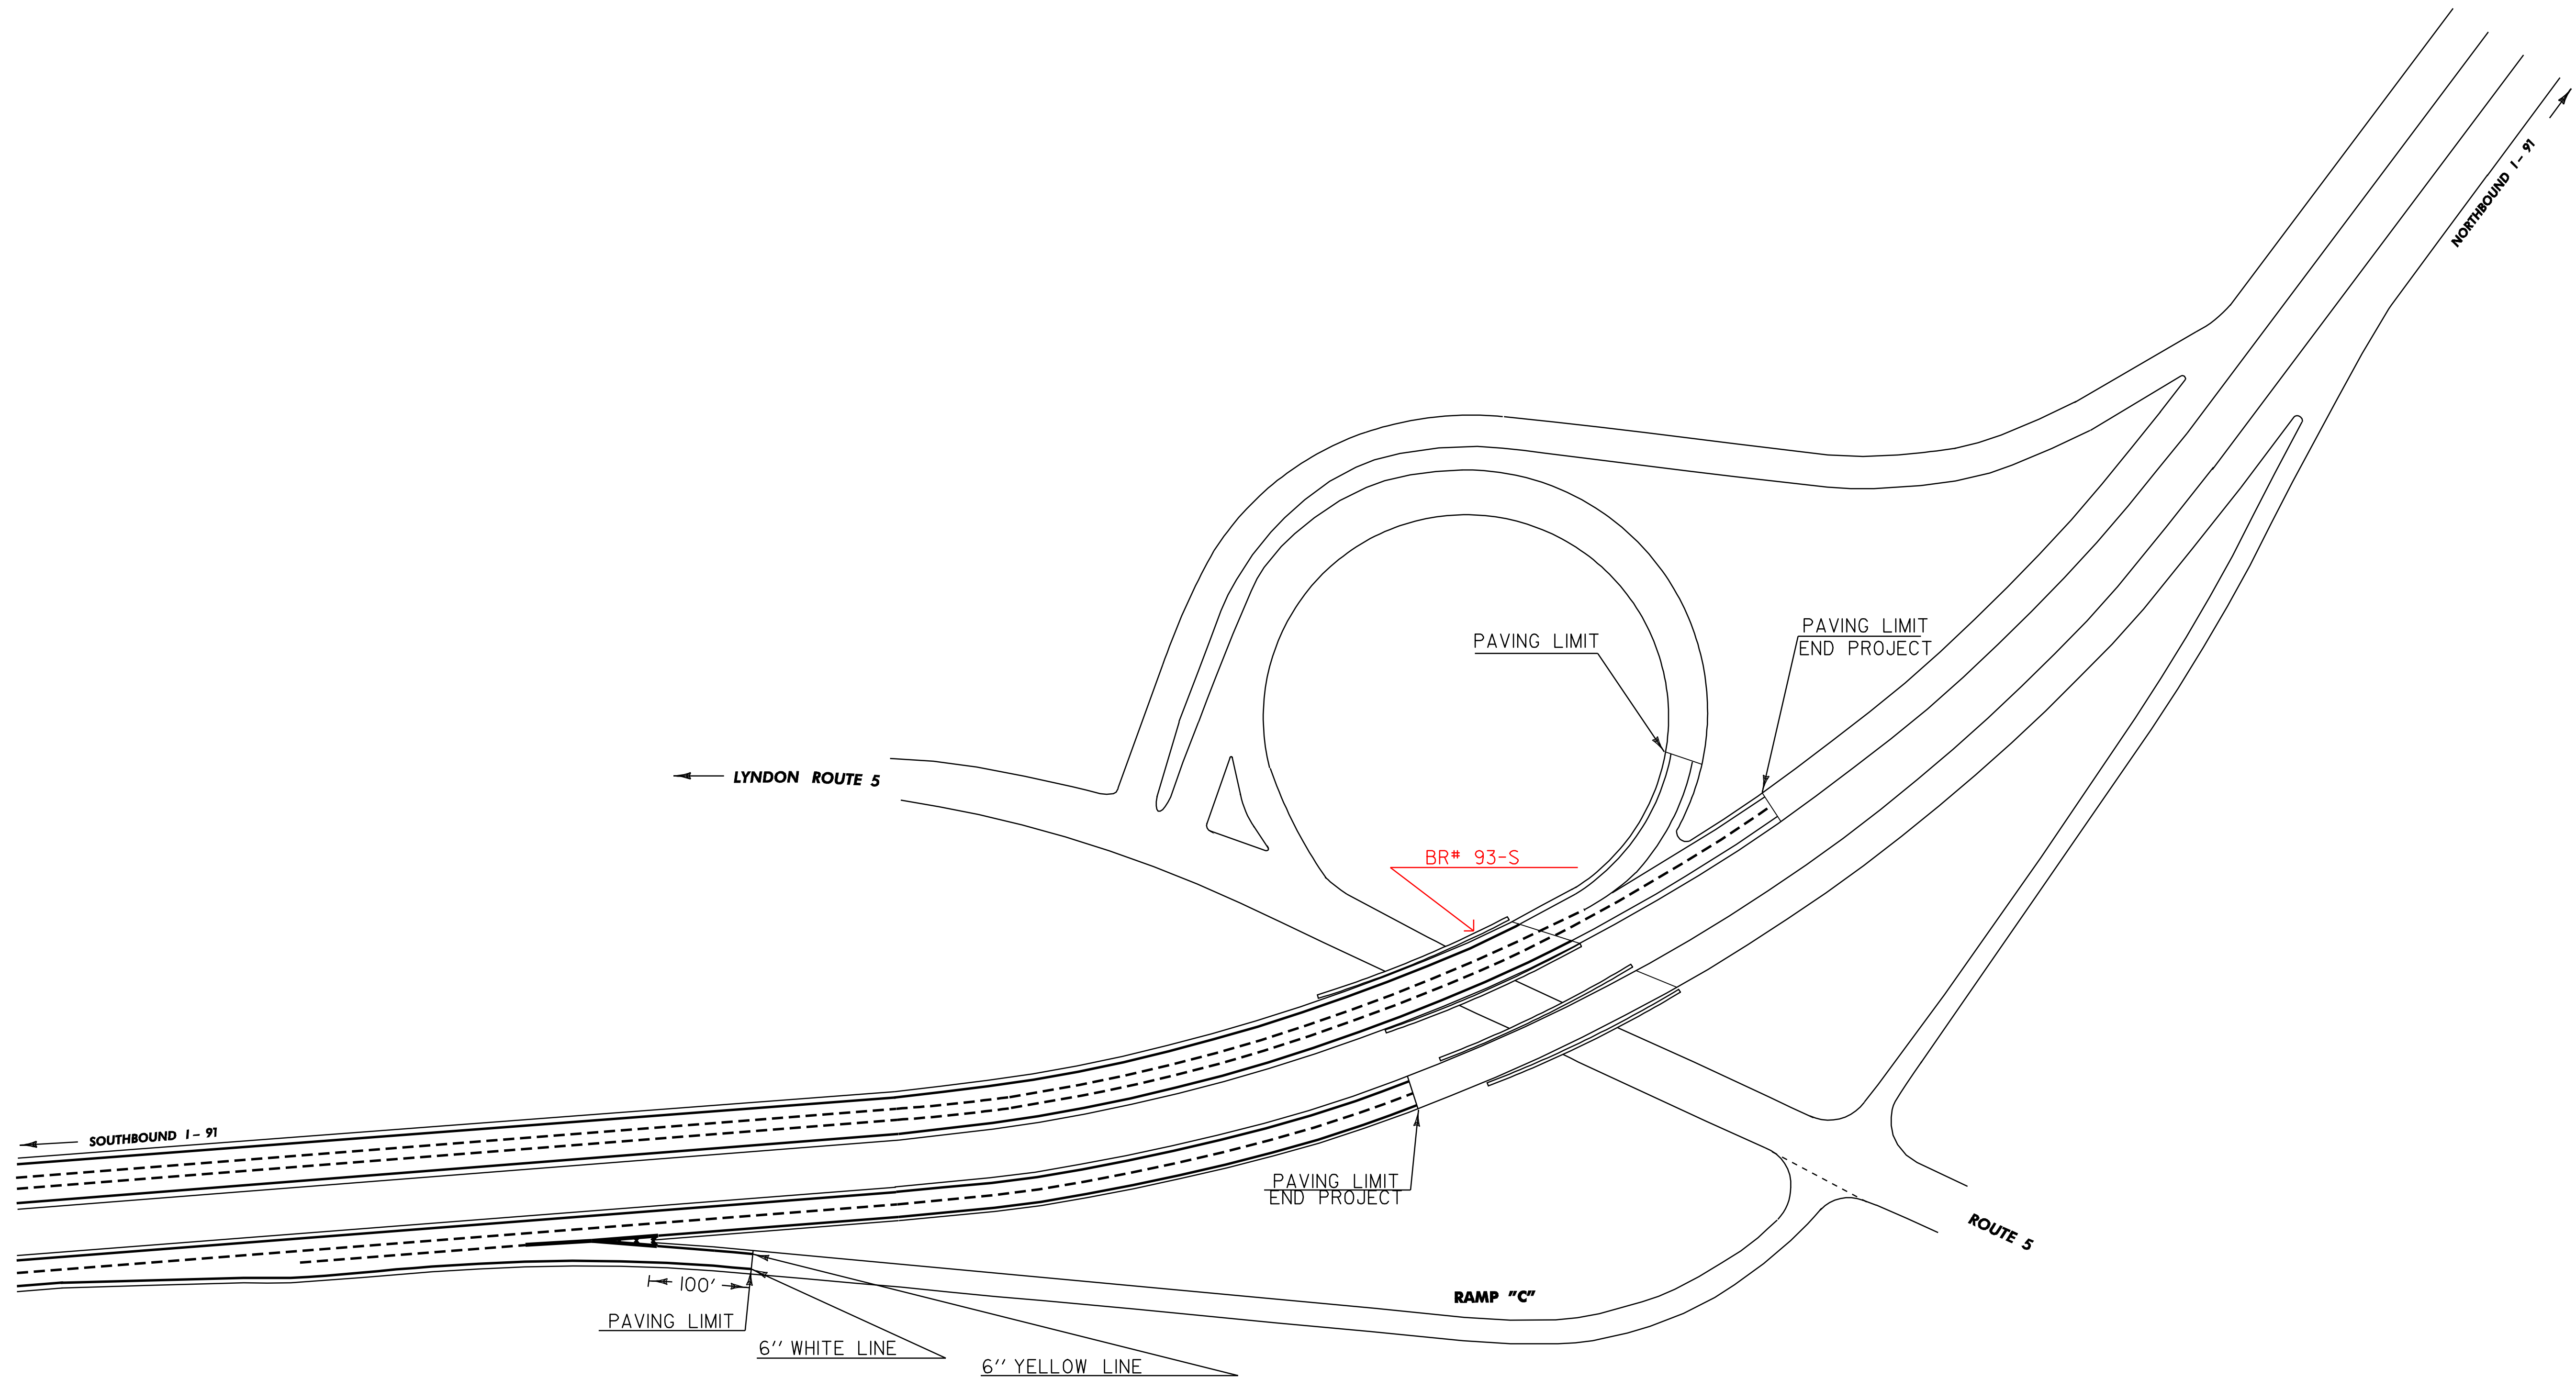

NOT TO SCALE

PROJECT:	WATERFORD - LYNDON	PROJECT NO.:	IM_SURE(14)
DESIGN FILE NAME:	p08dl72.dgn	PLOT DATE:	18-MAR-2010 15:5
IPARM FILE NAME:	p08dl72*10.1	SURVEY DATE:	N/A
SURVEYED BY:	N/A	DRAWN BY:	WILDER
SQUAD LEADER:	DOMEY	SHEET:	10 OF 17