


# I91 NB Waterford-St.J-Lyndon IM SURF(14) (2009)

Profiled 11/3/08,12/3/08

Travel Lane Avg. IRI = 70.0 Pass Lane Avg. IRI = 62.0

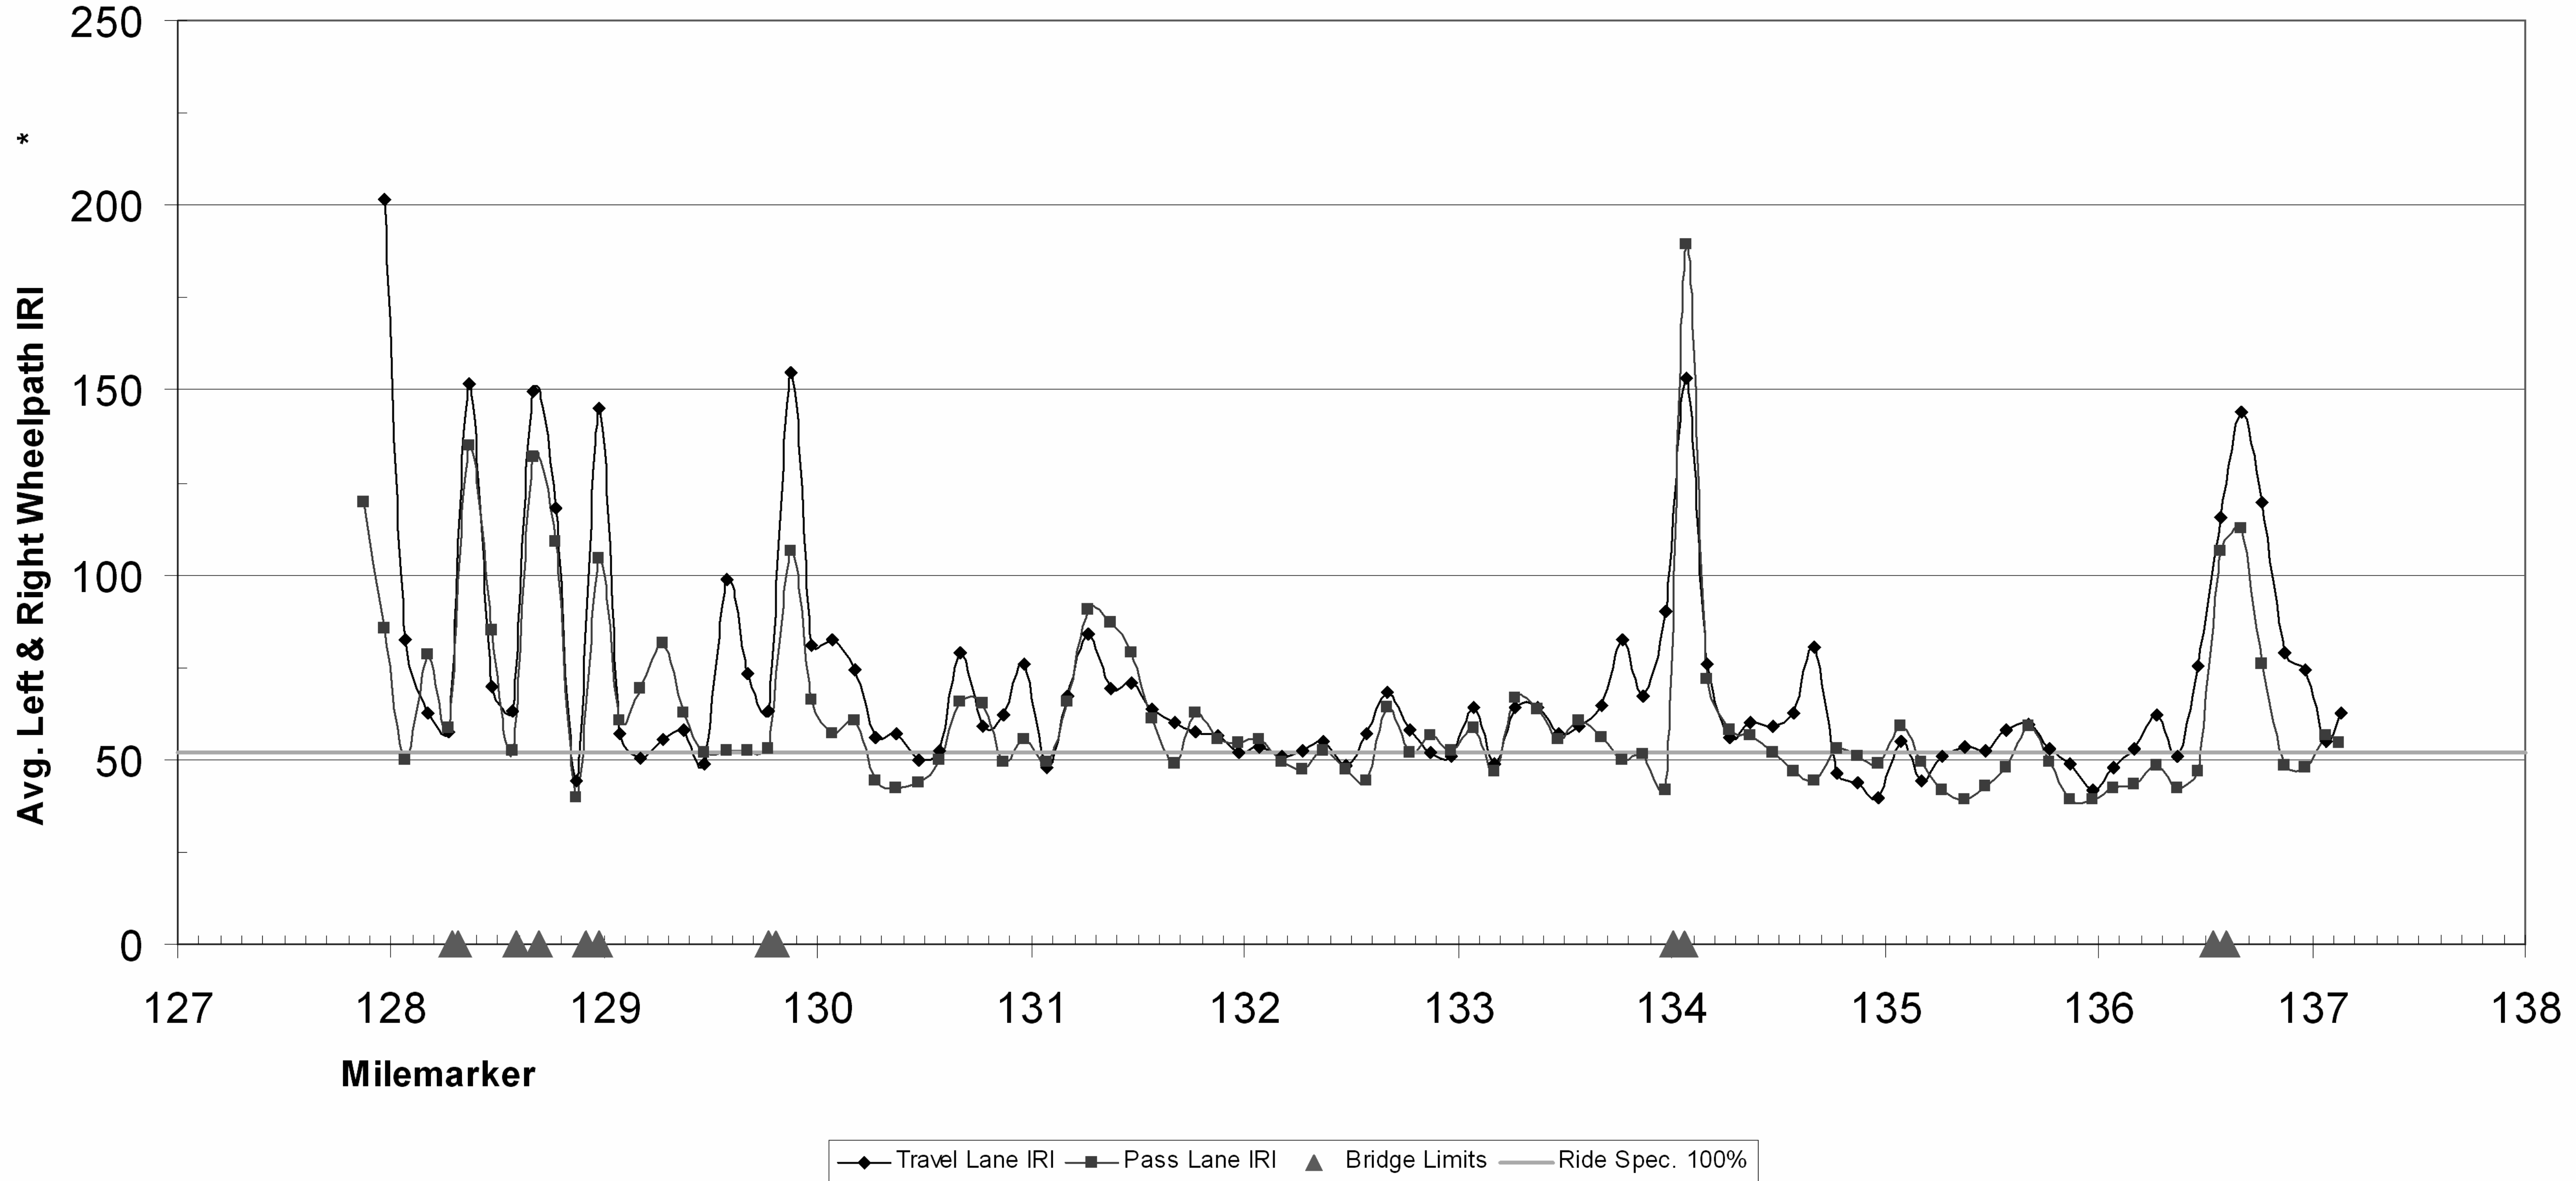

FOR INFORMATIONAL PURPOSES ONLY

## ROUGHNESS DATA INFORMATION NORTHBOUND

PROJECT NAME: WATERFORD - LYNDON  
PROJECT NUMBER: IM SURF (14)

FILE NAME: 08a172\p08a172.dgn  
PROJECT LEADER: DOMEY  
DESIGNED BY: WILDER  
IPARM FILE NAME: p08a172\*14.1

PLOT DATE: 18-MAR-2010 15:55  
DRAWN BY: WILDER  
CHECKED BY: PVMT MGMT  
SHEET 14 OF 17