


I91 SB Waterford-St.J-Lyndon IM SURF(14) (2009)

Profiled 11/3/08,12/3/08

Travel Lane Avg. IRI = 77.1 Pass Lane Avg. IRI = 73.9

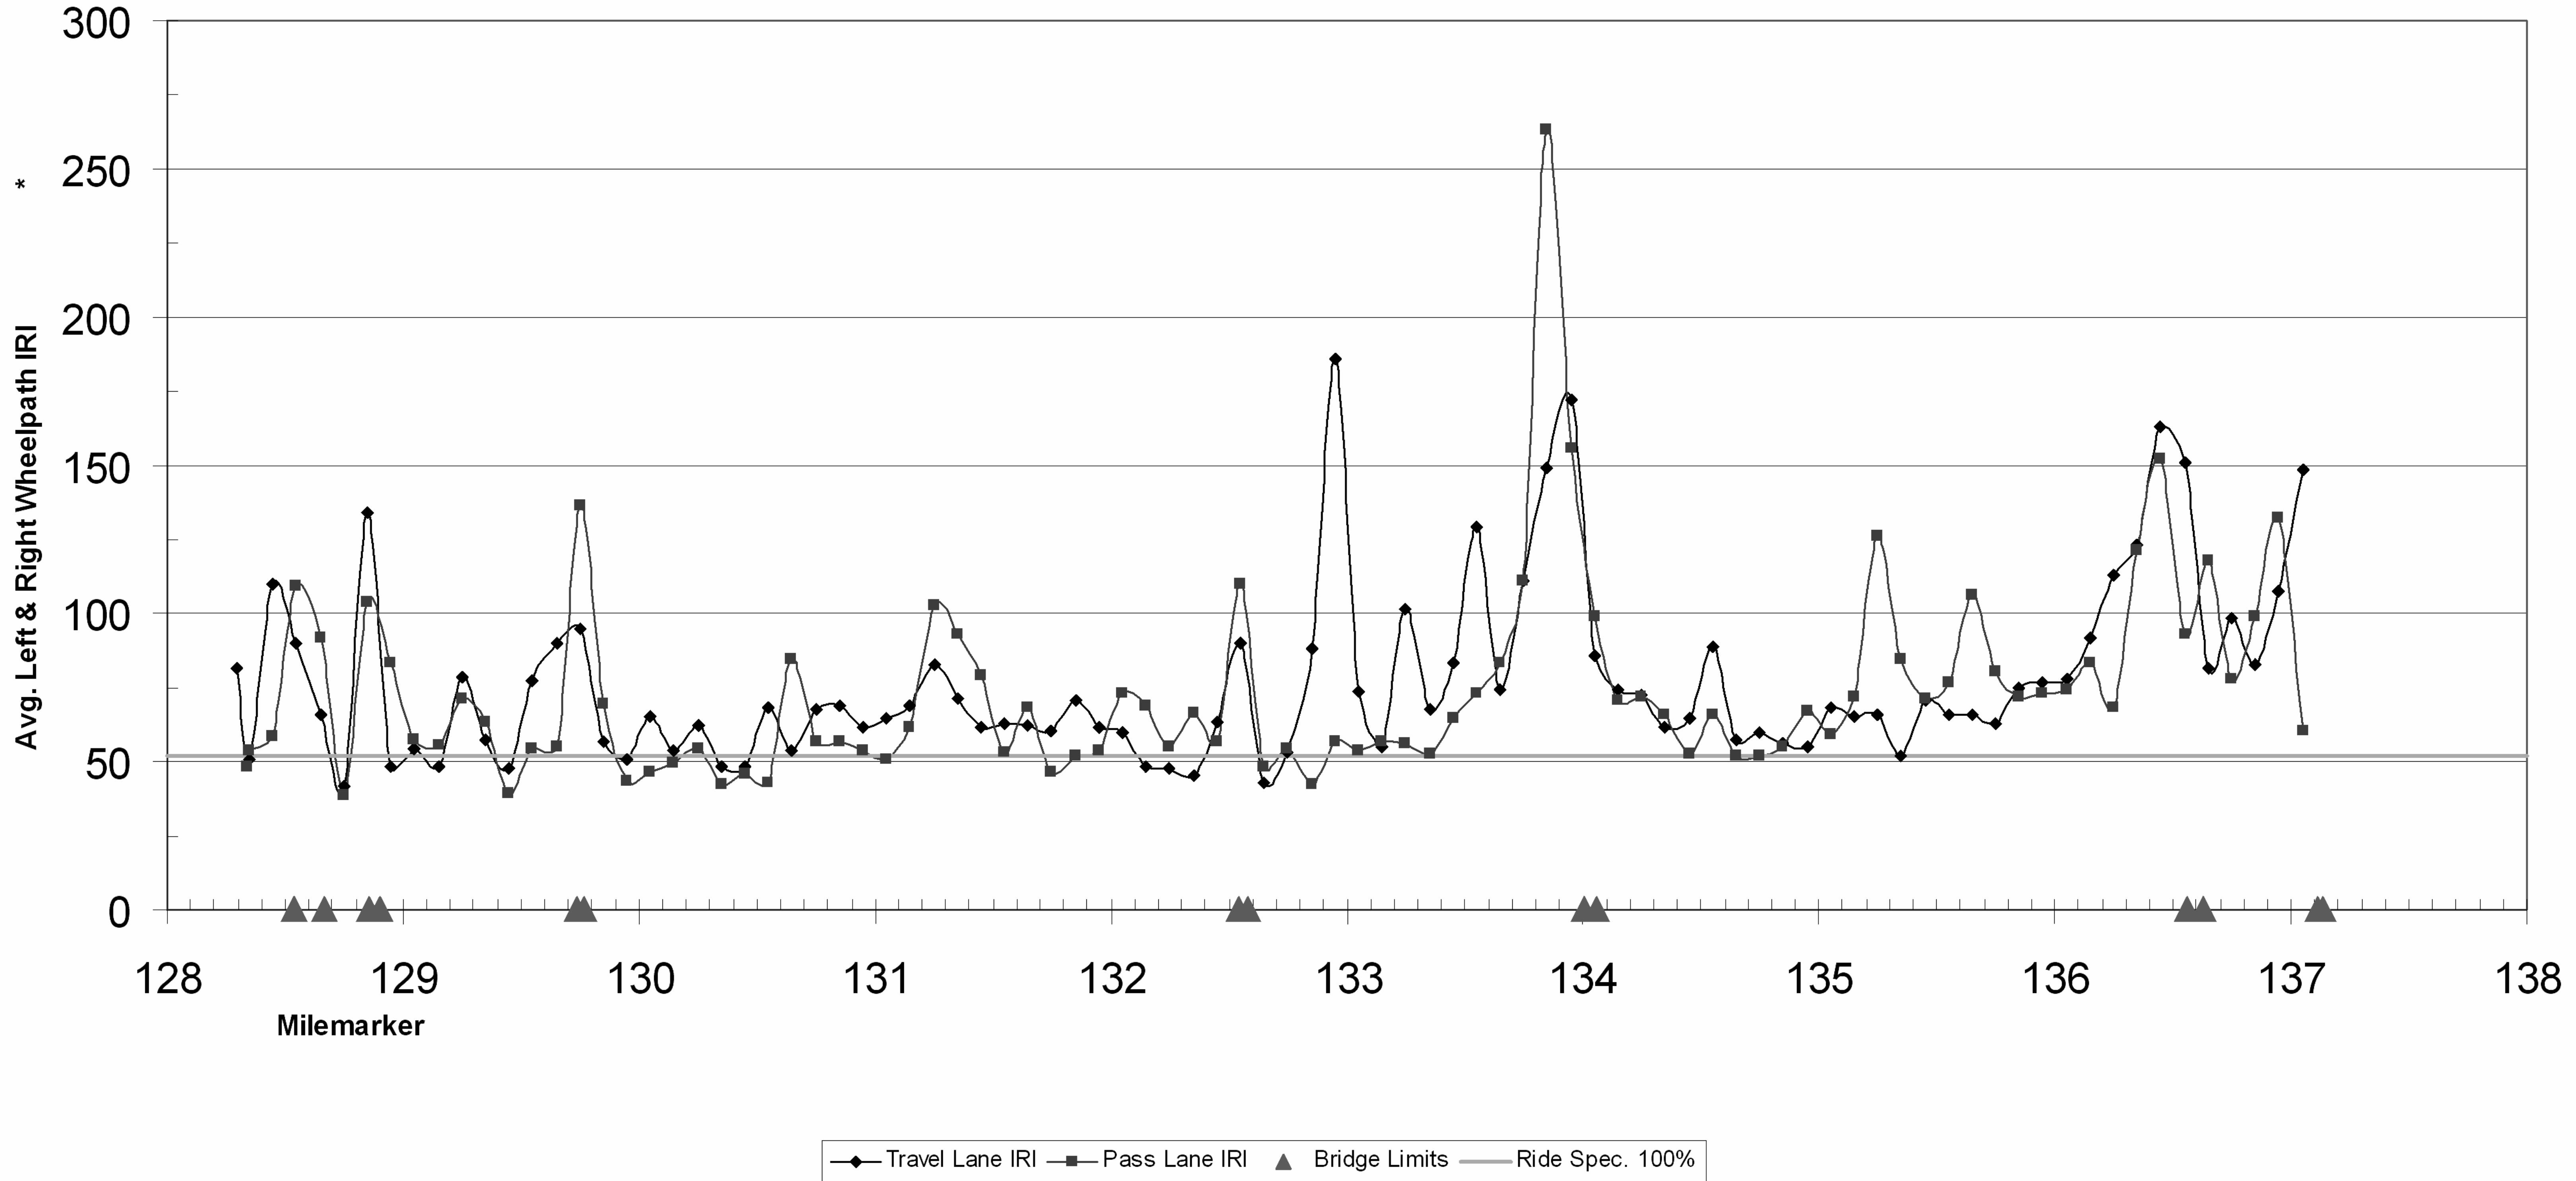

FOR INFORMATIONAL PURPOSES ONLY

ROUGHNESS DATA INFORMATION SOUTHBOUND

PROJECT NAME: WATERFORD - LYNDON
PROJECT NUMBER: IM SURF (14)

FILE NAME: 08a172\p08a172.dgn
PROJECT LEADER: DOMEY
DESIGNED BY: WILDER
IPARM FILE NAME: p08a172*16.i
PLOT DATE: 18-MAR-2010 15:55
DRAWN BY: WILDER
CHECKED BY: PVMT MGMT
SHEET 16 OF 17