


SEE SHEET 2 FOR INDEX OF SHEETS

# STATE OF VERMONT AGENCY OF TRANSPORTATION



## PROPOSED IMPROVEMENT BRIDGE PROJECT TOWNS OF WATERBURY AND MORETOWN COUNTY OF WASHINGTON BRIDGE MEMBRANE & JOINT PROJECT

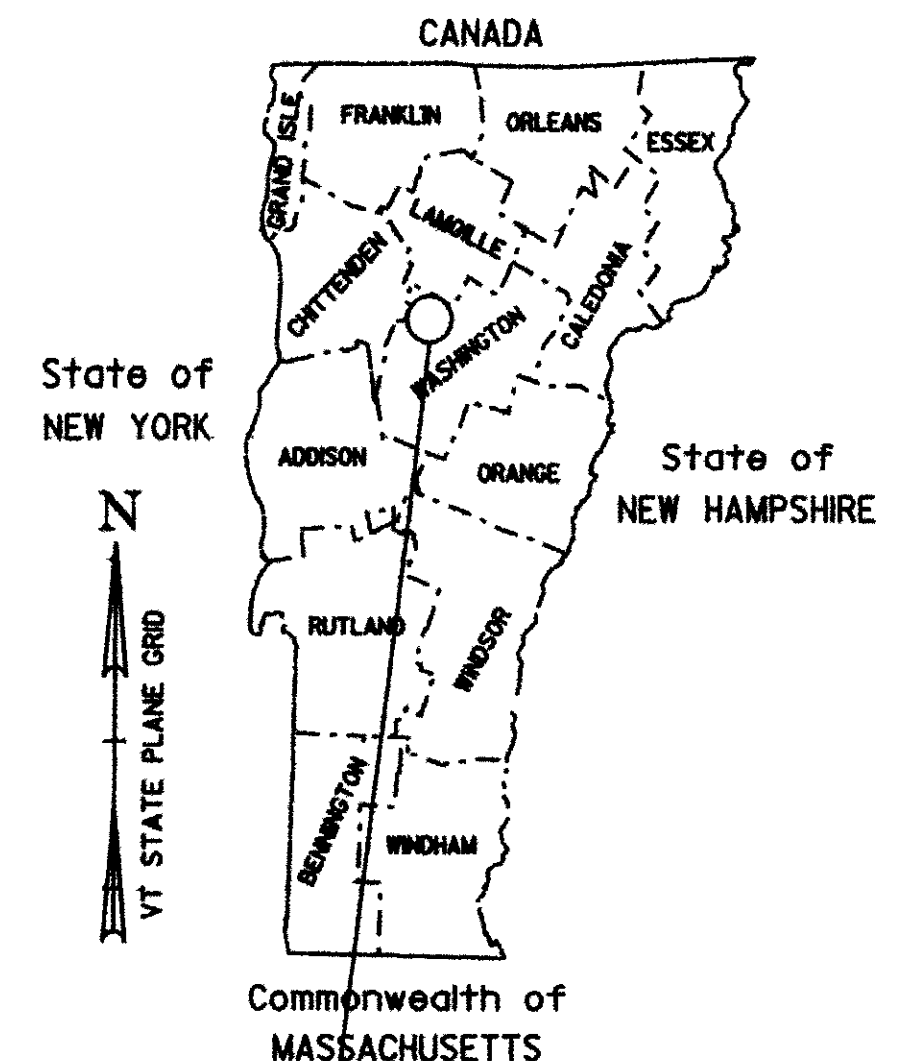


RECORD PLANS	
CONTRACTOR	A.C. PAVING CORP - SO BURLINGTON, VT
RESIDENT ENGINEER	TOM MANCINI
CONSTRUCTION BEGAN	MAY 27, 2009
CONSTRUCTION COMPLETE	JULY 20, 2009
RECORD PLANS BY	TOM MANCINI
I HEREBY CERTIFY THAT ALL THE CONSTRUCTION REQUIRED BY THIS SET OF DRAWINGS HAS BEEN ACCOMPLISHED AS INDICATED HEREIN	
BY	<i>Tom Mancini</i> RESIDENT ENGINEER
DATE	11/11
NOTE: Any further information concerning final quantities, amounts or other details relative to this project may be found at Central Files in the electronic archives	

PROJECT LOCATION: ROUTE US 2 BR 48 : 0.2 MILES WEST OF JUNCTION OF VT 100 AND US 2  
ROUTE VT 100B BR 4 : 1.6 MILES NORTH OF JUNCTION OF VT 100 AND VT 100B

PROJECT DESCRIPTION: COLD PLANING, MEMBRANE REPLACEMENT, JOINT REHABILITATION, AND PAVING OF BRIDGE AND APPROACH SLABS.

LENGTH OF STRUCTURES: ROUTE US 2 BR 48: 277.45'      ROUTE VT 100B BR 4: 198.41'

TOTAL LENGTH OF STRUCTURES: 475.86'

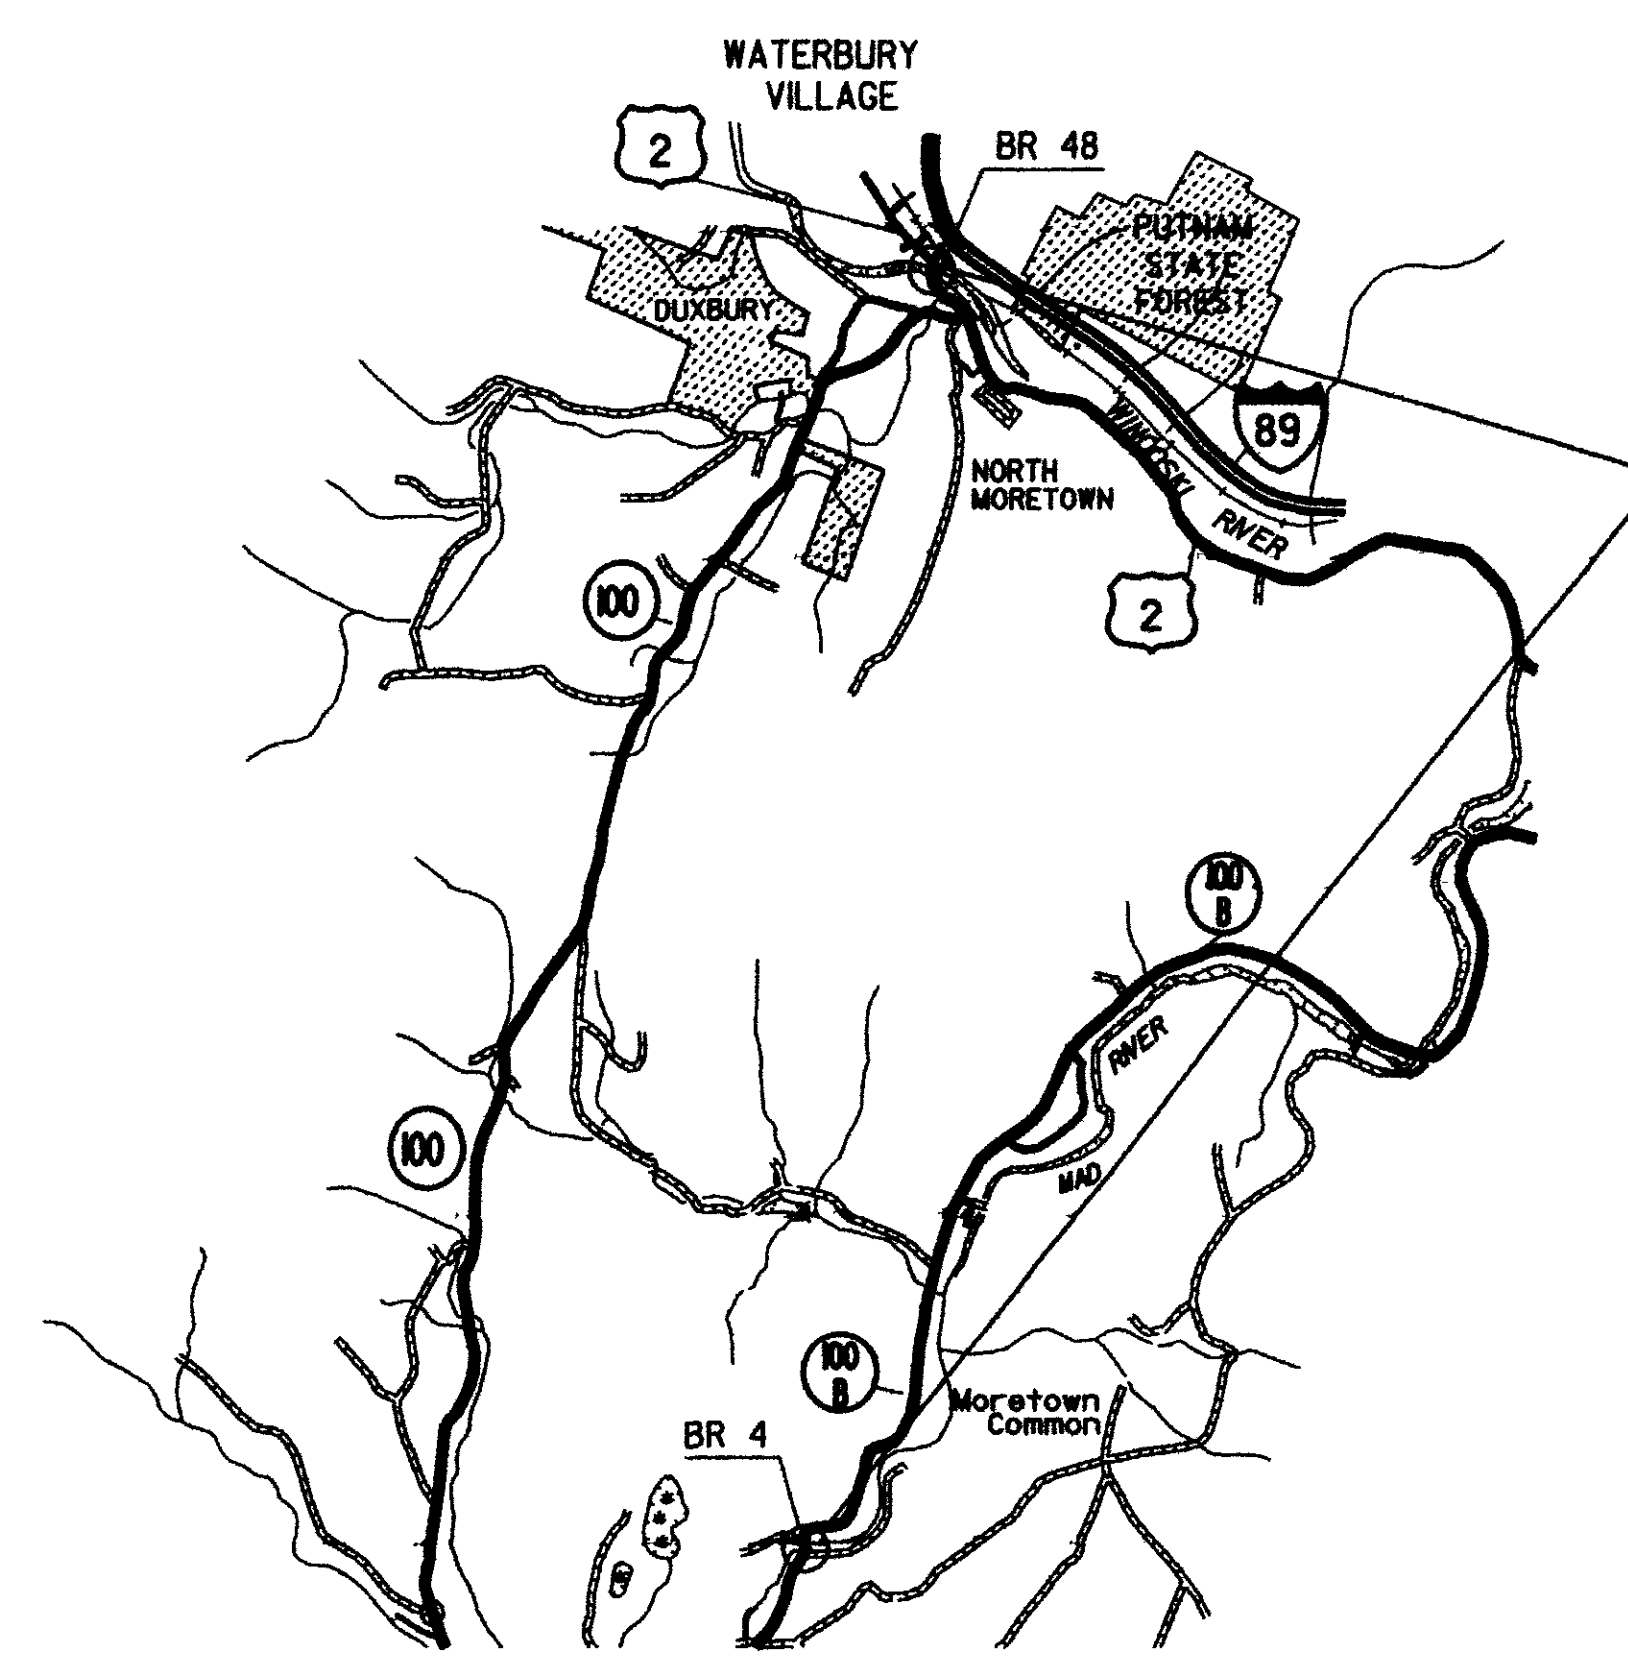

**PROJECT LOCATION  
WATERBURY-MORETOWN  
BHF MEMB(12)**

**BUILT AS DESIGNED**

CONVENTIONAL SYMBOLS	
COUNTY LINE	
TOWN LINE	
LIMITS OF ACCESS	
POINT OF ACCESS	
FENCE LINE	
STONE WALL	
TRAVELED WAY	
GUARD RAIL	
RAILROAD	
SURVEY LINE	
CULVERT	
POWER POLE	
TELEPHONE POLE	
TREES	
CONTROL OF ACCESS	
PROPERTY LINE	
R.O.W. TAKING LINE	
SLOPE RIGHTS	
TOP OF CUT	
TOE OF SLOPE	

SURVEYED BY :	N/A
SURVEYED DATE :	N/A
DATUM	
VERTICAL	N/A
HORIZONTAL	N/A



THESE PLANS ARE SUBJECT TO SUCH ENGINEERING CHANGES AS MAY BE REQUIRED BY THE FEDERAL HIGHWAY ADMINISTRATION OR THE DIRECTOR OF PROGRAM DEVELOPMENT.

CONSTRUCTION IS TO BE CARRIED ON IN ACCORDANCE WITH THESE PLANS AND THE STANDARD SPECIFICATIONS FOR CONSTRUCTION DATED 2006, AS APPROVED BY THE FEDERAL HIGHWAY ADMINISTRATION ON JUNE 15, 2006 FOR USE ON THIS PROJECT, INCLUDING ALL SUBSEQUENT REVISIONS AND SUCH REVISED SPECIFICATIONS AND SPECIAL PROVISIONS AS ARE INCORPORATED IN THESE PLANS.

PLOTTED 19-FEB-2009

DIRECTOR OF PROGRAM DEVELOPMENT	
APPROVED <i>[Signature]</i>	DATE <i>7/20/09</i>
PROJECT MANAGER : C.P. WILLIAMS	
PROJECT NAME : WATERBURY-MORETOWN	
PROJECT NUMBER : BHF MEMB (12)	
SHEET 1 OF 28 SHEETS	