

GENERAL NOTES
 1. ALL WORK AND MATERIALS SHALL CONFORM TO THE STATE OF VERMONT, DEPARTMENT OF HIGHWAYS, STANDARD SPECIFICATIONS FOR HIGHWAY AND BRIDGE CONSTRUCTION DATED APRIL 1934, AND THE A.A.S.H.O. SPECIFICATIONS DATED 1961. DESIGNED FOR HS20-44 LOADING.
 2. ALL REINFORCING STEEL SHALL BE DETAILED ON THE REINFORCING STEEL SCHEDULE. ALL SPLICES SHALL BE A MINIMUM OF 40 BAR DIAMETERS.

RICHMOND-HIGHGATE
 IM MEMB(13)
 SHEET 15 OF 29
 BRIDGE 86N
 FOR REFERENCE ONLY

SUMMARY OF QUANTITIES


ITEM NO.	ITEM	UNIT	TOTAL	FINAL
319	TAR EMULSION FOR BRIDGE FLOORS	GAL.		
361-B	BITUMINOUS CONCRETE PAVEMENT	TONS		
372-A	JOINT SEALER - HOT Poured	L.F.		
372-C	JOINT SEALER - PREFORMED, TYPE A	L.F.		
401-B	CONCRETE CLASS B	CY.		
402	REINFORCING STEEL	LB.		

REINFORCING BENDING DETAILS

REINFORCING STEEL

BAR NO.	NO. PIECES	LENGTH	WEIGHT PER FT.	WEIGHT IN LBS.
AS 1	SEE SCHEDULE		4.303	
AS 2	SEE SCHEDULE		4.303	
AS 3	SEE SCHEDULE		10.43	
AS 4	SEE SCHEDULE		10.43	

TOTAL WEIGHT

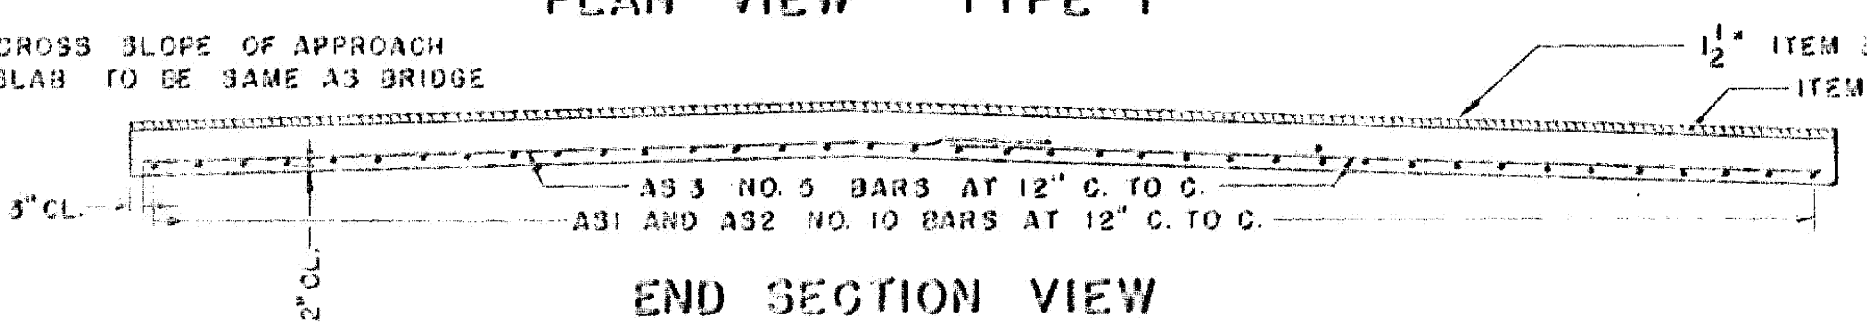

REVISIONS AND CORRECTIONS
 1. DIMENSIONS OF JOINT FOR SEALER TYPE A REVISED, 1/15/63 W.B.T.
 2. DIMENSIONS OF JOINT SEALER TYPE B REVISED AND MODIFICATION OF ITEM 372-C ADDED, 3/23/66 W.B.T.

DRAWN BY: W.B.T. Jan. 1963
 TRACED BY: W.B.T. Jan. 1965
 CHECKED BY: W.M.S. Feb. 1965
 RECOMMENDED FOR APPROVAL: [Signature] 2/4/65
 RECOMMENDED FOR APPROVAL: [Signature] 2/4/65
 APPROVED BY: [Signature] 2/4/65

DETAILS OF APPROACH SLAB #3 N.B.
 FOR 30.00 FOOT BRIDGE
 TO BE USED FOR BRIDGE AT STATION 3092±
 LOCATION I89 over C.V.R.R.

STATE OF VERMONT
 DEPARTMENT OF HIGHWAYS
 STANDARD STRUCTURE
 SB-AS-65

TOWN OF Georgia-Fairfax
 Fairfield-St Albans
 ROUTE NO. I89
 LOG STA.
 DESIGNED BY J.J.C. CHECKED BY A.J.C.
 PROJECT NO. I89-3(35)
 BR OF SHEET 15 OF 29
 BR-130