




PLAN  
SCALE 1" = 10'

Note:  
See Std. Dwg. G-3a For Dead  
End Anchorage of Bridge Approach.  
(Typical Both Ends).

Note: Bench Mark to be  
set in top of curb above  
Bridge Marker.

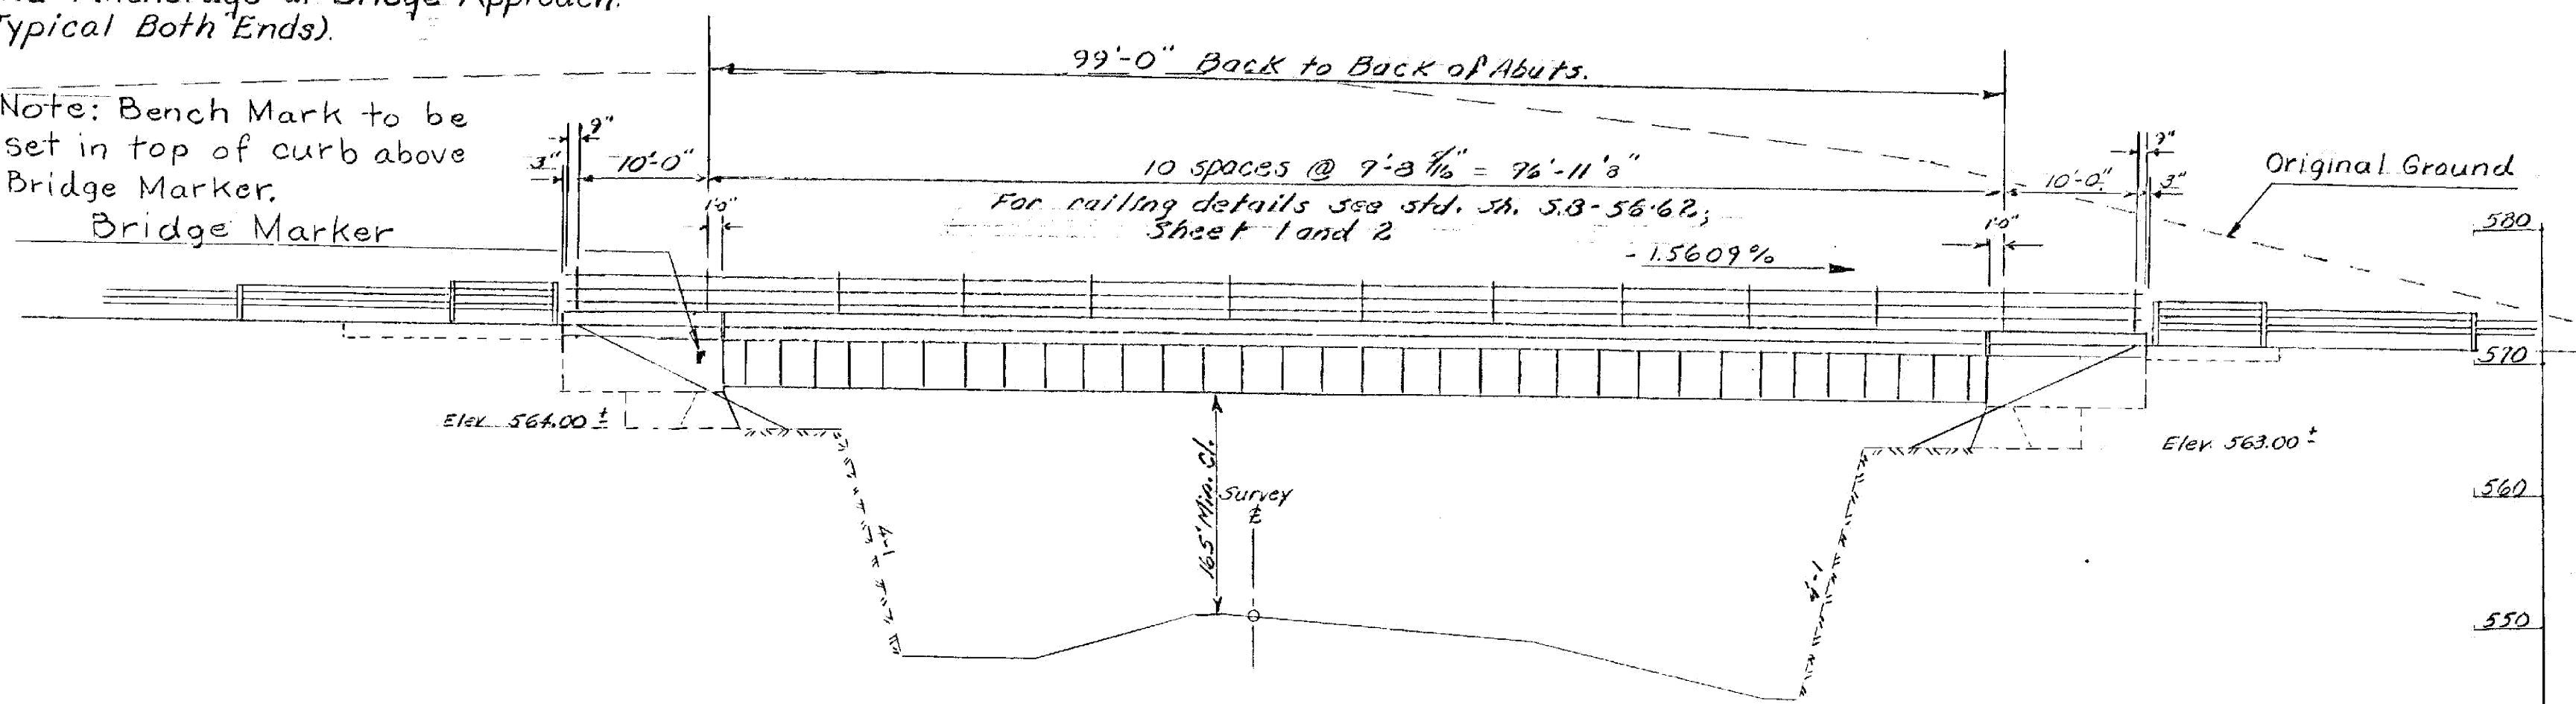

ELEVATION  
SCALE 1" = 10'

- List of Bridge Sheets
- BR100 Preliminary Information Sheet
  - BR101 Preliminary Information Plan
  - BR102&103 Boring Logs
  - BR104 Bridge Quantity Sheet
  - BR105 Plan and Elevation Southbound
  - BR106 Superstructure Details S.B.
  - BR107 Bearing Details S.B.
  - BR108 Abutment No.1 S.B.
  - BR109 Abutment No.2 S.B.
  - BR110 Approach slab No.1 S.B.
  - BR111 Approach Slab No.2 S.B.
  - BR112 Reinforcing Schedule S.B.
  - BR113 Plan and Elevation Northbound
  - BR114 Superstructure Details N.B.
  - BR115 Abutment No.1 N.B.
  - BR116 Abutment No.1 N.B. Details
  - BR117 Abutment No.2 N.B.
  - BR118 Abutment No.2 N.B. Details
  - BR119 Approach Slab No.1 N.B.
  - BR120 Approach Slab No.2 N.B.
  - BR 121&122 Reinforcing Schedule N.B.

- Bridge Standard Sheets
- SCB-D1-62, SCB-D2-62, Det. A, B, & C; SCB-D4-62;
  - SCB-D6-62, Det. A, B, C & D; SCB-D9-62, Det. A;
  - SCB-38-62; SCWPG-30-62, sheets 1, 2 & 4;
  - SB-56-62, sh #1; SB-56-62 sh #2, Det. A and B; G-3a.

- Reference Sheets
- Plan and Profile I 91 Sta. 3702 to 3718
  - Cross Sections I 91 SB & N.B. Sta. 3701+0 to 3705+50
  - Profile Ramp C Sta. 1 to 32
  - Cross Sections Ramp C Sta. 20+50 to 21+75

Notes

1. For General Notes see Std. Sh. SCB-D1-62.
2. Bridge railing is detailed for steel railing. Aluminum railing may be substituted with a maximum spacing of 7'-2" as per std. Sh SB-56-62, sh #1 & #2 Det. B.

HARTFORD-SHARON  
IM MEMB(15)

SHEET 14 OF 47  
BRIDGE 41N&S  
FOR REFERENCE ONLY

ITEM NO.	ITEM	UNIT	NET	TOTAL	FINAL
	CHAN. EXCAV. OF EARTH	C. Y.			
	CHAN. EXCAV. OF ROCK	C. Y.			
	UNCLASS. CHAN. EXCAV.	C. Y.			
	STRUCT. EXCAV.	C. Y.			
	CONC. CLASS AA (MOD.)	C. Y.			
	CONC. CLASS B (MOD.)	C. Y.			
	REINF. STEEL	LBS.			
	ASPHALTIC-ASB. COATING	S. Y.			
	TREATED TIMBER PILING	L. F.			
	SPLICES FOR STEEL PILING	EA.			
	STEEL PILING	L. F.			
	UNTREATED TIMBER PILING	L. F.			

Stage I & II Construction

STATE OF VERMONT  
DEPARTMENT OF HIGHWAYS

TOWNS OF Hartford

ROUTE No. I-91 LOG STA.

Interstate Over Ramp "C" (Southbound)

Plan and Elevation

SCALE 1" = 10'

SURVEYED BY JEWETT

DRAWN BY Wood CHECKED BY A.J.C.

PROJECT No. I-91(25)631

SHEET 13 OF 265 Sheet 175 of 222