


PLAN
Scale 1"=10'

- Notes
1. For General Notes see Std. Sh. SCB-D1-62 and SCWPG-30-62, sh. 1 of 4.
 2. Bridge railing is detailed for steel railing. Aluminum railing may be substituted with a max. spacing of 7'-2" as per std. Sh. SB-56-62, sh. #1 and sh. #2, Det. B.

HARTFORD-SHARON
IM MEMB(15)
SHEET 16 OF 47
BRIDGE 41N&S
FOR REFERENCE ONLY

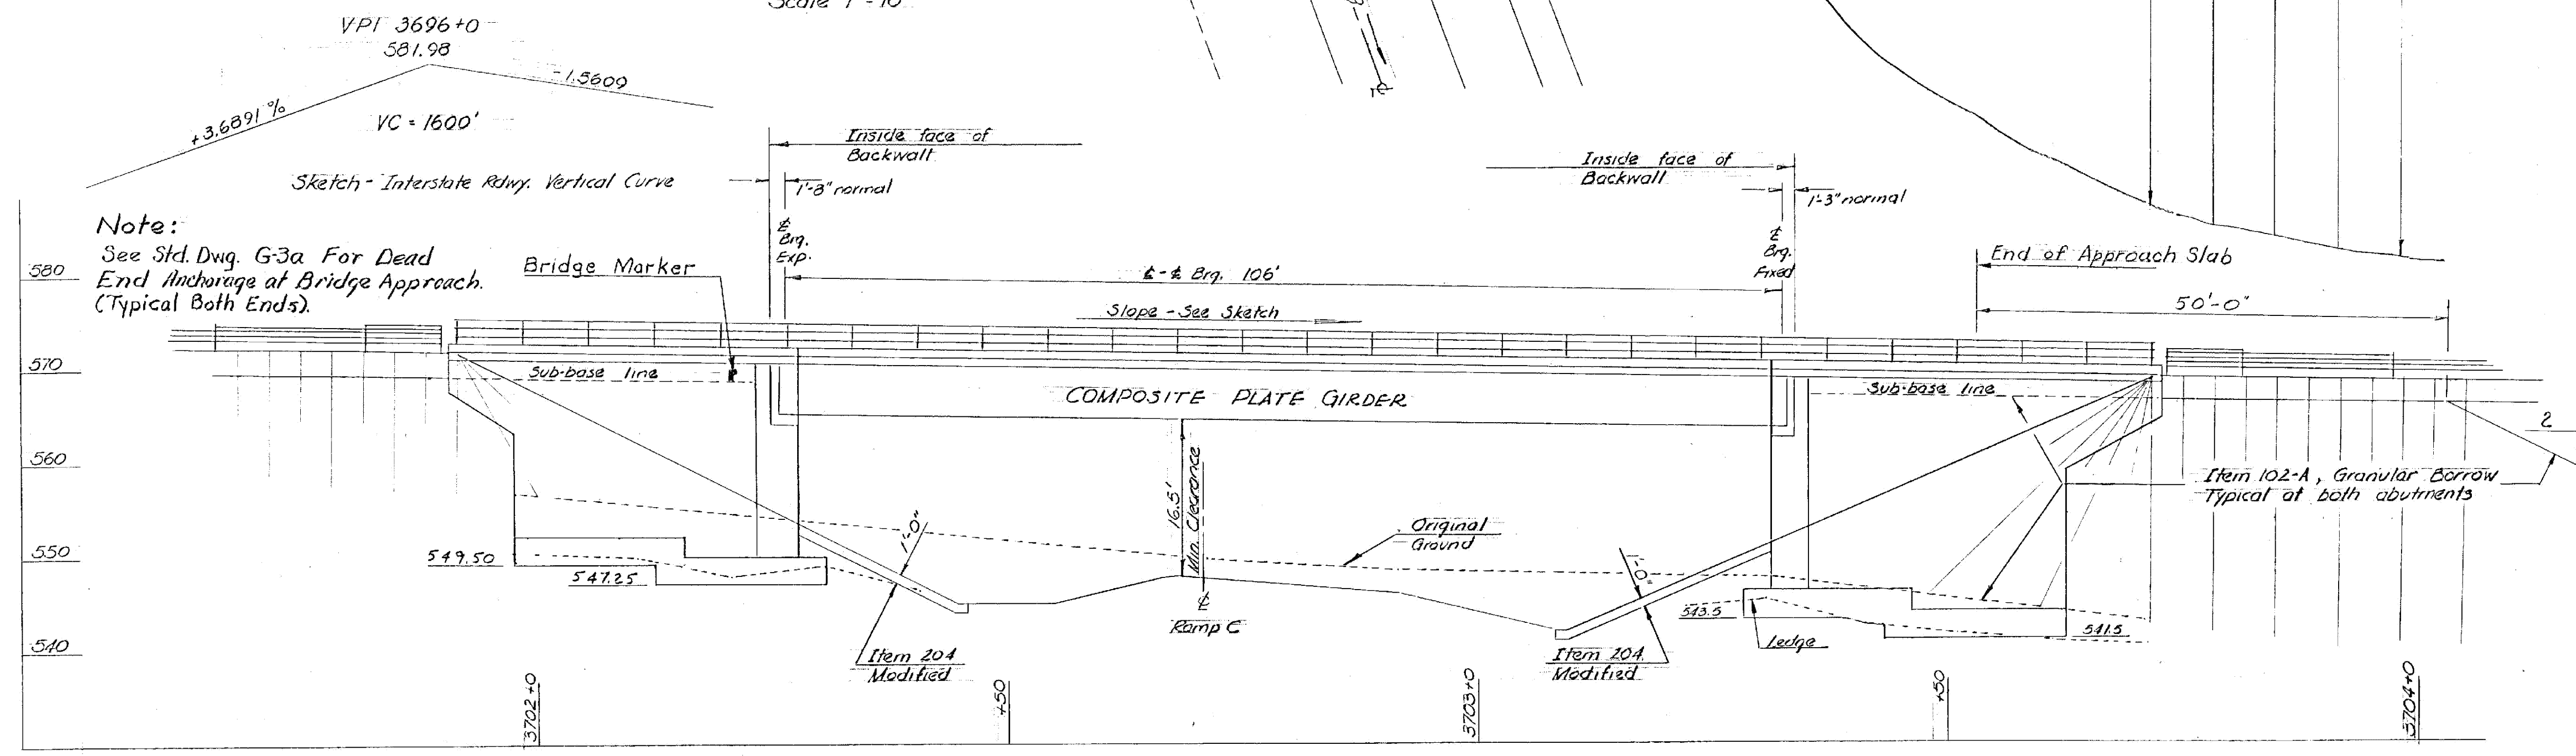

PROFILE N.B. BRIDGE ALONG RT. FASCIA @ 21+69 "C" Scale 1"=10'

Note:
See Std. Dwg. G-3a For Dead End Anchorage at Bridge Approach. (Typical Both Ends).

Stage II Construction

STATE OF VERMONT
DEPARTMENT OF HIGHWAYS

TOWN OF HARTFORD
ROUTE No. 191 LOG STA.
191 OVER RAMP C NORTHBOUND
PLAN & ELEVATION
SCALE 1"=10'
SURVEYED BY JEWETT
DRAWN BY A.B.B. CHECKED BY A.J.C.
PROJECT No. 191-1(25) (2A)
SHEET 16 OF 265 (Sheet 19 of 242)