




**Northbound Framing Plan**  
Scale 3/32" = 1'-0"

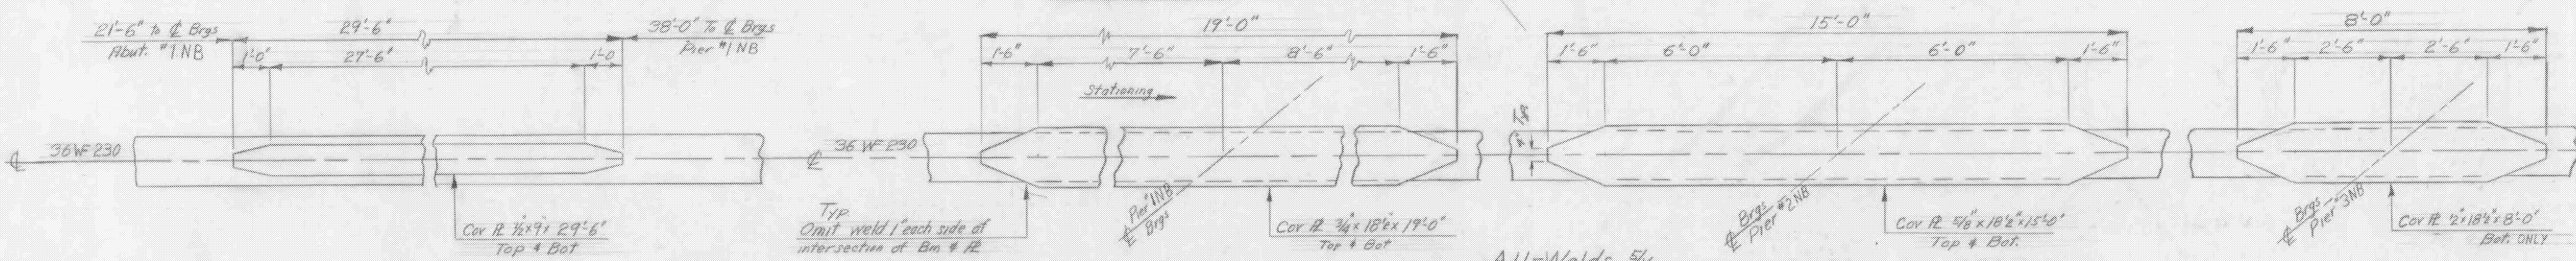

**Cover Plate Details**  
Scale 1/2" = 1'-0"

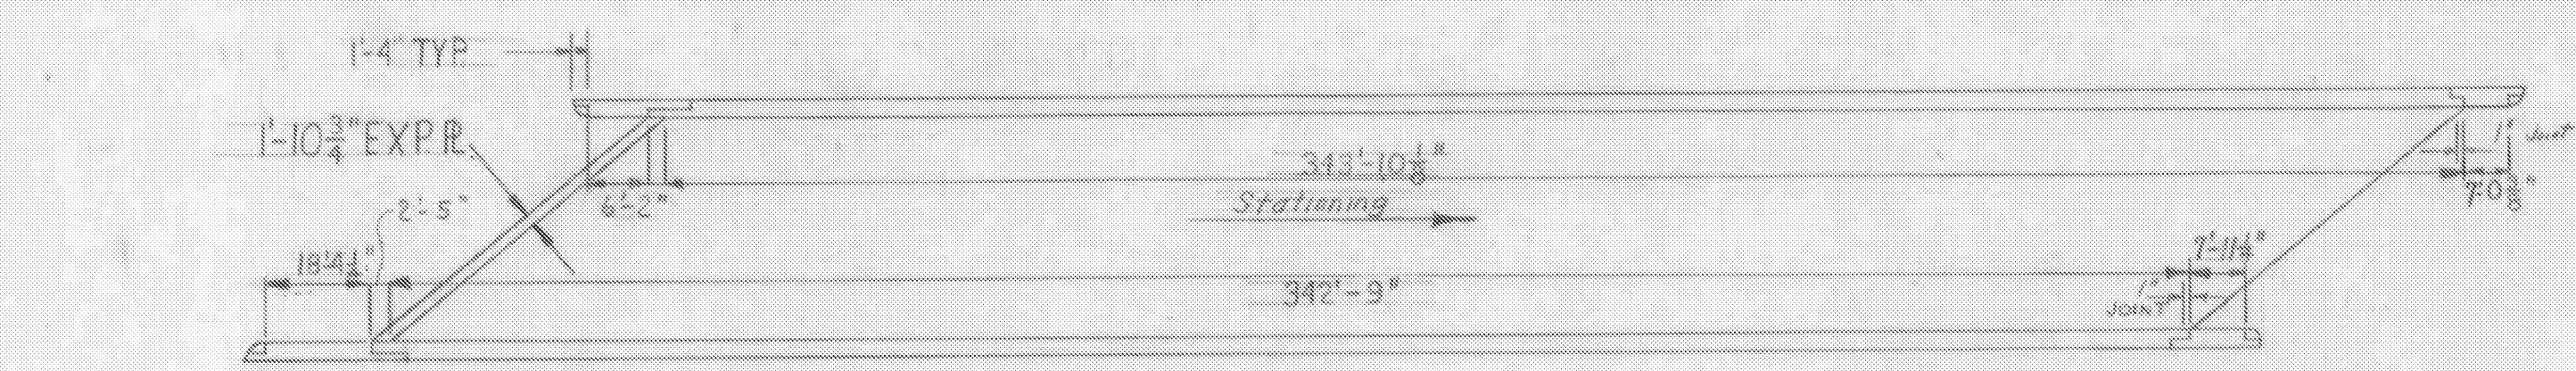

**Curb Plan**  
Scale 1" = 30'

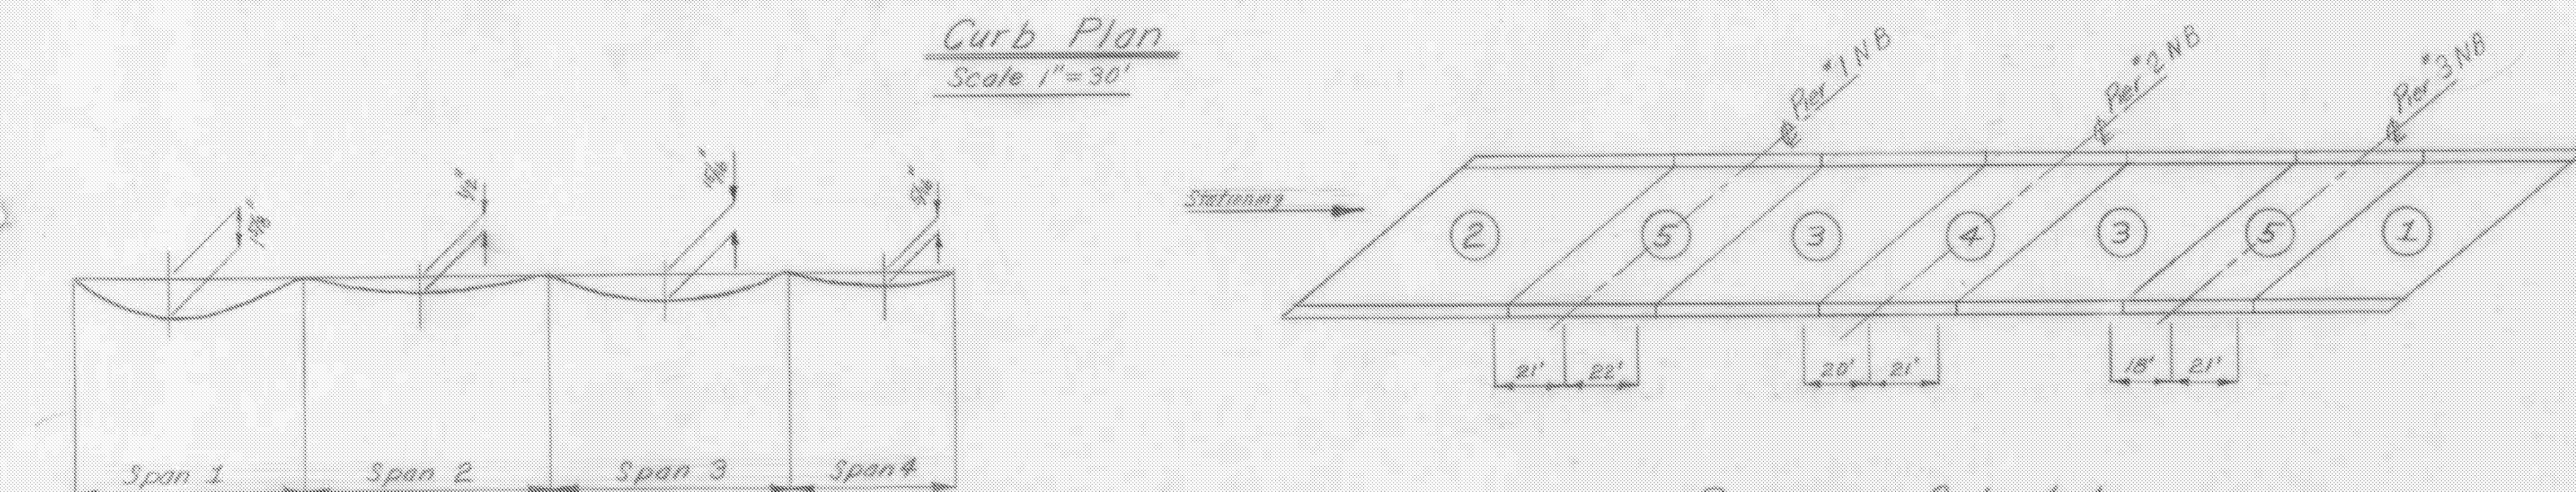

**Pouring Schedule**  
Scale 1" = 40'

**DL Deflection Diagram**  
N.T.S.

\*Indicates Roadway Quantities

HARTFORD-SHARON  
IM MEMB(15)  
SHEET 27 OF 47  
BRIDGE 42N&S  
FOR REFERENCE ONLY

- 1. FOR DIAPHRAGM DET. SEE SOUTHBOUND SUPERSTRUCTURE
- 2. FOR SUPERSTRUCTURE DETAIL SEE STD. SH. SCB 42-62
- 3. FOR GENERAL NOTES SEE STJ. SCB-D1-62
- 4. FOR SPLICE DETAILS SEE SB SUPERSTRUCTURE
- 5. FOR HAUNCH "
- 6. NO CAMBER IS REQUIRED. FABRICATE BEAMS WITH MILL CAMBER, IF ANY, UP.
- 7. FOR DETAILS OF EXP. JOINTS IN CURB NOT SHOWN SEE SHEETS BR 209, BR 219, BR 220, BR 221, AND BR 222.

SUPERSTRUCTURE EST. QUANTITIES NORTHBOUND				STAGE I & II CONSTRUCTION	
ITEM NO.	ITEM	UNIT	TOTAL	FINAL	
318	TAR EMULSION FOR BRIDGE FLOORS	GAL.	640		
361-B	BIT. CONC. PAVEMENT MOD. (DENSE GRADED TOP COURSE)	TON	135		
	UNCLASS. CHAN. EXCAV.	C.Y.			
	STRUCT. EXCAV.	C.Y.			
401-AA	CONC. CLASS AA (MOD.)	C.Y.	481		
	CONC. CLASS B (MOD.)	C.Y.			
402	REINF. STEEL	LBS.	119,003		
	ASPHALTIC-ASB. COATING	S.Y.			
	TREATED TIMBER PILING	L.F.			
	SPLICES FOR STEEL PILING	EA.			
	STEEL PILING	L.F.			
	UNTREATED TIMBER PILING	L.F.			
404-A	STRUCTURAL STEEL	LBS.	658,600		
556-C	GRANITE BRIDGE CURB MOD.	L.F.	686		
572	BRIDGE RAILING	L.F.	736	736	
372-A	JOINT SEALER - HOT POURED	L.F.	99		
372-C	JOINT SEALER - PREFORMED	L.F.	116		

STATE OF VERMONT  
DEPARTMENT OF HIGHWAYS  
TOWN OF Hartford  
ROUTE No. I-91 LOG STA.  
I-91 over I-89  
Northbound - Superstructure  
SCALE as noted  
SURVEYED BY  
DRAWN BY C.E.H. CHECKED BY A.J.C.  
PROJECT NO. I-91-1(25)  
SHEET 103 OF 265