


168

891

NO. 1 TITLE PAGE
2-4 QUANTITY SHEETS (ITEMS)

STATE OF VERMONT
DEPARTMENT OF HIGHWAYS

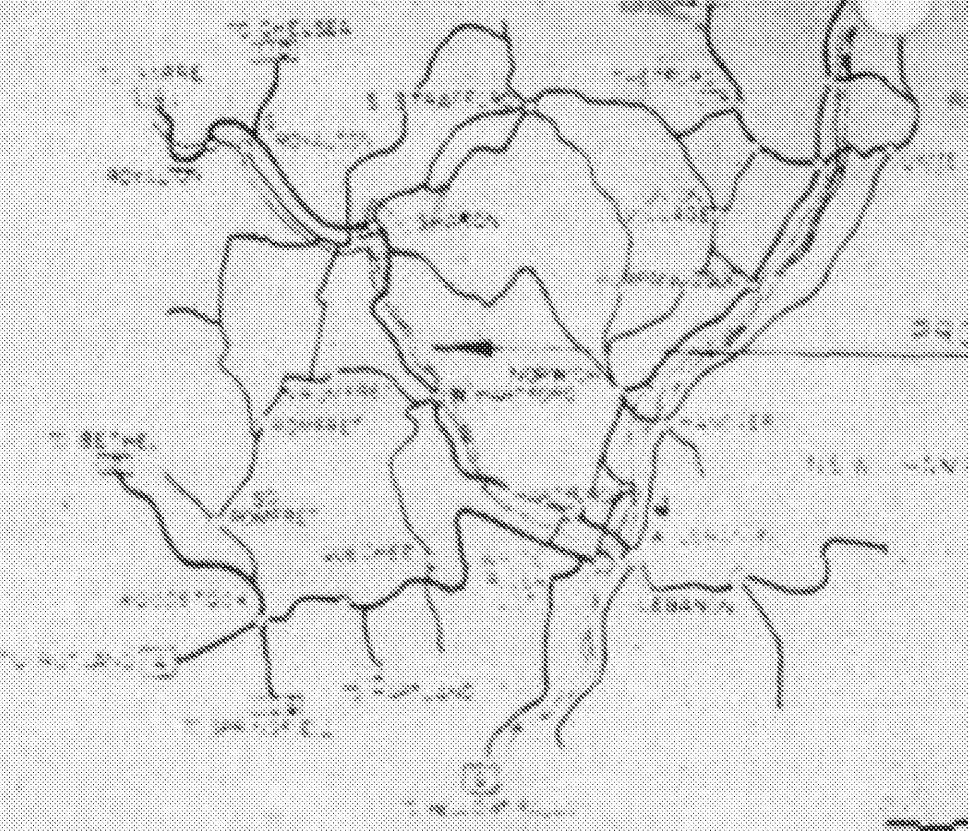

INTERSTATE PROJECT

TOWNS OF HARTFORD-SHARON
COUNTY OF WINDSOR
INTERSTATE ROUTE 89
HARTFORD-ROYALTON ROAD

SHARON

S 0177(1)

BEGINNING AT THE INTERSECTION OF VERMONT ROUTES 14 & 132, AND EXTENDING NORTHERLY 0.094 MILE.
LENGTH OF PROJECT 498.75 FT = 0.094 MI.


ADT 1962	865
ADT 1986	2000
DHV 1966	255
D 1966	56
T 1966	85%
V	30 M.P.H.

BEGINNING AT A POINT 3.483 MILES NORTHWEST OF THE HARTFORD-SHARON TOWN LINE AND EXTENDING NORTHERLY 1.577 MILES.
LENGTH OF ROADWAY 8,121.06 FEET = 1.538 MILES
LENGTH OF BRIDGES 207.49 FEET = 0.039 MILE
LENGTH OF CONTRACT 8,328.55 FEET = 1.577 MILES

Dated 20 October 1966
Celestina Sudo Gravel & Co. Alburgh Road, Alburgh, Vt.
Miller Construction Co. O. N. Miller, Inc.
Contractor
Simon D. Sheridan
By Order of Commissioner of Highways
Commissioner of Highways

CONTRACT # 4

1962	ADT	2040
1966	ADT	3300
1965	DHV	775
1965	D	56
1965	T	85%
1965	V	30 M.P.H.

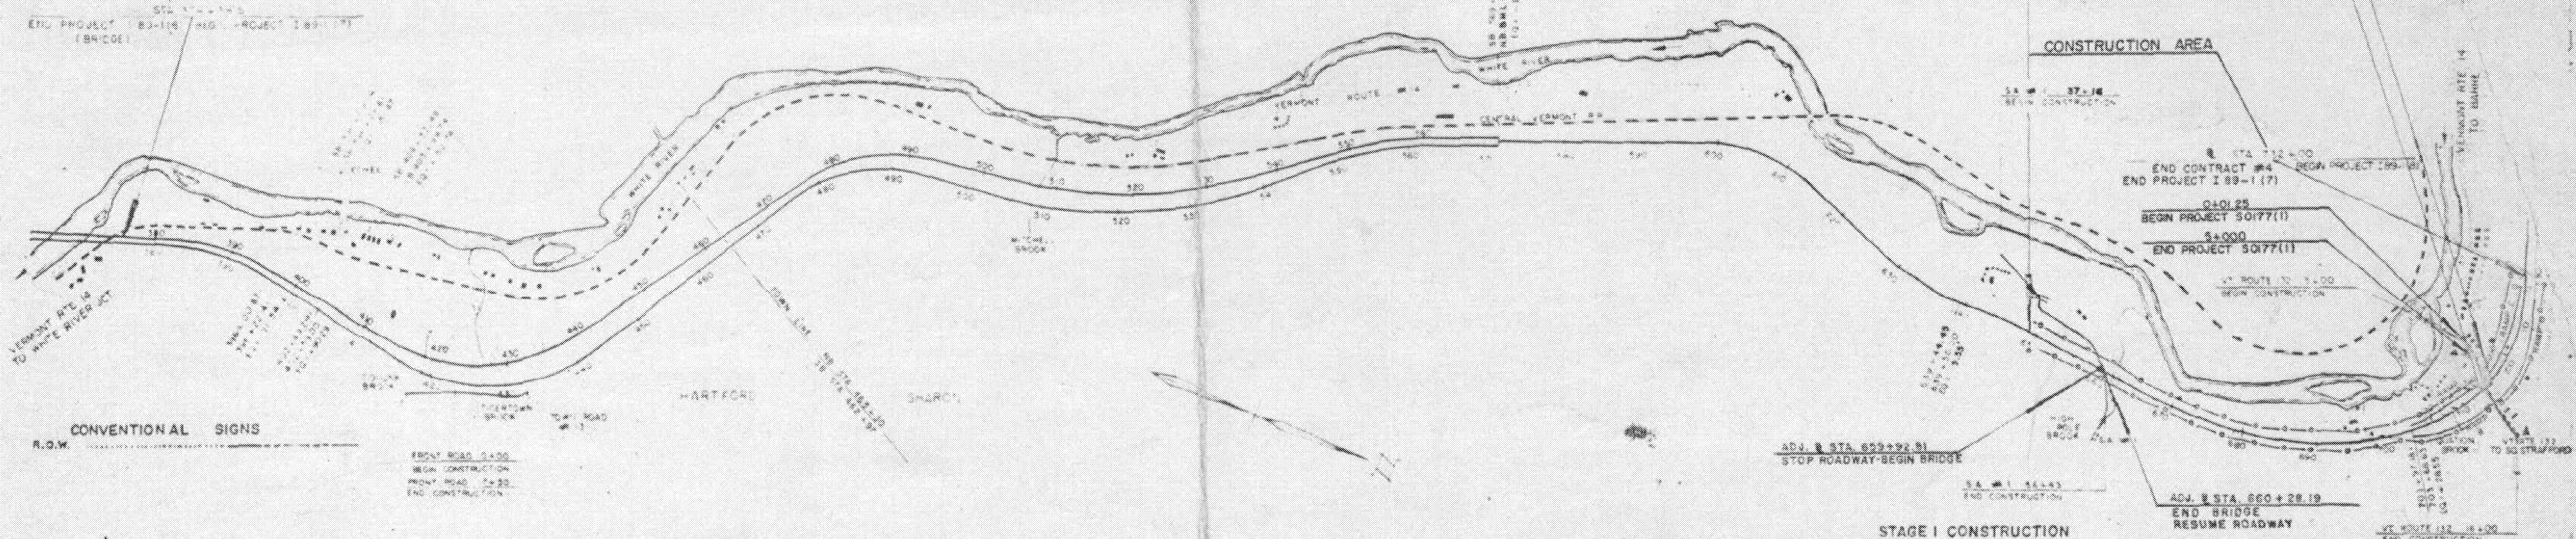

HARTFORD-SHARON
IM MEMB(15)
SHEET 43 OF 47
BRIDGE 15N&S
FOR REFERENCE ONLY

FOR RIGHT-OF-WAY DETAILS, SEE RIGHT-OF-WAY PLANS FOR THIS PROJECT.
THESE PLANS HAVE BEEN REDUCED PHOTOGRAPHICALLY
TO APPROXIMATELY 1/2 SCALE

THESE PLANS ARE SUBJECT TO SUCH REVISIONS AS MAY BE REQUIRED BY THE BUREAU OF PUBLIC ROADS OR THE COMMISSIONER OF HIGHWAYS.
CONSTRUCTION IS TO BE CARRIED ON IN ACCORDANCE WITH THESE PLANS AND THE STANDARD SPECIFICATIONS FOR HIGHWAY AND BRIDGE CONSTRUCTION, DATED APRIL 1964, AS APPROVED BY THE BUREAU OF PUBLIC ROADS ON OCT. 12, 1964, INCLUDING ALL SUBSEQUENT APPROVED REVISIONS AND SUCH REVISED SPECIFICATIONS AND SPECIAL PROVISIONS AS ARE INCORPORATED IN THESE PLANS.

APPROVED <u>R.H. Cundiff</u> ASST. CHIEF ENGINEER DATE <u>6/28/66</u>	APPROVED <u>P.H. Trebway</u> CONSTRUCTION ENGINEER DATE <u>6/28/66</u>	APPROVED <u>Luborn</u> BRIDGE ENGINEER DATE <u>4/28/66</u>	APPROVED <u>J.S. Chase</u> DISTRICT ENGINEER DATE <u>6/28/66</u>	APPROVED <u>G.M. Lane</u> HIGHWAY ENGINEER DATE <u>4/28/66</u>	APPROVED <u>A.D. Bishop</u> CHIEF ENGINEER DATE <u>4/28/66</u>
---	--	--	--	--	--

S 0177(1)
89-1(7)
COMPOSITE
SHEET 43 OF 47

LIMITED ACCESS FEDERAL AID CONSTRUCTION IDENTIFICATION SIGNS