


**TRAFFIC CONTROL ON INTERSTATE 91 RIGHT LANE CLOSED**

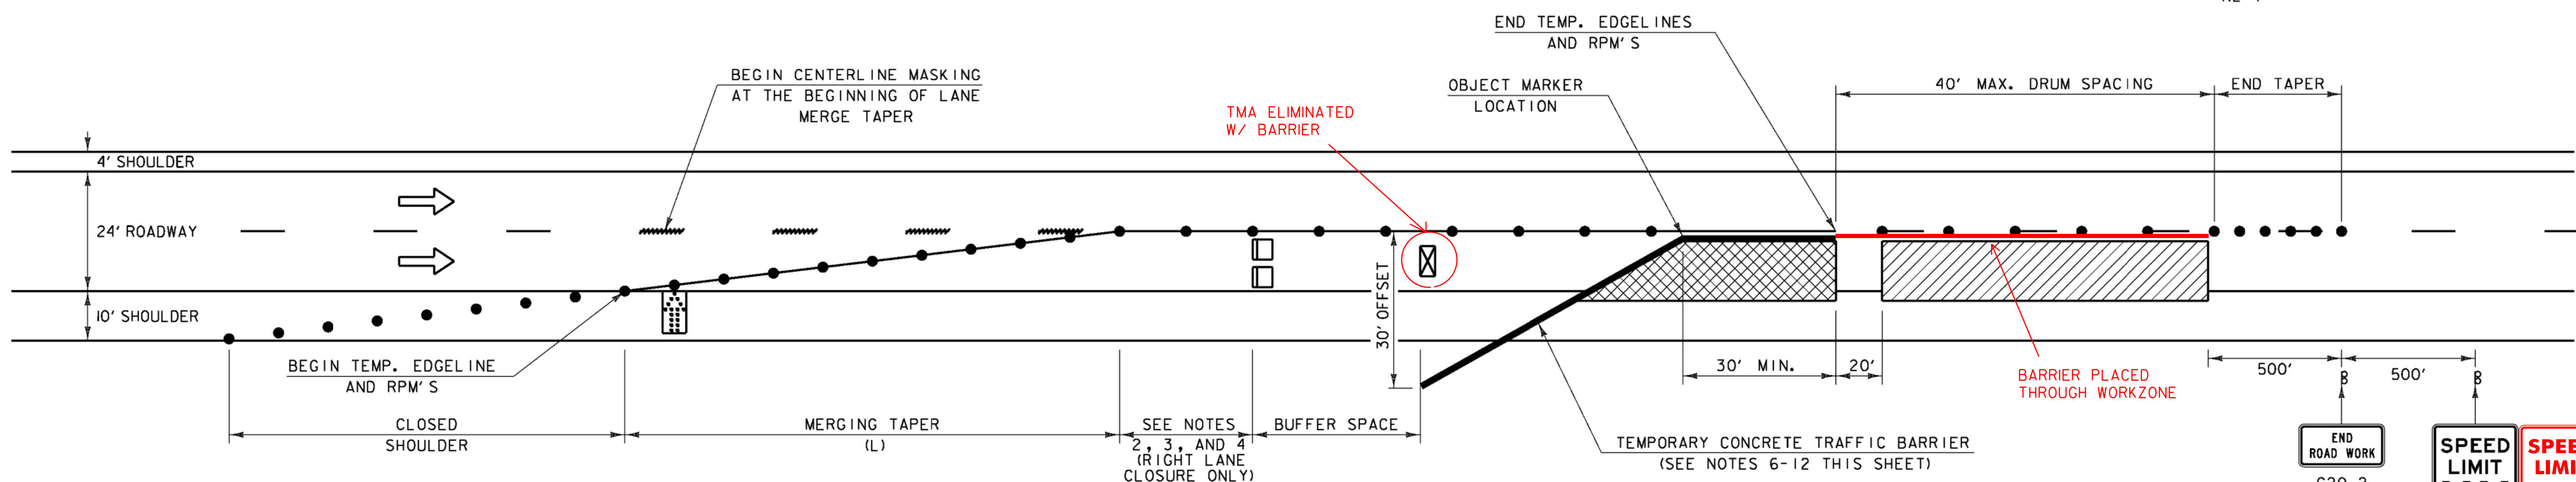

**TRAFFIC CONTROL ON INTERSTATE 91 RIGHT LANE CLOSED WITH TEMPORARY CONCRETE TRAFFIC BARRIER**


(RIGHT LANE CLOSURE SHOWN, LEFT LANE CLOSURE MIRRORED)

**CONCRETE MEDIAN BARRIER NOTES:**

6. THE EXISTING TRAVEL LANE WIDTH SHOULD BE MAINTAINED IF POSSIBLE.
7. TEMPORARY TAPE EDGELINES SHALL BE APPLIED AND SHALL MAINTAIN A ONE FOOT MINIMUM DISTANCE FROM THE BARRIER WITH TWO FEET BEING DESIRABLE.
8. LINE STRIPING TARGETS (LST'S) SHALL BE PLACED TO THE OUTSIDE OF THE TEMPORARY TAPE AT 20 FOOT SPACING.
9. PROVIDE A MINIMUM TAPER RATE AS SHOWN IN THE TABLE THIS SHEET, WITH A MINIMUM OF 30 FEET OF TANGENT SECTION PRIOR TO THE BEGINNING OF THE WORK ZONE.
10. THE END OF THE BARRIER FACING APPROACHING TRAFFIC SHALL MEET THE FOLLOWING REQUIREMENTS.
  - A. WHEN NO GUARDRAIL IS PRESENT, A 30 FOOT OFFSET SHALL BE USED FROM THE EDGE OF TRAVELLED WAY. IF A 30' OFFSET IS NOT ATTAINABLE, THEN AN ENERGY ABSORPTION ATTENUATOR SHALL BE PROVIDED.
  - B. IF GUARDRAIL IS PRESENT, THEN TEMPORARY CONCRETE TRAFFIC BARRIER SHALL BE CONNECTED TO EXISTING GUARDRAIL (COST INCIDENTAL TO ITEM 621.90 TEMPORARY TRAFFIC BARRIER) (COSTS FOR DISMANTLING BARRIER CONNECTION AND RESTORING EXISTING BARRIER TO ORIGINAL CONFIGURATION SHALL BE INCIDENTAL TO ITEM 621.90 TEMPORARY TRAFFIC BARRIER.)
11. ALL EQUIPMENT SHALL BE PARKED BEHIND TEMPORARY CONCRETE TRAFFIC BARRIERS AT NIGHT AND ON WEEKENDS WHEN NOT IN USE.
12. RETROREFLECTIVE PLASTIC DRUM SPACING SHALL BE 40 FOOT MAX. BETWEEN TEMPORARY CONCRETE TRAFFIC BARRIER AND END OF WORK ZONE.

**TRAFFIC CONTROL NOTES:**

1. DUE TO THE PROXIMITY OF BRIDGES 59S AND 60S, THE TRAFFIC CONTROL FOR THESE BRIDGES WILL BE PAID FOR UNDER ONE TRAFFIC CONTROL ITEM.
2. FOR BRIDGES 59S AND 60S, TRAFFIC CONTROL SHALL BE INSTALLED IN ACCORDANCE WITH STANDARD E-106, "MAINLINE LANE CLOSURE AT AN EXIT RAMP".
3. FOR BRIDGE 67N, TRAFFIC CONTROL SHALL BE INSTALLED IN ACCORDANCE WITH STANDARD E-106, "MAINLINE LANE CLOSURE AT AN ENTRANCE RAMP".
4. FOR BRIDGES 64N, 64S, AND 69N, THE RIGHT LANE CLOSURE SHALL BE AS SHOWN ABOVE WITH ZERO FEET BETWEEN THE MERGING TAPER (L) AND THE BUFFER SPACE.
5. SEE THE TRAFFIC CONTROL NOTES ON THE PREVIOUS SHEET (TRAFFIC CONTROL SHEET 1) FOR ADDITIONAL NOTES AND APPROACH SIGNING FOR THE RIGHT LANE CLOSURE.

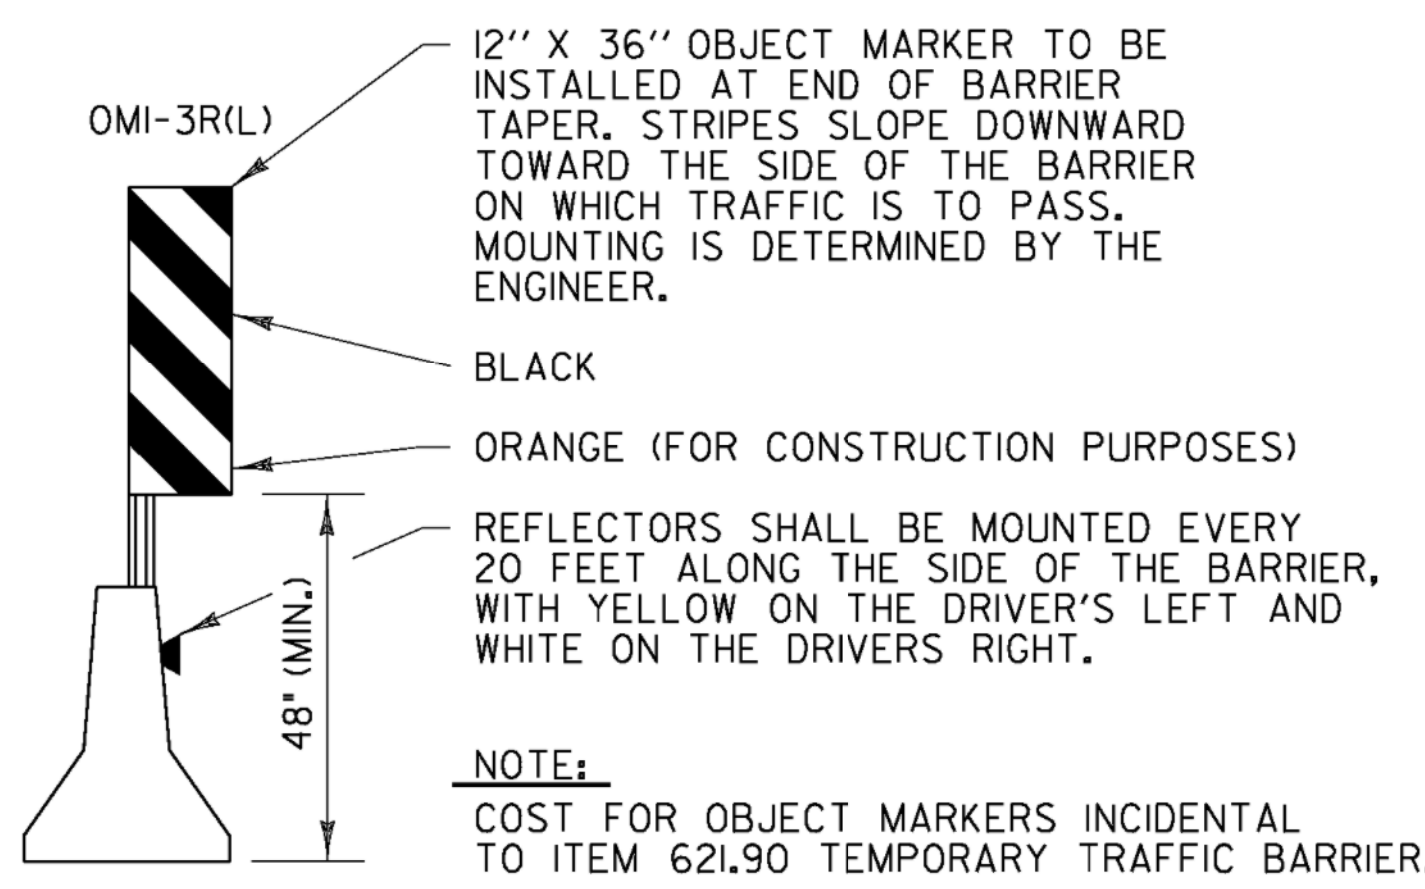

**NOTE:**  
COST FOR OBJECT MARKERS INCIDENTAL TO ITEM 621.90 TEMPORARY TRAFFIC BARRIER.

**LEGEND**

- FLOW OF TRAFFIC
- RETROREFLECTIVE PLASTIC DRUM
- PORTABLE ARROW BOARD
- TYPE II BARRICADE
- WORK AREA
- TRUCK/TRAILER MOUNTED ATTENUATOR
- PORTABLE CHANGEABLE MESSAGE SIGN (SEE NOTE 15 ON TRAFFIC CONTROL SHEET 1)
- CONSTRUCTION STAGING/ STORAGE AREA (SEE NOTE 11 THIS SHEET)

POSTED SPEED (MPH)	TAPER LENGTHS (FT)		TANGENT W=12 FT (L/2)	BARRIER FLARE RATE (MINIMUM)	MINIMUM BUFFER SPACE LENGTH (FT)	MAXIMUM CHANNELIZING DEVICE SPACING (FT)	
	SHOULDER W=10 FT (L/3)	MERGING 12 FT LANE (L)				TAPER (S)	TANGENT (2S)
≤40	90	320	160	1:9	305	40	80
45	150	540	270	1:9	360	45	90
50	170	600	300	1:11	425	50	100
55	185	660	330	1:13	495	55	110
60	200	720	360	1:13	570	60	120
65	215	780	390	1:13	645	65	130

TAPER RATES ARE DETERMINED USING THE FOLLOWING EQUATION:  
 $L = WS$  FOR POSTED SPEEDS OF 45 MPH OR GREATER  
 $L = WS^2/60$  FOR POSTED SPEEDS OF 40 MPH OR LESS  
 L = MINIMUM LENGTH OF TAPER  
 W = WIDTH OF OFFSET IN FEET. (TYPICAL)  
 S = POSTED SPEED IN MPH

PROJECT NAME: BRADFORD - RYEGATE  
 PROJECT NUMBER: IM MEMB(16)  
 FILE NAME: 06-TCS 2.dgn  
 PROJECT LEADER: JPB  
 DESIGNED BY: SRB  
**TRAFFIC CONTROL SHEET 2**  
 PLOT DATE: 2/25/2009  
 DRAWN BY: MWS  
 CHECKED BY: JPB  
 SHEET 6 OF 61