


MATERIAL QUANTITIES

DESCRIPTION	UNIT	QUANTITY
CONCRETE REMOVAL	CY	8
REINFORCING STEEL	LBS	687
CONCRETE CLASS A	CY	6
BITUMINOUS CONCRETE PAVEMENT	TON	3 1/2
ASPHALTIC PLUG JOINT	LF	53

REINFORCING STEEL

NO.	PIECES	SIZE	LENGTH	MARK	TYPE	REINFORCING STEEL					
						A	B	C	D	G	H
49	5	5	3'-1"		S10		1'-3 1/4"		1'-3 1/4"		0'-4 1/2"
8	5	5	4'-5 1/2"		S5	3"	1'-4 1/4"	1'-1/2"	1'-4 1/4"	3"	
86	5	5	3'-3"	S501	STR						
4	5	5	36'-8"	S502	STR						

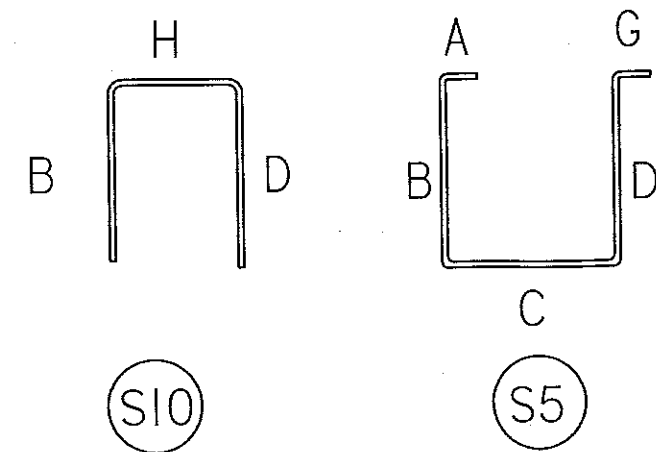

BARNET, I-91, BR 74N

QUANTITIES

DESIGNED/DRAWN BY: DWH
CHECKED BY:

SHEET 7 OF 7