

~~REMOVE EXISTING CHAIN LINK FENCE TO CONSTRUCT PROPOSED HEADWALL. WORK PAID FOR UNDER ITEM 620.55, "REMOVAL OF EXISTING FENCE." CONSTRUCT NEW CHAIN LINK FENCE TO CONNECT EXISTING FENCE TO END OF PROPOSED HEADWALL. WORK PAID FOR UNDER ITEM 620.12, "CHAIN-LINK FENCE, 6 FEET."~~


WOVEN WIRE (MOD)  
SEE C.O. #5

PROPOSED CAAP LINER  
(MINIMUM DIAMETER = 132")  
128"

REMOVE EXISTING PIPE CRADLE.  
CONSTRUCT REINFORCED CONCRETE  
FULL BEVELED HEADWALL.

GENERAL NOTES:

1. THE CONTRACTOR WILL BE RESPONSIBLE FOR PROVIDING TEMPORARY ACCESS TO THE CULVERT ENDS. ALL RESULTING DISTURBED EARTH SHALL BE STABILIZED AND RESTORED UPON COMPLETION OF CONSTRUCTION. PAYMENT SHALL BE MADE UNDER CONTRACT ITEM 900.645 - SPECIAL PROVISION (TEMPORARY ACCESS ROAD AND STAGING AREAS, CULVERT) (189 - BR NO. 14-2)
2. EXISTING FENCING DISTURBED BY THE CONTRACTOR TO PROVIDE TEMPORARY ACCESS OR STAGING AREA MUST BE RESTORED AT THE COMPLETION OF THE PROJECT. THIS WORK WILL BE INCIDENTAL TO ITEM 900.645 - SPECIAL PROVISION (TEMPORARY ACCESS ROAD AND STAGING AREAS, CULVERT)
3. SEE HEADWALL DETAILS FOR LIMITS OF STONE FILL.

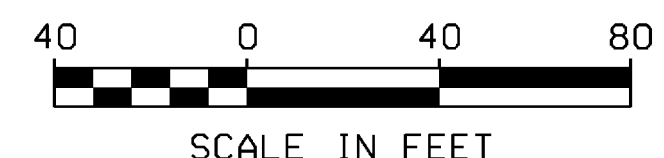

PROJECT NAME: SHARON	
PROJECT NUMBER: IM CULV (18)	
FILE NAME: L03.dgn	PLOT DATE: 13-JUL-2009
PROJECT LEADER: DMB	DRAWN BY: MJF
DESIGNED BY: MHM	CHECKED BY: DMB
LAYOUT SHEET (14-2)	SHEET 21 OF 36