


- SITE STABILIZATION NOTES:**
1. ALL DISTURBED GRASSED AREAS SHALL BE STABILIZED WITH SEED AND MULCH.
  2. ALL DISTURBED STONE AREAS AND AREAS BELOW ORDINARY HIGH WATER SHALL BE STABILIZED WITH STONE FILL, TYPE IV.
  3. SEE HEADWALL DETAILS FOR LIMITS OF PROPOSED STONE FILL AND PERMANENT EROSION MATTING.

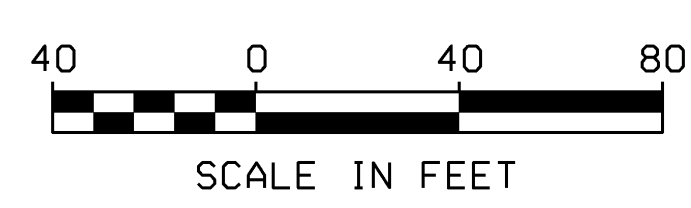

PROJECT NAME: SHARON	
PROJECT NUMBER: IM CULV (18)	
FILE NAME: FC03.dgn	PLOT DATE: 13-JUL-2009
PROJECT LEADER: DMB	DRAWN BY: MJF
DESIGNED BY: MHM	CHECKED BY: DMB
FINAL CONDITIONS SITE PLAN (14-2)	SHEET 27 OF 36