


TRAFFIC CONTROL NOTES:

1. RAMPs AT EXIT 24 SHALL REMAIN OPEN AT ALL TIMES.
2. RAMPs AT THE EXISTING REST AREA SHALL REMAIN OPEN AT ALL TIMES.
3. SEE VTRANS STANDARD DRAWINGS FOR ADVANCED WARNING SIGN PLACEMENT.

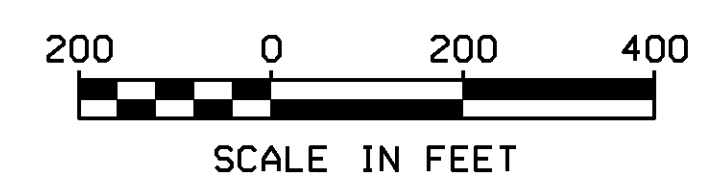

PROJECT NAME: LYNDON - DERBY	PLOT DATE: 24-AUG-2009
PROJECT NUMBER: IM CULV (19)	DRAWN BY: MJF
FILE NAME: z08a192+cp011n.dgn	CHECKED BY: DMB
PROJECT LEADER: DMB	DESIGNED BY: BRC
TRAFFIC CONTROL PLAN - LYNDON 96-2N&S	SHEET 8 OF 28