


SITE STABILIZATION NOTES:

1. ALL DISTURBED GRASSED AREAS SHALL BE STABILIZED WITH SEED AND MULCH.
2. ALL DISTURBED STONE AREAS AND AREAS BELOW ORDINARY HIGH WATER SHALL BE STABILIZED WITH STONE FILL, TYPE IV.
3. SEE HEADWALL DETAILS FOR LIMITS OF PROPOSED STONE FILL.

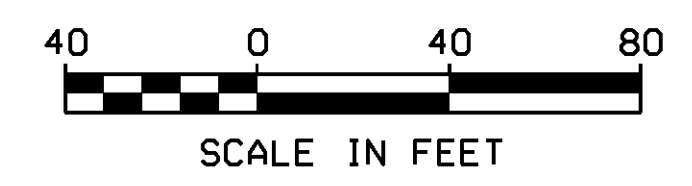

PROJECT NAME: LYNDON - DERBY	PLOT DATE: 24-AUG-2009
PROJECT NUMBER: IM CULV (19)	DRAWN BY: MAL
FILE NAME: z08a192fc01ln.dgn	CHECKED BY: DMB
DESIGNED BY: MHM	SHEET 12 OF 28
FINAL CONDITIONS - LYNDON 96-2N&S	