


HEADWALL ELEVATION

SCALE 1/2" = 1'-0"
 1 0 1 2

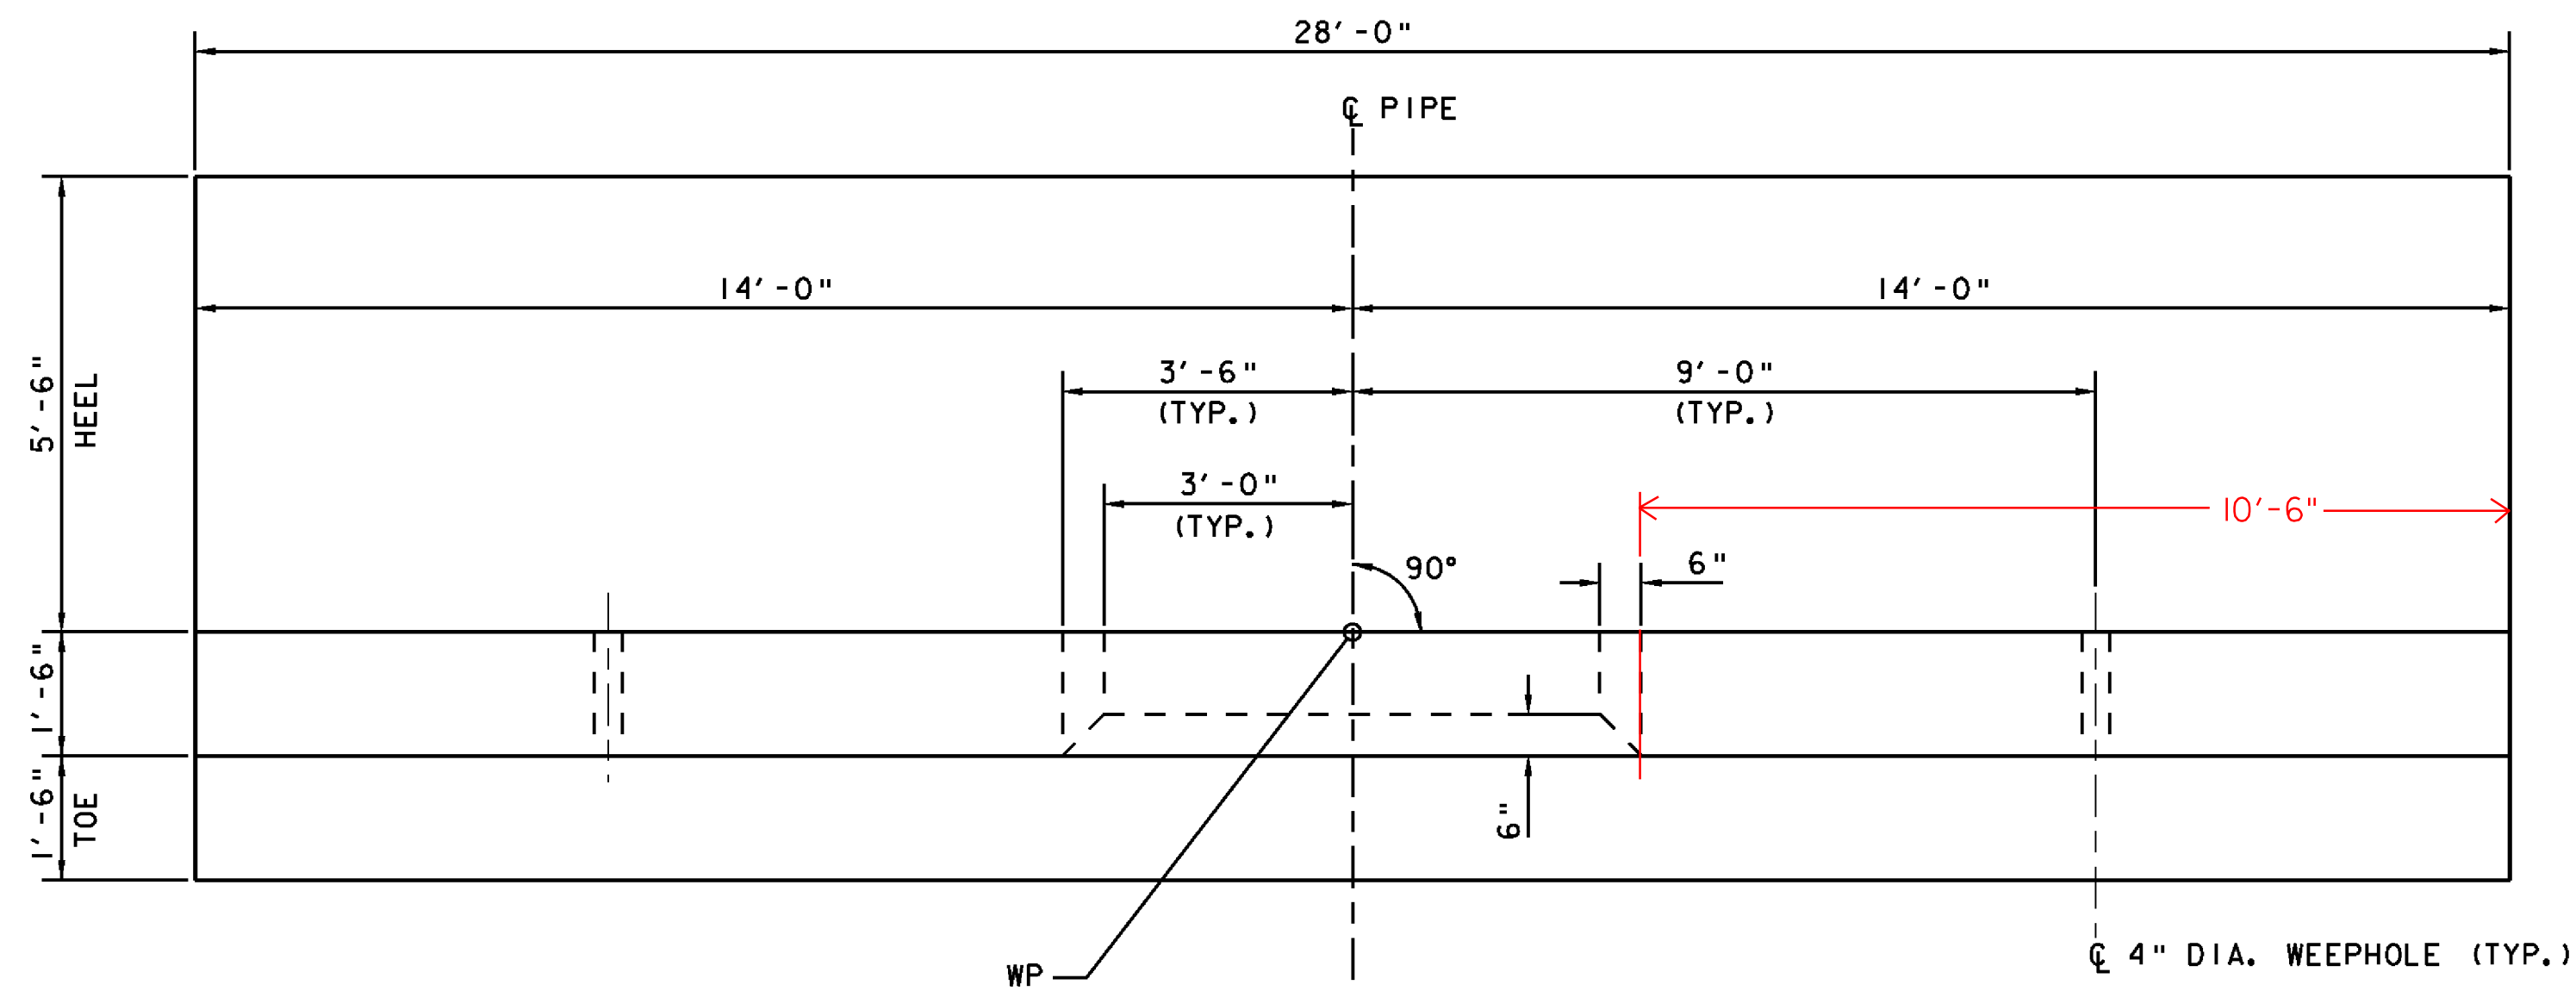


HEADWALL PLAN

SCALE 1/2" = 1'-0"
 1 0 1 2


NOTE:

- NF - NEAR FACE
- FF - FAR FACE
- EF - EACH FACE
- ▲ - CUT TO FIT IN FIELD
- 3" CLR. UNLESS OTHERWISE SPECIFIED ON THE PLANS.

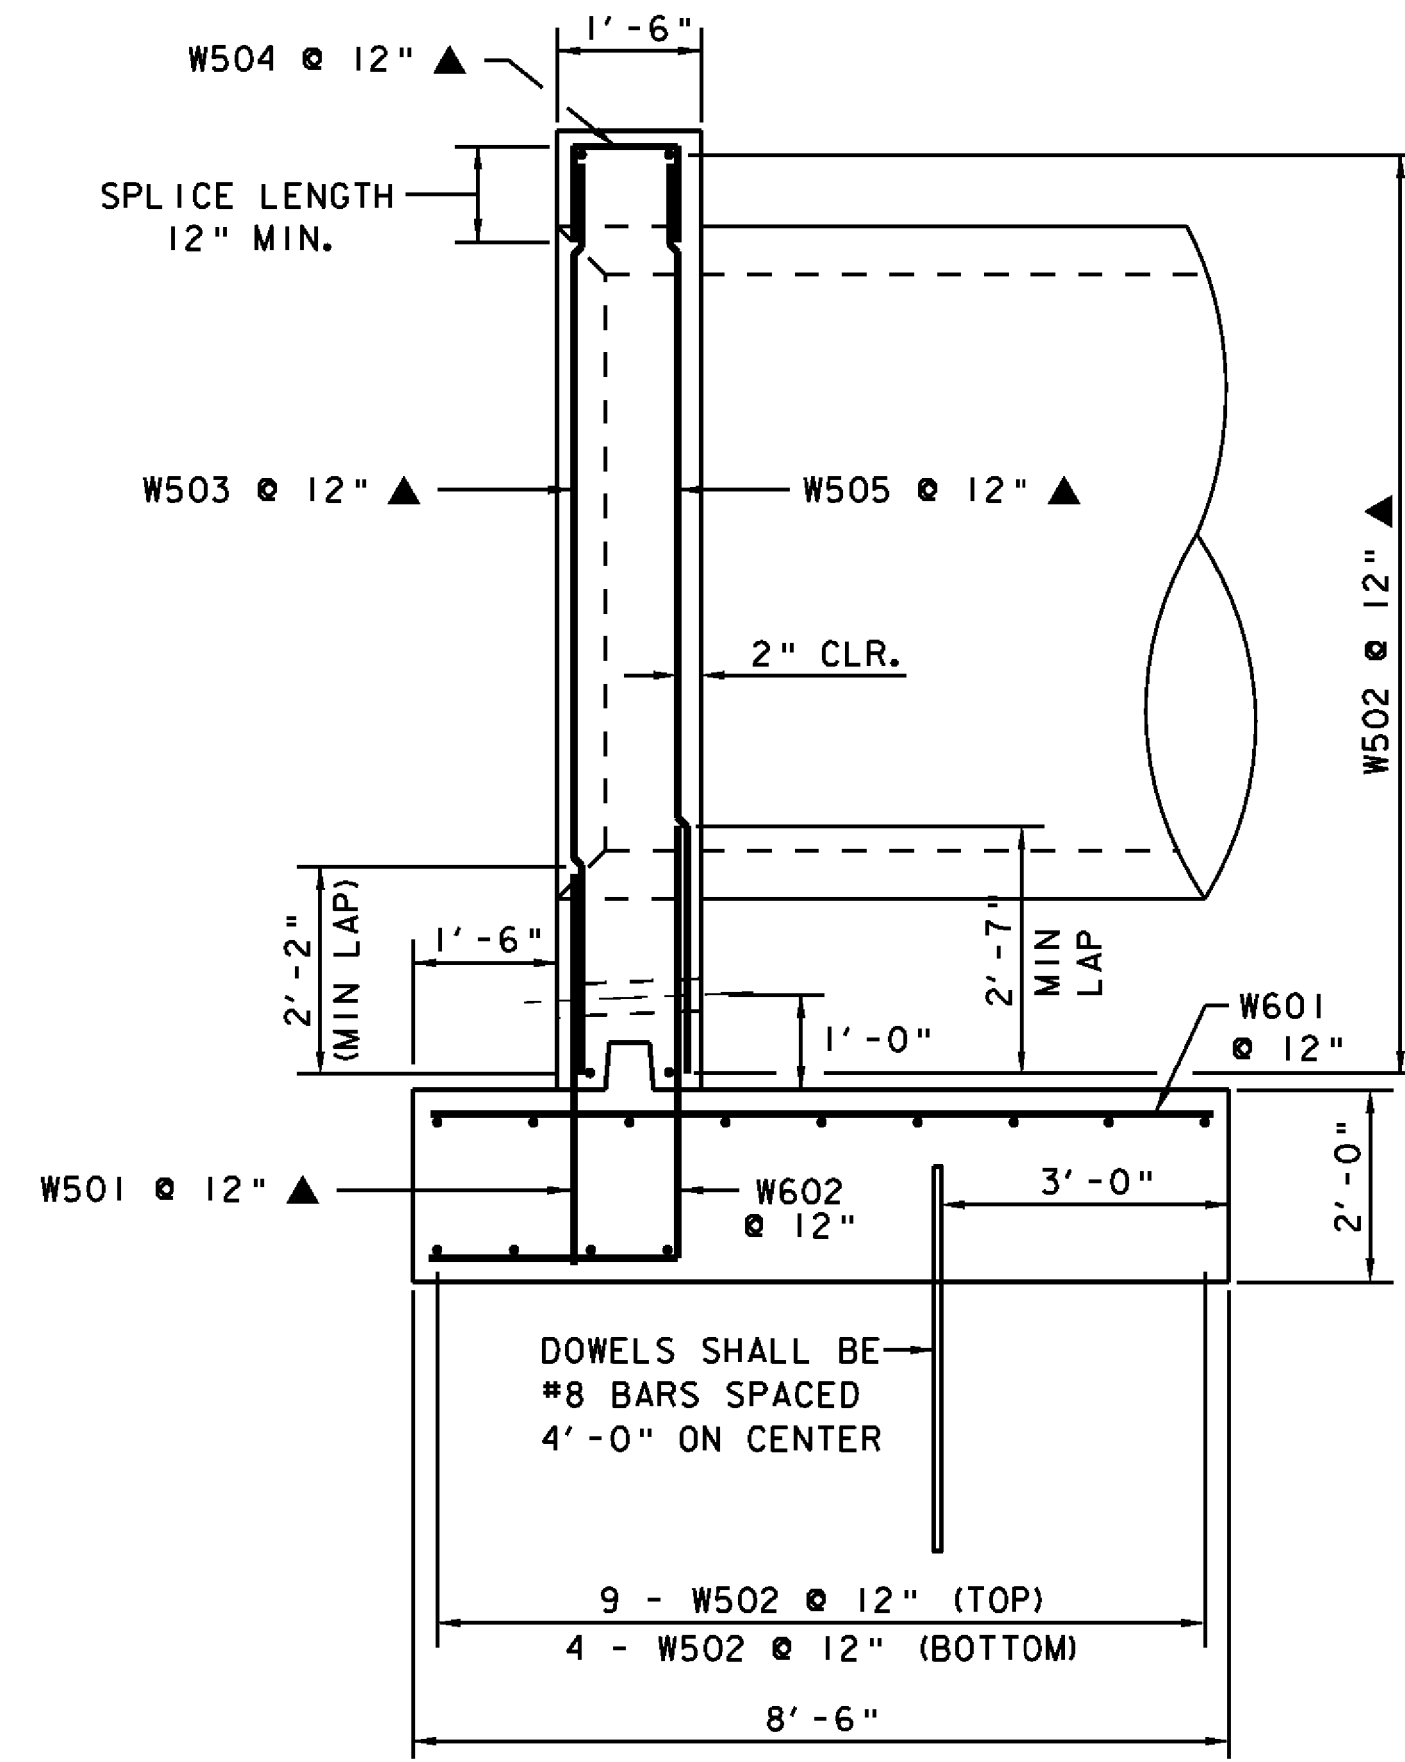


HEADWALL SECTION

SCALE 1/2" = 1'-0"
 1 0 1 2

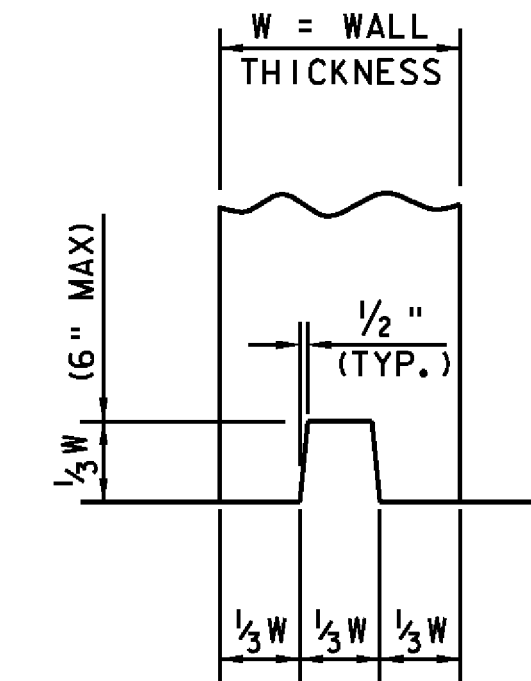

DETAIL 'A'
 NOT TO SCALE

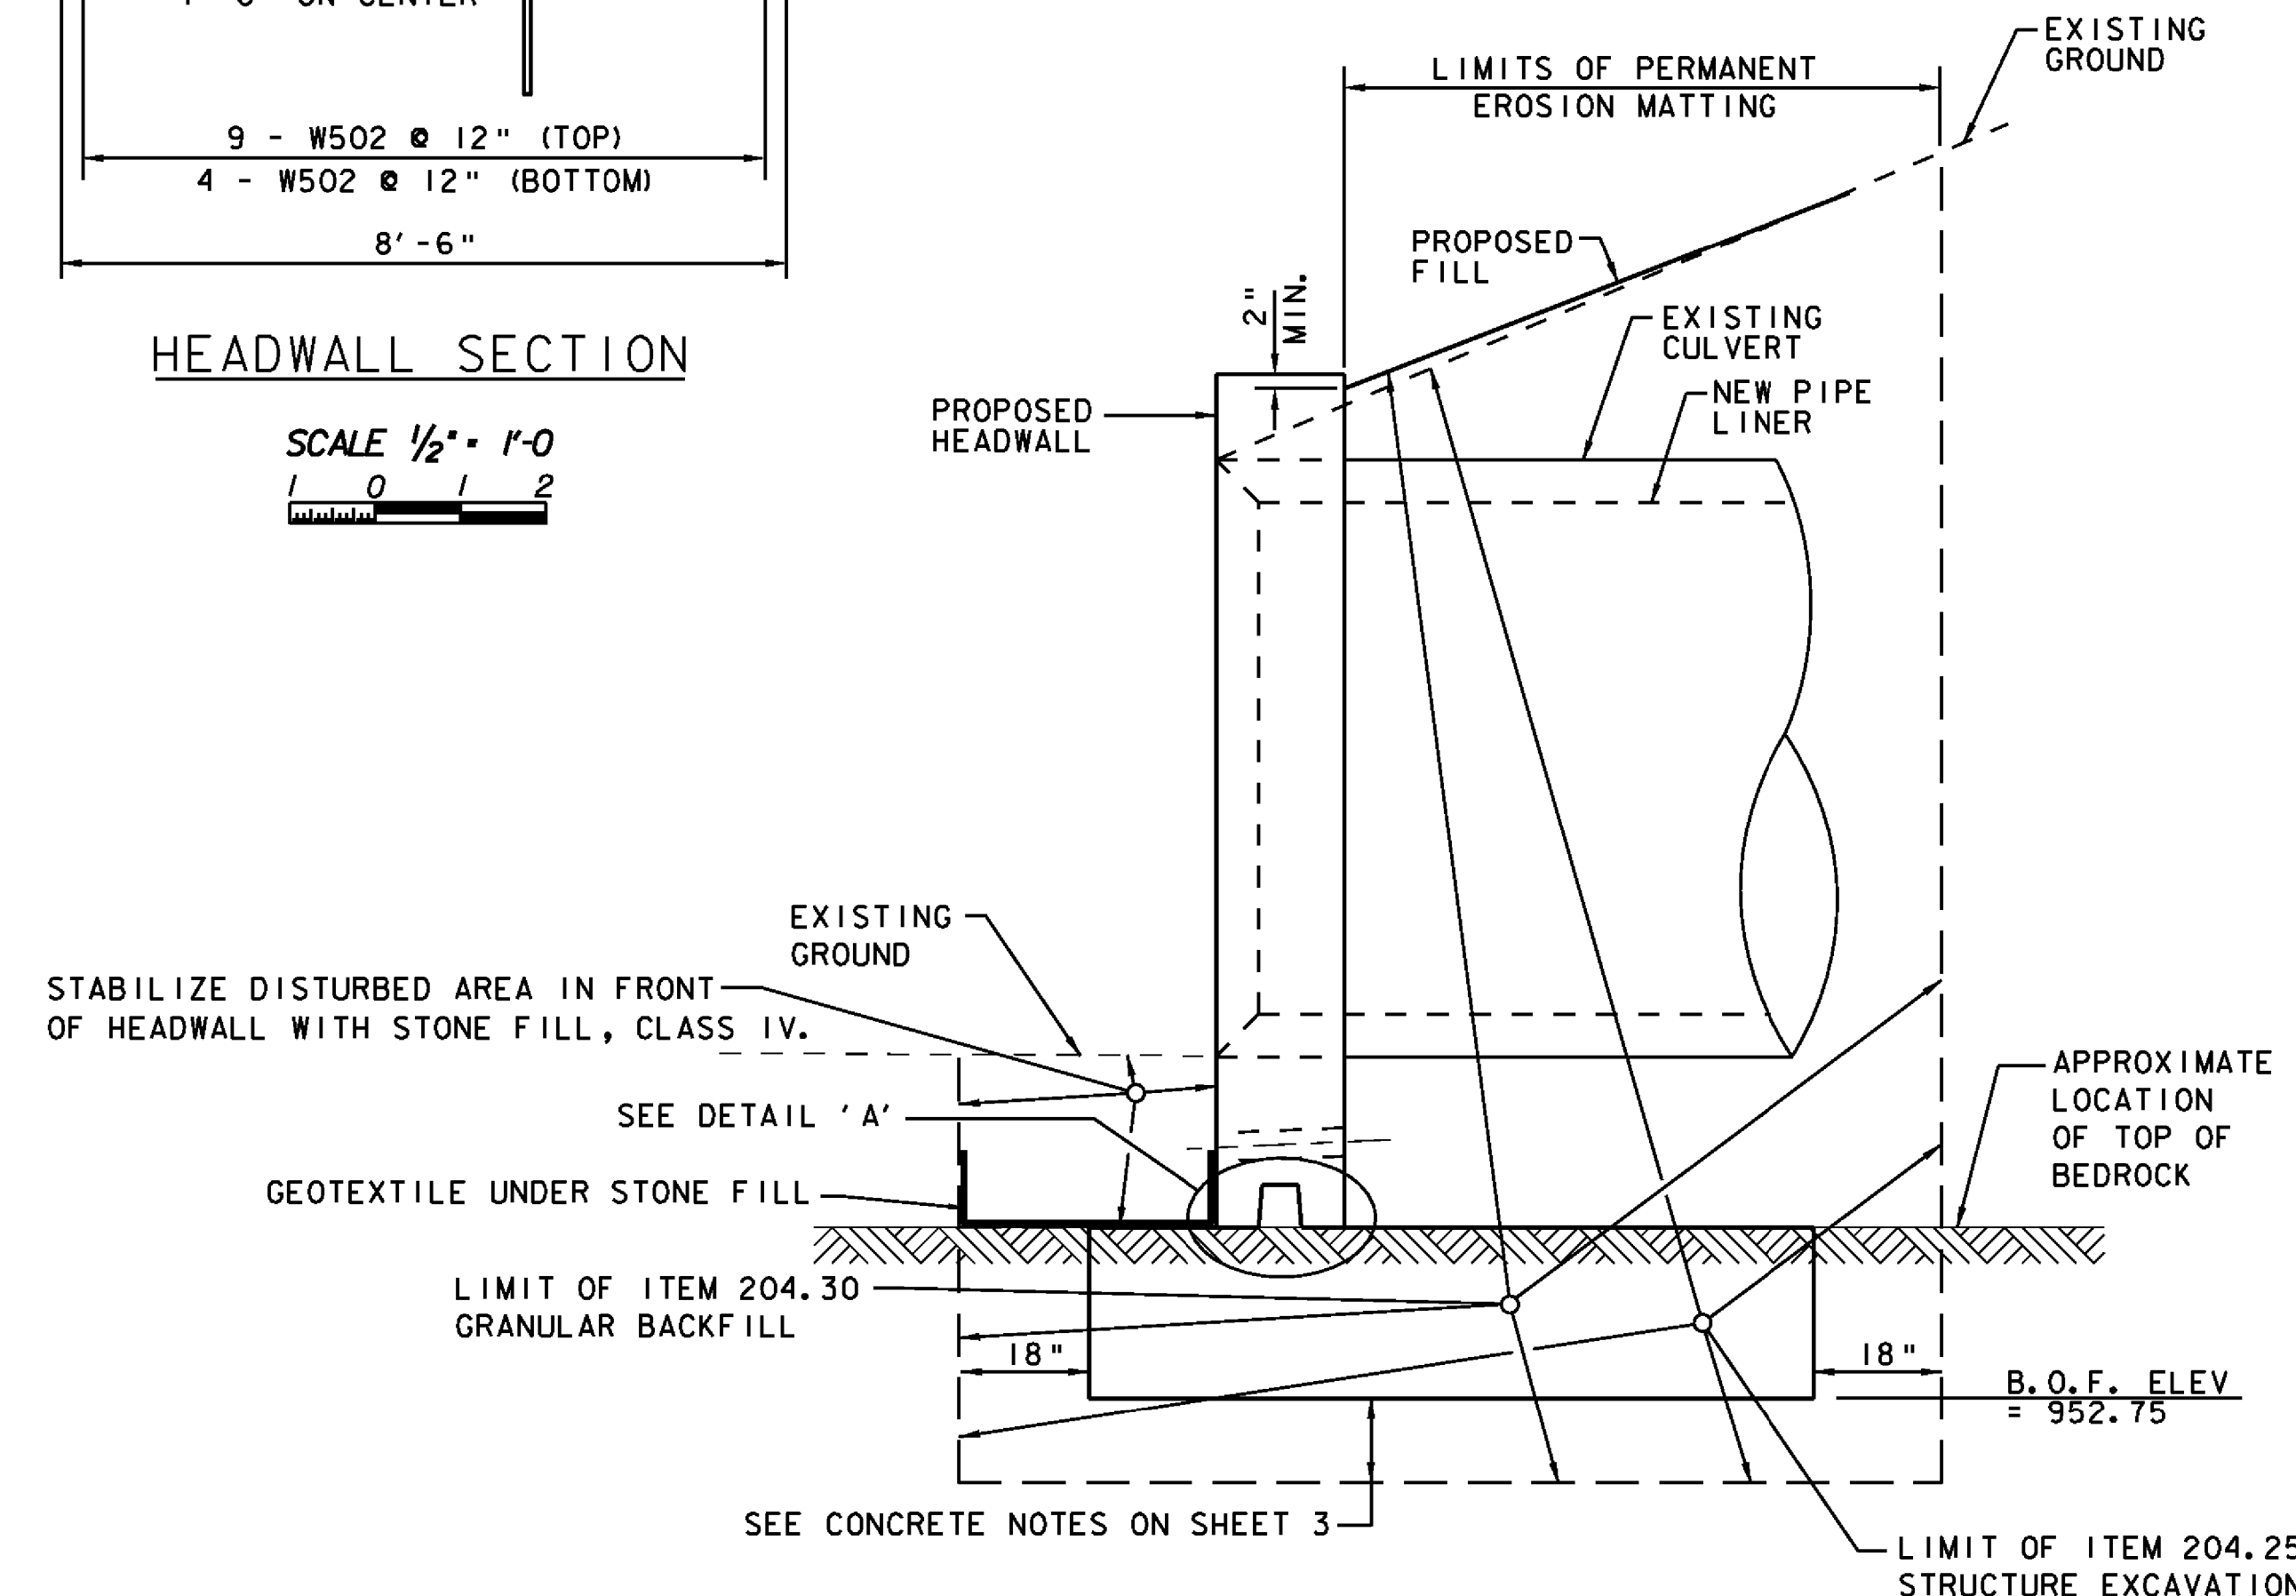

PROPOSED HEADWALL SECTION

SCALE 1/2" = 1'-0"
 1 0 1 2

PROJECT NAME: LYNDON - DERBY
 PROJECT NUMBER: IM CULV (19)

FILE NAME: headwall84-derby.dgn
 PROJECT LEADER: DMB
 DESIGNED BY: LKW
 HEADWALL DETAILS - DERBY III-I

PLOT DATE: 24-AUG-2009
 DRAWN BY: SLM
 CHECKED BY: WLD
 SHEET 26 OF 28

