



DETAIL OF PARTIAL PARABOLIC CROWN OF SLAB

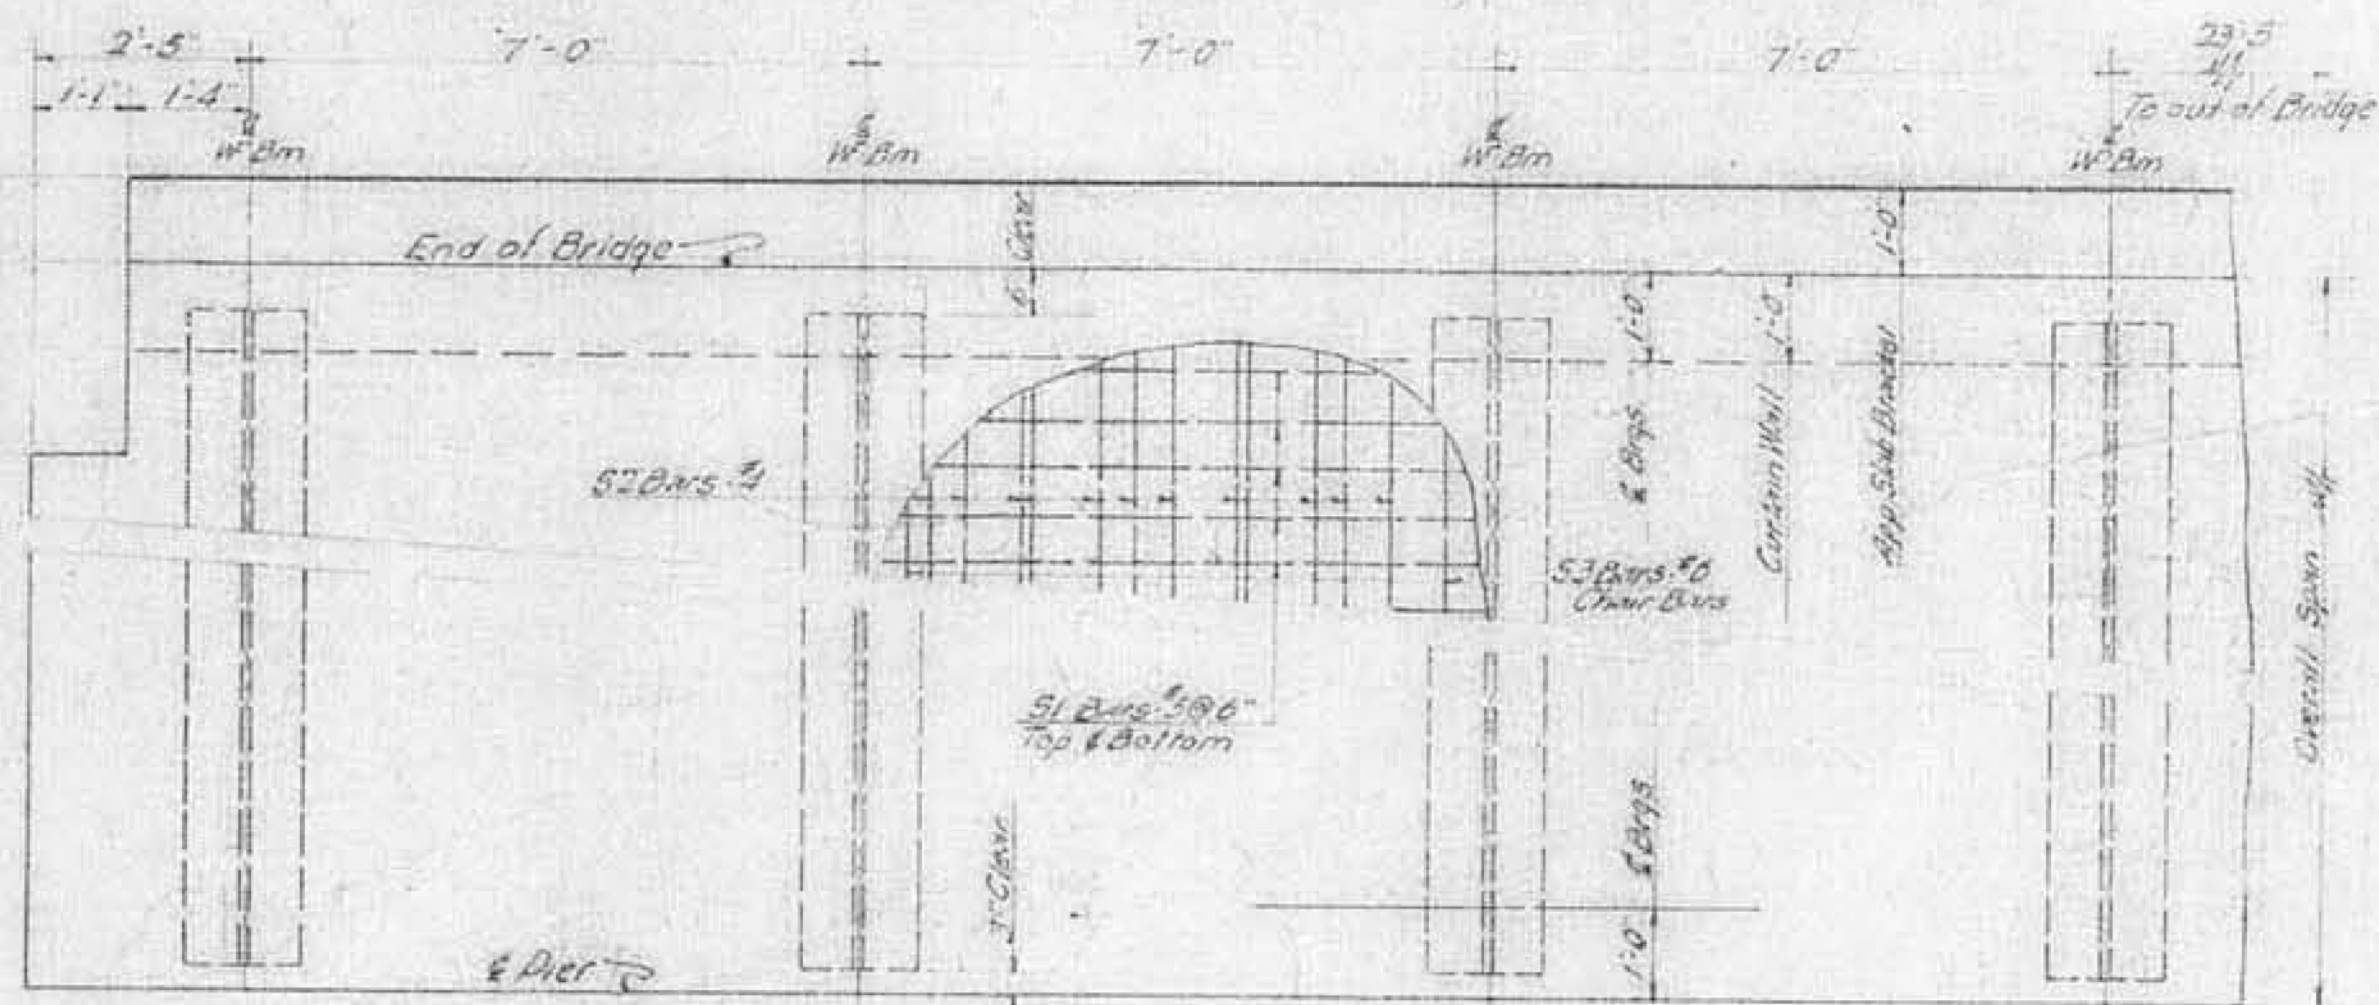

PARTIAL PLAN

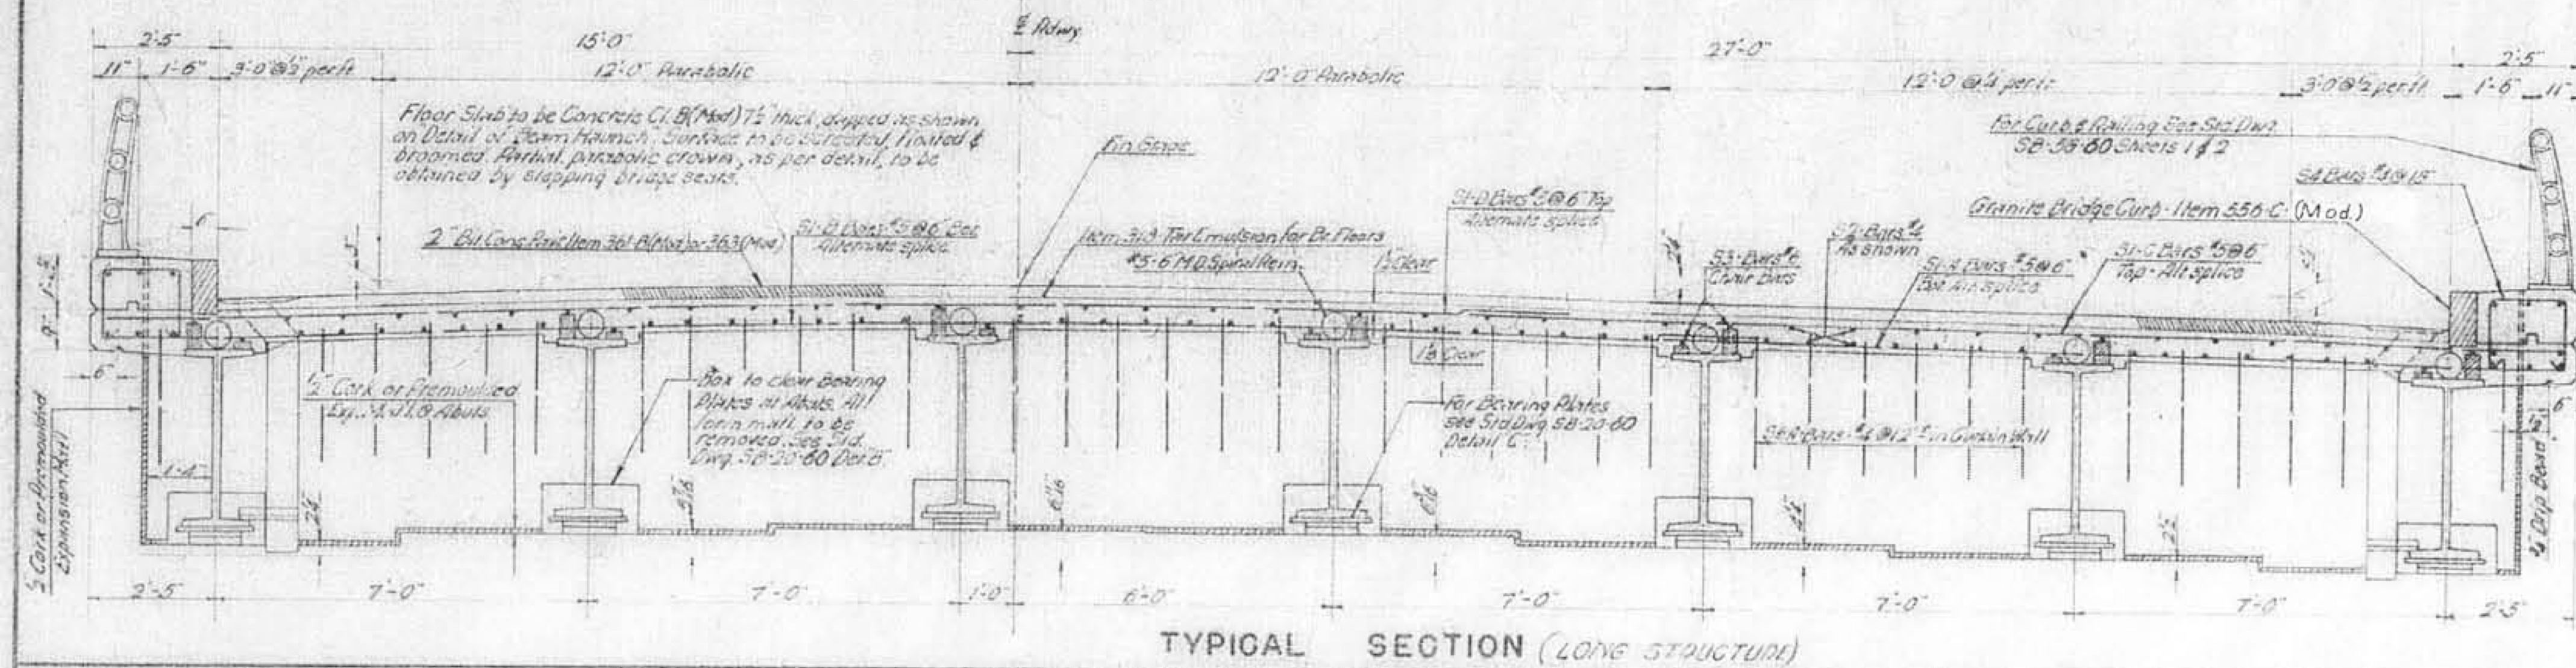

TYPICAL SECTION (LONG STRUCTURE)

TABLE OF QUANTITIES FOR SINGLE (SQUARE) SPAN													
Span - Out to Out	44'-0"	46'-0"	48'-0"	50'-0"	52'-0"	54'-0"	56'-0"	58'-0"	60'-0"	62'-0"	64'-0"	66'-0"	68'-0"
Span - E to E Bearings	47'-0"	49'-0"	51'-0"	53'-0"	55'-0"	57'-0"	59'-0"	61'-0"	63'-0"	65'-0"	67'-0"	69'-0"	71'-0"
Length of Beams	98'-0"	102'-0"	106'-0"	110'-0"	114'-0"	118'-0"	122'-0"	126'-0"	130'-0"	134'-0"	138'-0"	142'-0"	146'-0"
Size W Beams	36W 300	36W 300	36W 300	36W 245	36W 184	36W 170	36W 160	36W 150	36W 150	36W 150	36W 150	36W 150	36W 116
Lgth. & Size Bot. Cover R.	68'-0"	72'-0"	76'-0"	80'-0"	84'-0"	88'-0"	92'-0"	96'-0"	100'-0"	104'-0"	108'-0"	112'-0"	116'-0"
Lgth. & Size Top Cover R.	68'-0"	72'-0"	76'-0"	80'-0"	84'-0"	88'-0"	92'-0"	96'-0"	100'-0"	104'-0"	108'-0"	112'-0"	116'-0"
Dead Load Deflection	3	24	28	22	18	15	14	1	7 1/2	5 1/2	5	3 1/2	4
Diameter of Spiral Bars													
Main Diameter of Spiral													Non Composite
Spiral Pitch, 0'-10" From Brng.	Double #5	Double #5	Double #6	Double #5 1/2	Double #5	Double #5	Double #5	Double #5	Double #5	Double #5	Double #5	Double #5	Double #5
10'-20" or E Span	Double #6 1/2	Double #6 1/2	Double #7	Double #6 1/2	Double #6	Double #6 1/2	Double #6 1/2	Double #6 1/2	Double #6 1/2	Double #6 1/2	Double #6 1/2	Double #6 1/2	Double #6 1/2
20'-30"	4 1/2	4	4 1/2	4	4 1/2	4 1/2	4 1/2	5	5 1/2	6	6 1/2	6 1/2	6 1/2
30'-40"	5 1/2	5 1/2	5 1/2	5 1/2	6	6	7	7 1/2					
40'-E Span	7	7	8	8									
Lgth. of 2" Studs (All to Spirals)		6 1/2	Long unless otherwise specified	on the Plans	2 Studs required per Pitch								
Total Struct. Steel (1 Span) (lbs)	269,740	237,590	218,700	172,320	138,420	113,910	97,140	82,550	72,740	65,010	58,080	52,730	39,290
Reinforcing Bars - S1-A	198	188	178	168	158	148	138	128	118	108	98	88	78
S1-B	198	188	178	168	158	148	138	128	118	108	98	88	78
S1-C	198	188	178	168	158	148	138	128	118	108	98	88	78
S1-D	198	188	178	168	158	148	138	128	118	108	98	88	78
S2	264	264	264	264	264	264	264	264	264	264	264	264	264
S3	42	42	42	42	42	42	42	42	42	42	42	42	42
S4	128	122	114	108	102	94	88	82	74	68	62	54	48
S5	32	32	32	32	32	32	32	32	32	32	32	32	32
S6A	76	76	76	76	76	76	76	76	76	76	76	76	76
S7	62	62	62	62	62	62	62	62	62	62	62	62	62
Total Weight Reinf. Bars (lbs)	30,140	28,710	27,290	25,860	24,400	22,980	21,530	19,900	18,460	17,030	15,600	14,160	12,710
Approx. Weight Spiral Reinf. (lbs)	3,570	3,530	3,180	3,310	3,250	3,070	2,920	2,740	2,600	2,360	2,170	Non Composite	
Total Concrete Class B (Cords)	151	144	137	131	124	117	110	103	95	89	82	75	67
Total Weight Curved Conc. Pav. (Tons)	59	56	53	50	47	44	41	38	35	32	29	26	23
Tar Emulsion for Bridge Deck (Gals)	185	176	166	157	148	138	129	120	110	101	92	82	73
Approx. Quantity 1/2" 16's Studs	4,150	4,050	3,630	3,000	3,150	3,500	3,300	3,100	3,000	2,700	2,500	Non Composite	

REINFORCING STEEL SCHEDULE

Span	S1-A #5	S1-B #5	S1-C #5	S1-D #5	S2 #5	S3 #5	S4 #5	S5 #5	S6A #5	S7 #5
34	17'-3"	31'-3"	17'-3"	27'-9"	33'-6"	33'-6"	2'-6"	6'-6"	TL 5'-3"	TL 5'-3"
39	20'-9"	31'-3"	20'-9"	27'-9"	20'-6"	20'-6"	2'-9"	7'-0"	B 1'-6"	TL 5'-3"
44	23'-3"	31'-3"	23'-3"	27'-9"	23'-0"	23'-0"	3'-0"	7'-6"	D 1'-6"	A 6
49	25'-3"	31'-3"	25'-3"	27'-9"	25'-6"	25'-6"	3'-0"	7'-6"	C 1'-5"	H 3 I
54	27'-9"	31'-3"	27'-9"	27'-9"	28'-0"	28'-0"	3'-0"	7'-6"	TL 5'-3"	B
59	30'-3"	31'-3"	30'-3"	27'-9"	30'-6"	30'-6"	3'-0"	7'-6"	A 1'-5"	D
64	32'-9"	31'-3"	32'-9"	27'-9"	33'-0"	33'-0"	3'-0"	7'-6"	TL 5'-3"	B
69	34'-3"	31'-3"	34'-3"	27'-9"	34'-6"	34'-6"	3'-2"	7'-10"	TL 5'-3"	C 8
74	36'-0"	31'-3"	36'-0"	27'-9"	36'-3"	36'-3"	3'-2"	7'-10"	S 7 #6	S 6 D #5
79	37'-6"	31'-3"	37'-6"	27'-9"	38'-0"	38'-0"	3'-3"	8'-0"	TL 3'-0"	TL 4'-2"
84	39'-3"	31'-3"	39'-3"	27'-9"	39'-6"	39'-6"	3'-3"	8'-0"	B 1'-8"	B 2'-6"
89	41'-0"	31'-3"	41'-0"	27'-9"	41'-3"	41'-3"	3'-3"	8'-0"	J 6	C 8
94	42'-6"	31'-3"	42'-6"	27'-9"	43'-0"	43'-0"	3'-4"	8'-2"	TL 5'-3"	D 1'-0"
99	44'-3"	31'-3"	44'-3"	27'-9"	44'-6"	44'-6"	3'-4"	8'-2"	A 1'-8"	S 8

Revisions & Corrections  
Changed to 12" curb 9/7/60

Drawn By: A.B.M. 6-17-60  
Traced By: A.B.M. 6-17-60  
Checked By: R.T.B. & R.S.H. July, 1960  
Correct: 13 July 1960  
Approved: 13 July 1960  
Chief Engineer

TYPICAL SECTION, PLAN VIEW, & QUANTITIES  
42 FOOT ROADWAY W/ BEAM BRIDGES

34-44 NON COMPOSITE, 49-99 COMPOSITE  
FOR ADDITIONAL DETAILS SEE STANDARD SCB-D-60

DEPARTMENT OF HIGHWAYS  
STANDARD STRUCTURES

SCB-42-60

RICHMOND  
IM BPNT (3)  
SHEET 15 OF 18  
ALL BRIDGES  
FOR REFERENCE ONLY