


Curve Data
 Δ 65°-08'-15" Lt.
 R 2291.83
 T 1463.95
 L 2605.50
 E 427.92
 Bank $\frac{1}{2}$ " per Ft.

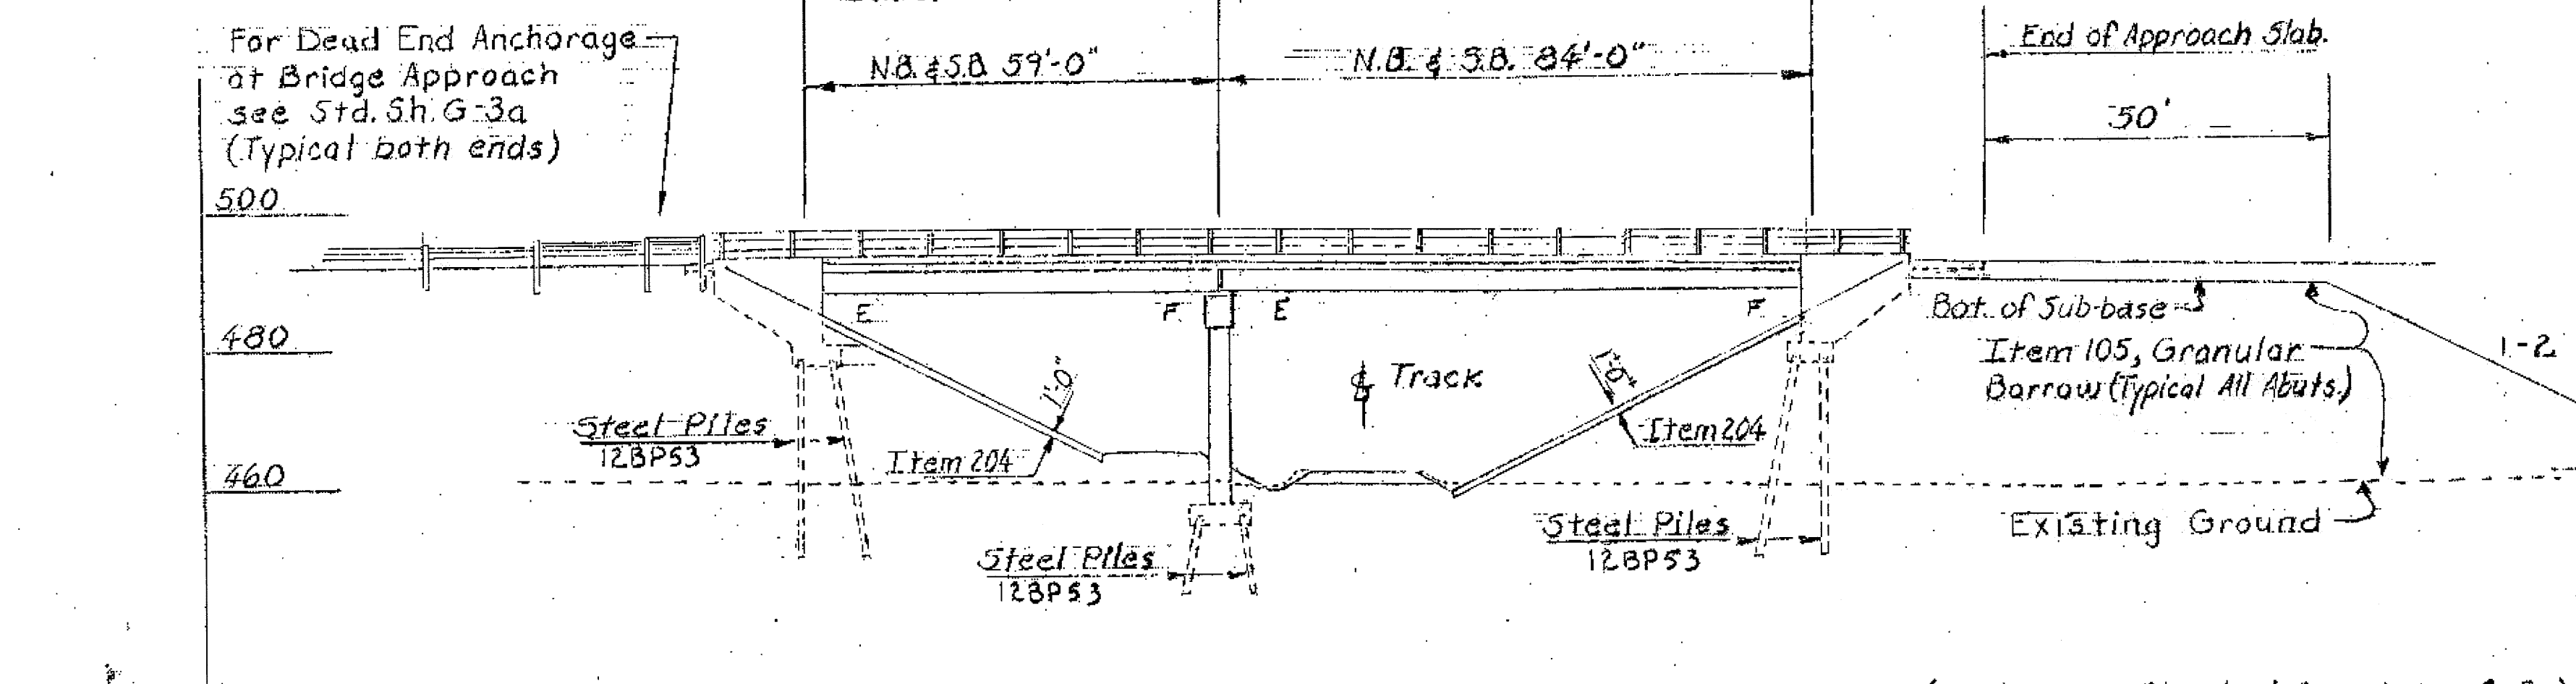

ELEVATION
 Scale: 1" = 20'


7. Anchor Post No. 6 (as shown on Standard Structures G-3a) and necessary hardware to attach to wings of all bridge abutments is to be furnished, installed and paid for at the unit price bid for Item 404-A Structural Steel

- ### LIST OF BRIDGE SHEETS
- BR-400 General Plan and Elevation
 - BR-401 Bridge Quantity Sheet
 - BR-402 Preliminary Information Sheet
 - BR-403 Boring layout
 - BR-404 Boring Logs
 - BR-405 Boring Logs
 - BR-406 Boring Logs
 - BR-407 Framing Plan
 - BR-408 Curb and Railing Plan and Typical Bridge Section
 - BR-409 Details of Abutment No. 1 (Southbound)
 - BR-410 Details of Abutment No. 2 (Southbound)
 - BR-411 Details of Abutment No. 3 (Northbound)
 - BR-412 Details of Abutment No. 4 (Northbound)
 - BR-413 Details of Pier No. 1 & No. 2
 - BR-414 Pier No. 1 & No. 2 Reinforcing Steel Details
 - BR-415 Details of Approach Slab No. 1
 - BR-416 Details of Approach Slab No. 2
 - BR-417 Details of Approach Slab No. 3
 - BR-418 Details of Approach Slab No. 4
 - BR-419 Reinforcing Steel Schedule
 - BR-420 Reinforcing Steel Schedule

- ### STANDARD SHEETS
- SCB-38-65, SCB-D1-65, SCB-D2-65, SCB-D3-65,
 SCB-D4-65, SCB-D5-65, SCB-D6-65 (Det. A, B & F), SCB-D7-65,
 SCB-D8-65, SCB-D9-65 (Det. A), SB-R1-64, Sheets 1 & 2,
 SB-R2-65, G-3a

- ### REFERENCE SHEETS
- Plan I-89 (Scale 1" = 50') Sta. 3572+00 to Sta. 3588+00
 Profile I-89 NB & S.B. Sta. 3572+00 to Sta. 3588+00
 Cross Sections I-89 Sta. 3582+50 to Sta. 3585+0
 Cross Sections C.V. RY. Sta. 18+00 to Sta. 21+50

- ### NOTES
1. For General Notes see Std. Sh. SCB-D1-65.
 2. For Superstructure details see Std. Sh. SCB-38-65 and Typical Bridge Section on Sheet BR-408.
 3. For Details of Dead End Anchorages see Std. Sh. G-3a.
 4. Item 440, Water Repellent, shall consist of furnishing and applying water repellent on exterior concrete surfaces on top of the safety walk, sidewalk, on the fascia and back to the drip bead under the slab, on the sides, ends, and bottoms of all pier caps, and on exposed faces of abutments not otherwise treated.
 5. All 12BP53 Steel Piles shall be driven to the designed bearing capacity of 45 tons per pile. In any case, these piles are to be driven to penetrate into the original ground at least 10 feet. Minimum length of pile is to be 10' below bottom of footing.
 6. Item 505, Pile Loading Tests, to be used only if ordered by the

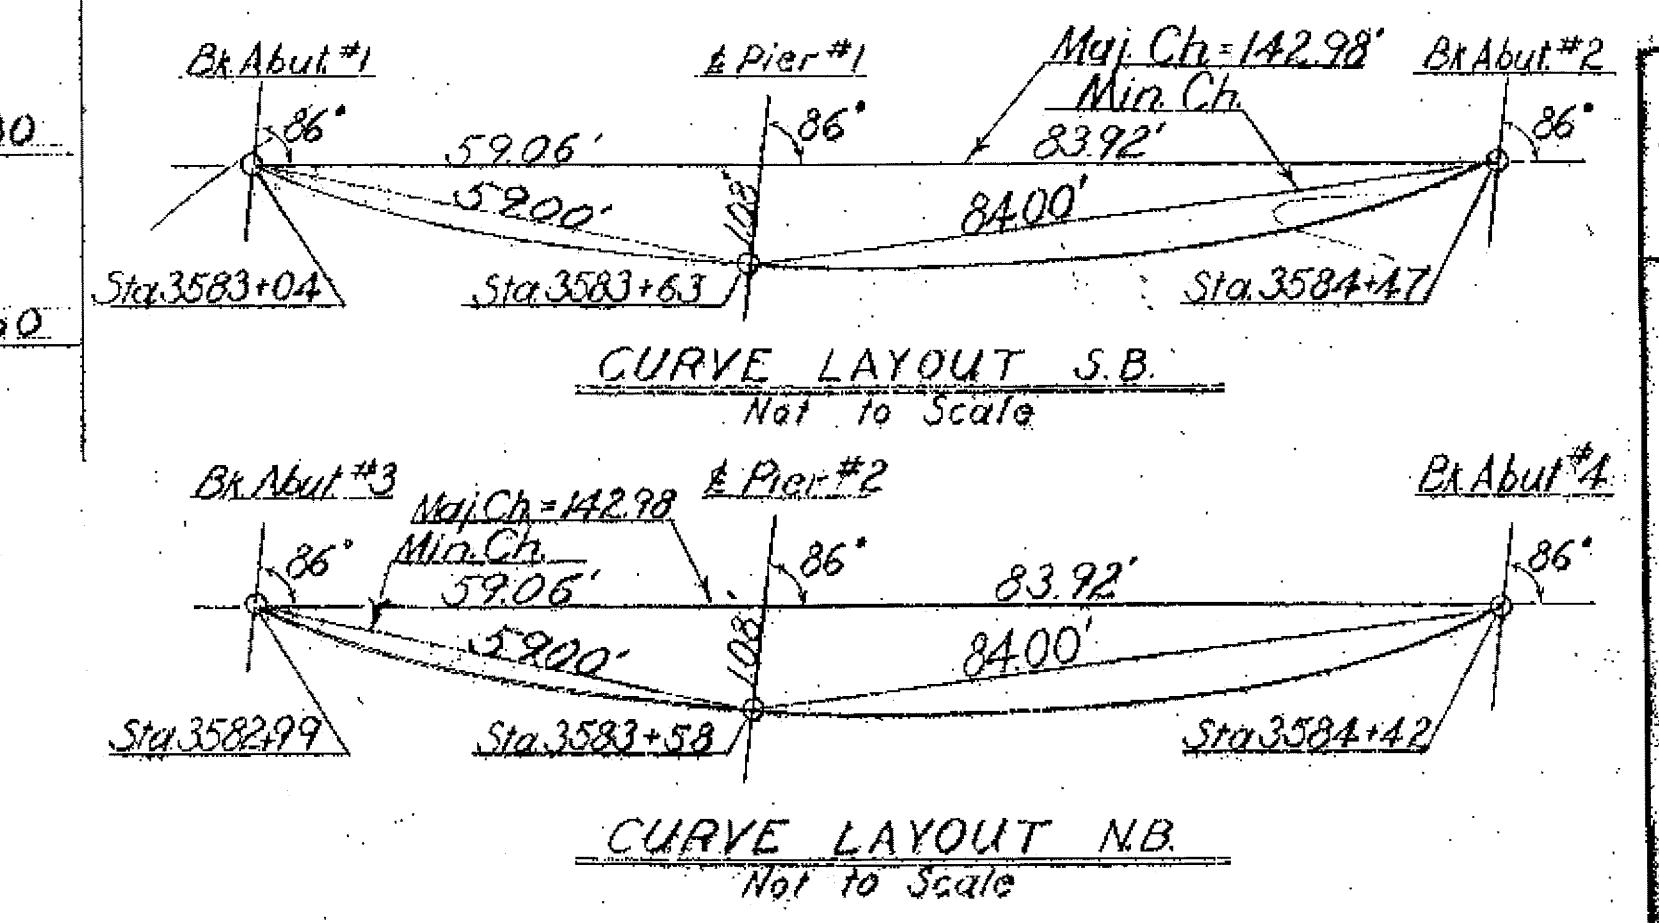

ST. ALBANS - HIGHGATE
 IM BPNT(4)
 SHEET 12 OF 32
 BRIDGE 92N&S
 FOR REFERENCE ONLY

TOWN OF St. Albans - Swanton
 ROUTE No. I-89 LOG. STA. _____
 I-89 over C.V. Ry. @ Sta. 3584+0
 General Plan and Elevation
 Scale - As Noted
 SURVEYED BY _____
 DRAWN BY J.W. CHECKED BY D.H.B.
 PROJECT No. 1873
 SHEET 12 OF 32
 1/53