



FRAMING PLAN

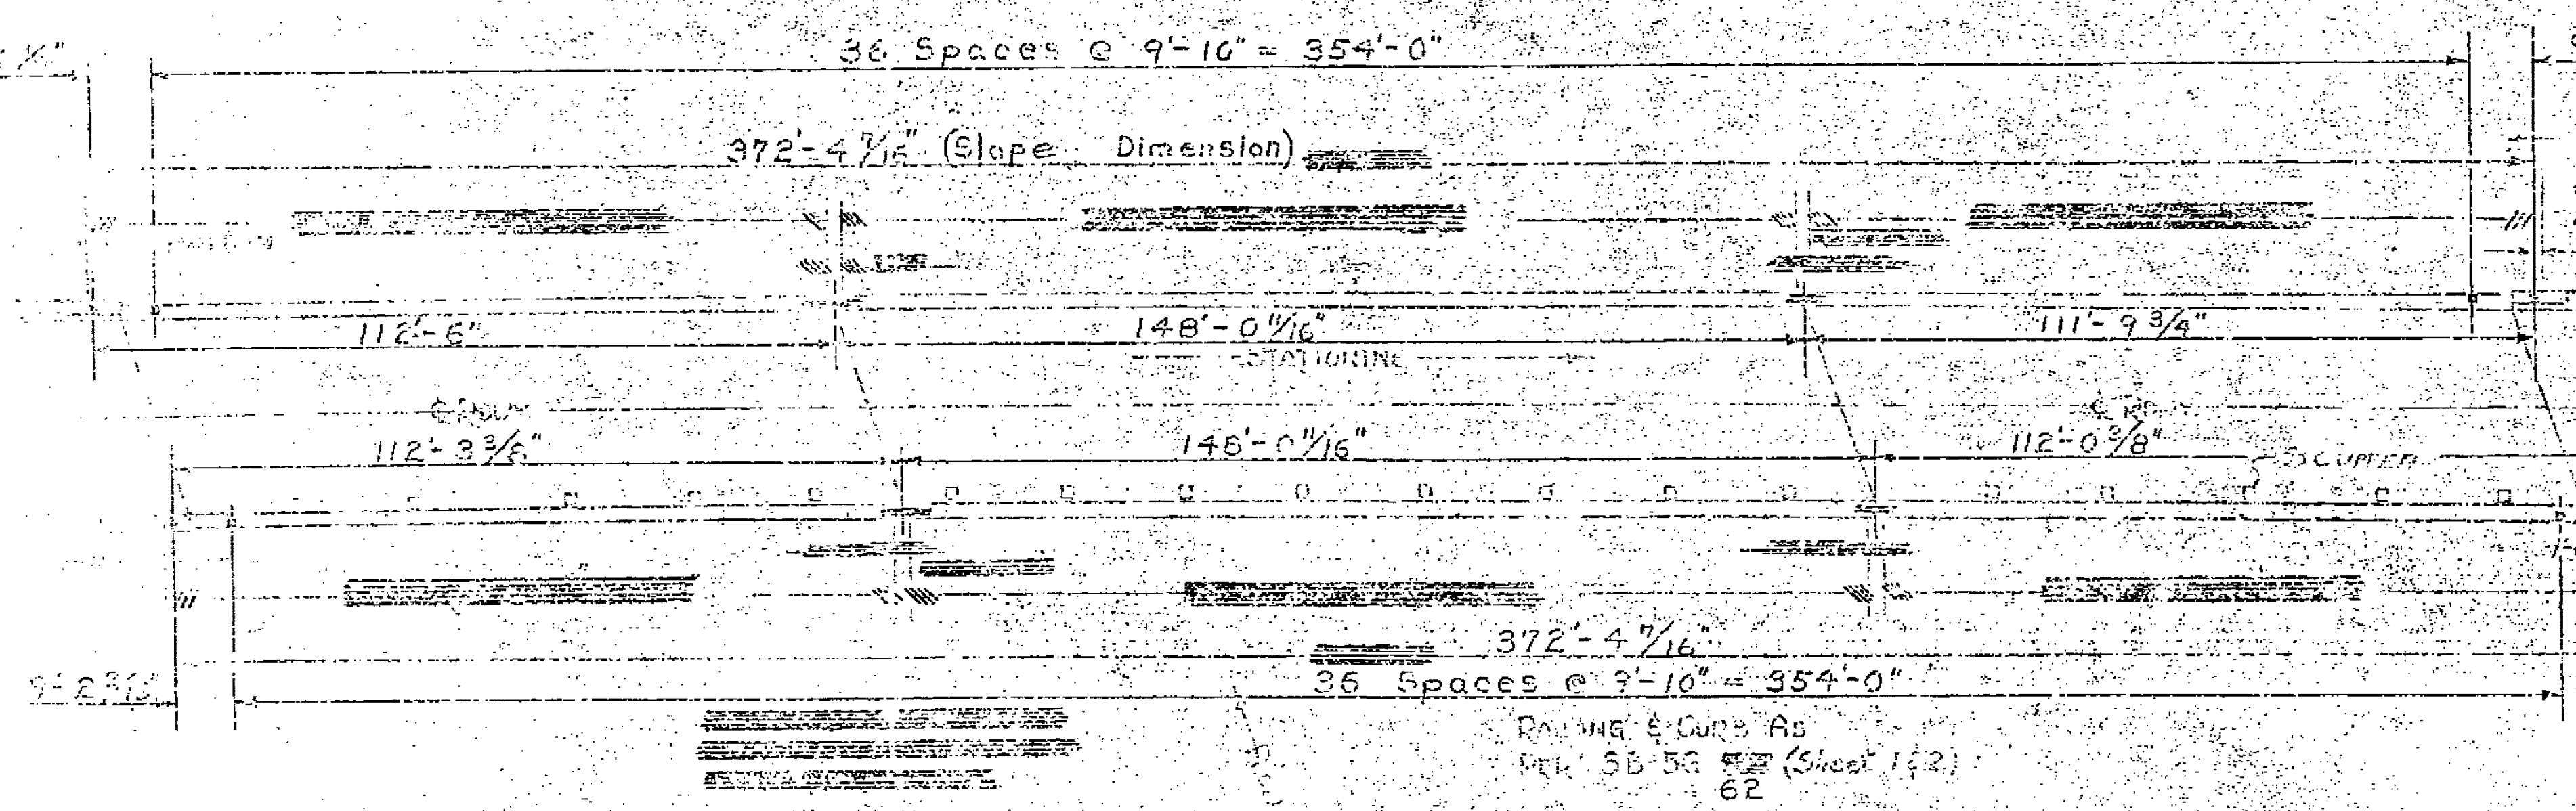

DETAILS OF RAILING SPACING

RAILING SPACING FOR Galvanized Metal
 Railing lengths given are slope dimensions
 * Items to be included in Roadway Quantities:

NO.	ITEM	UNIT	NET	FINAL
* 372-A	Joint Section	LF	100	100
* 373	End Section	LF	100	100

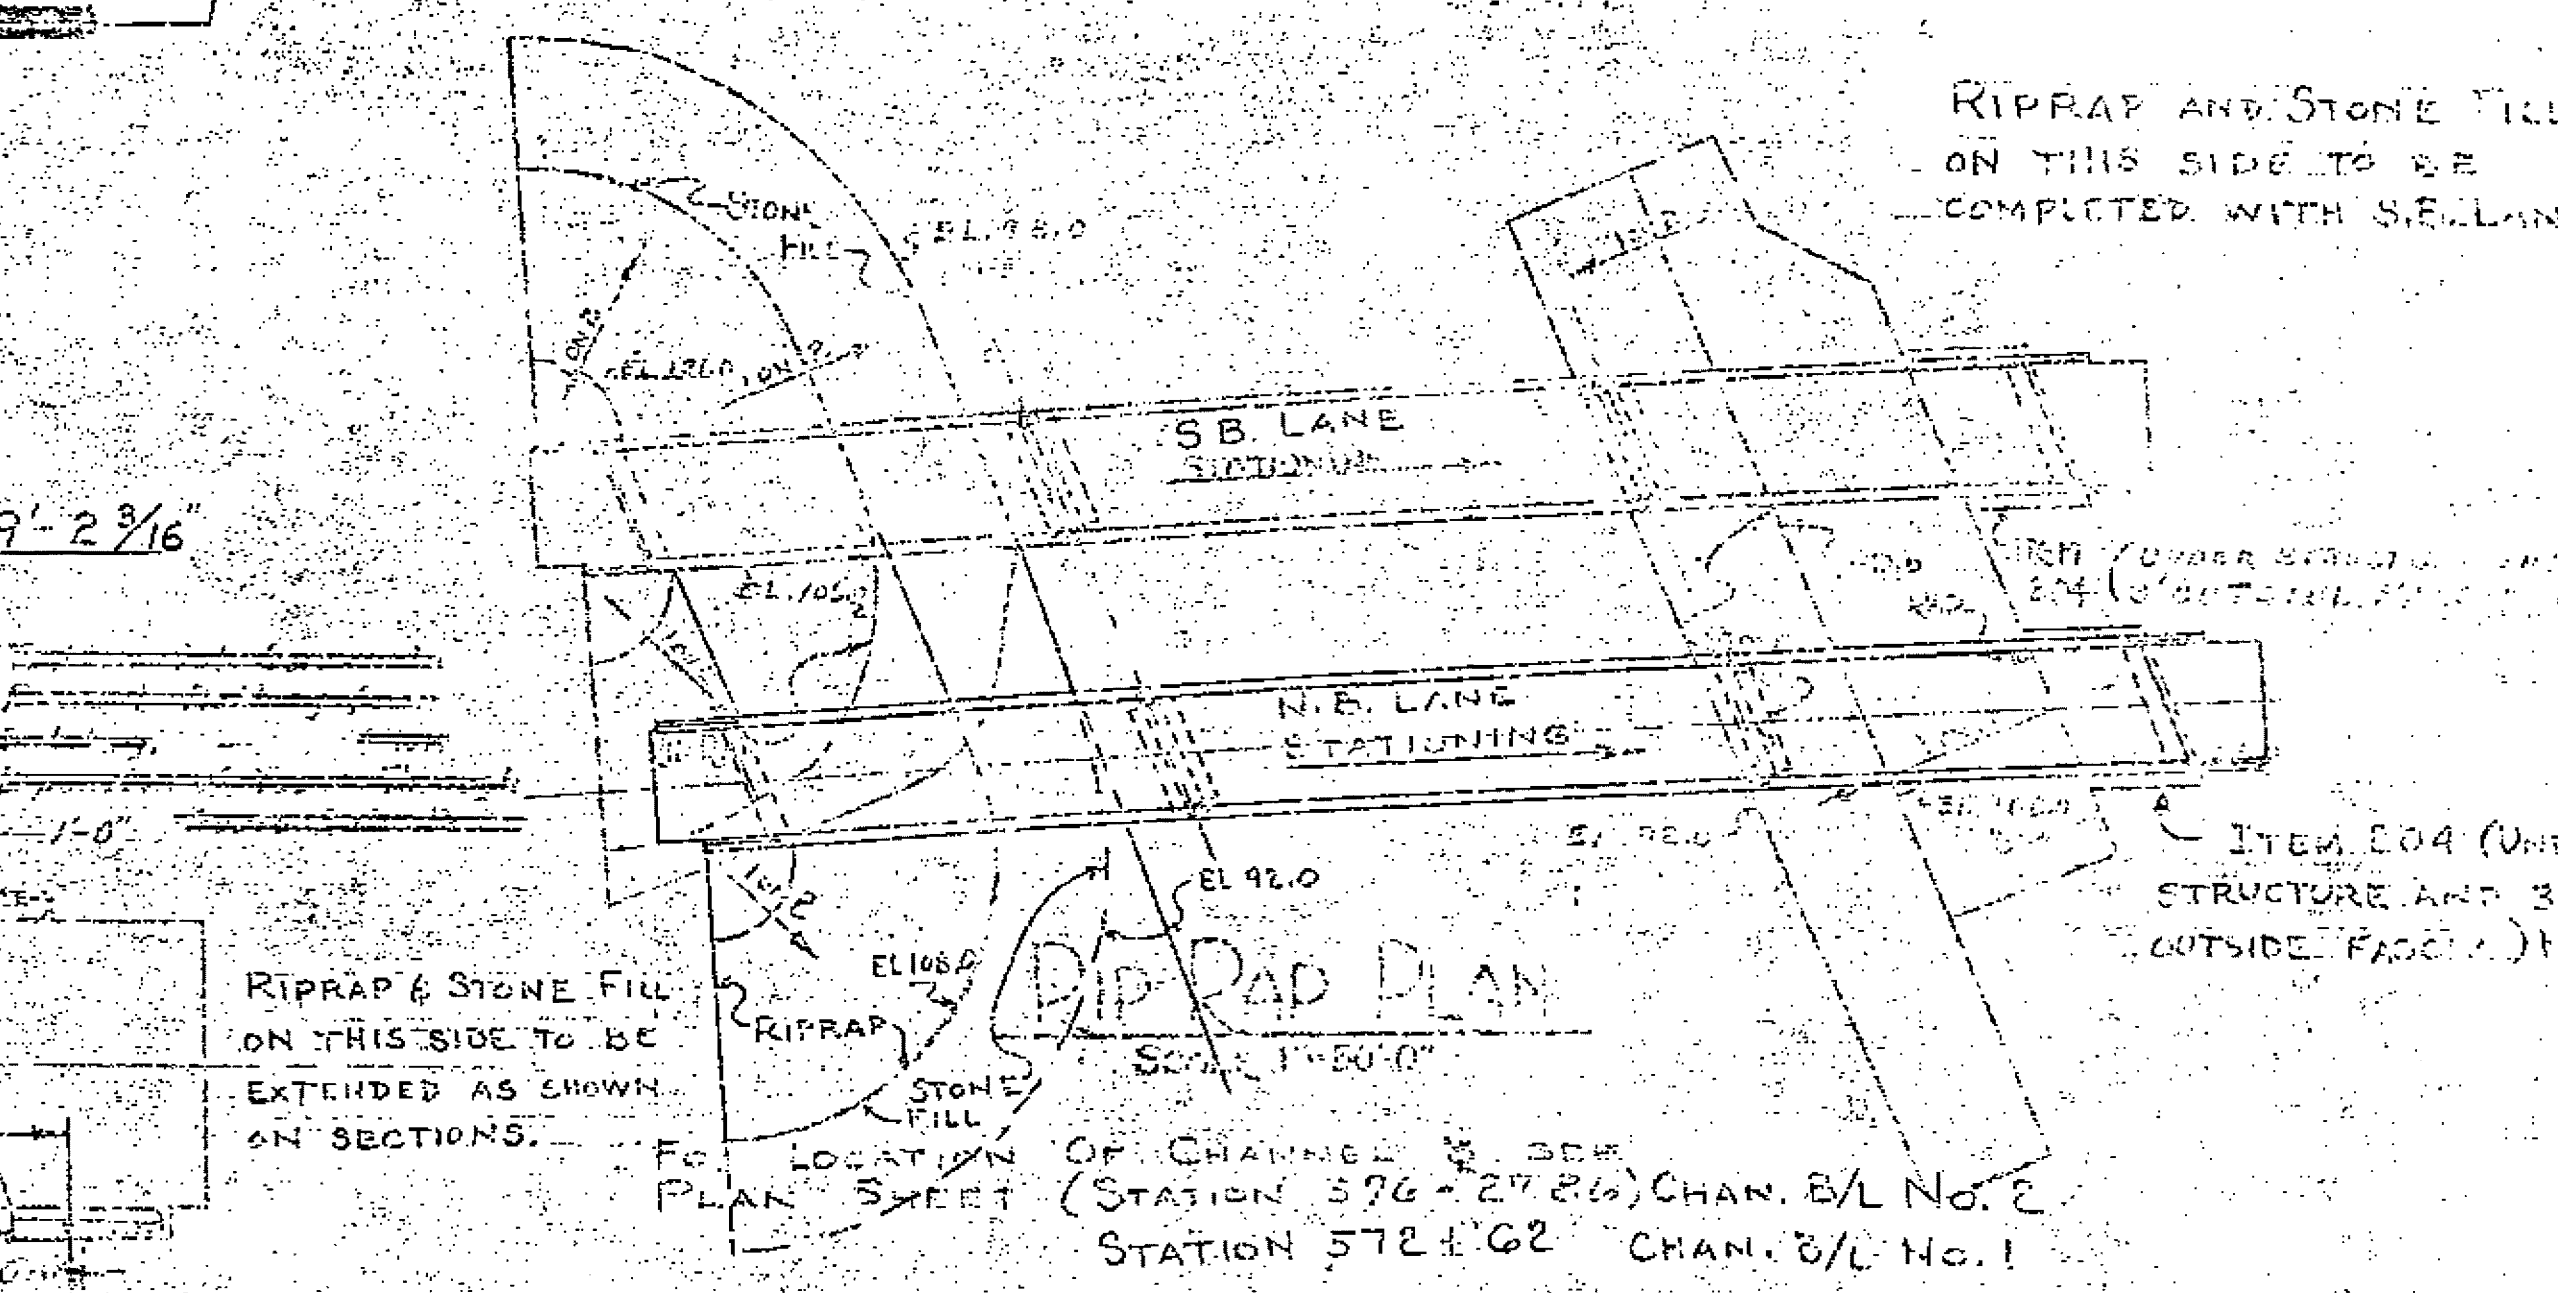

9'-2 1/4" Superstructure Quantities (NB)

ITEM NO.	DESCRIPTION	UNIT	NET	FINAL
100	CONCRETE	CU YD		
101	STEEL	TONS		
102	WOOD	CU YD		
103	GRAVEL	CU YD		
104	STONE	CU YD		

ST. ALBANS - HIGHGATE
 IN BENTON
 SHEET 21 OF 32
 BRIDGE 96N&S
 FOR REFERENCE ONLY

TOWN OF SWANTON
 ROUTE NO. 285
 FRAMING & RAILING PLAN (N)
 MASSACHUSETTS HIGHWAY BOARD
 SCALE: AS SHOWN
 DATE: 1/27/2011
 DRAWN BY: [Name]
 CHECKED BY: [Name]

BR 96
 N&S