


**STEEL FRAMING PLAN**  
 ALL DIMENSIONS ARE HORIZONTAL  
 INT DIAPHRAGMS TO BE 18C42.7 (MARKED 4D3)  
 END DIAPHRAGMS AT PIERS TO  
 BE 18C42.7

*OFFICE COPY*

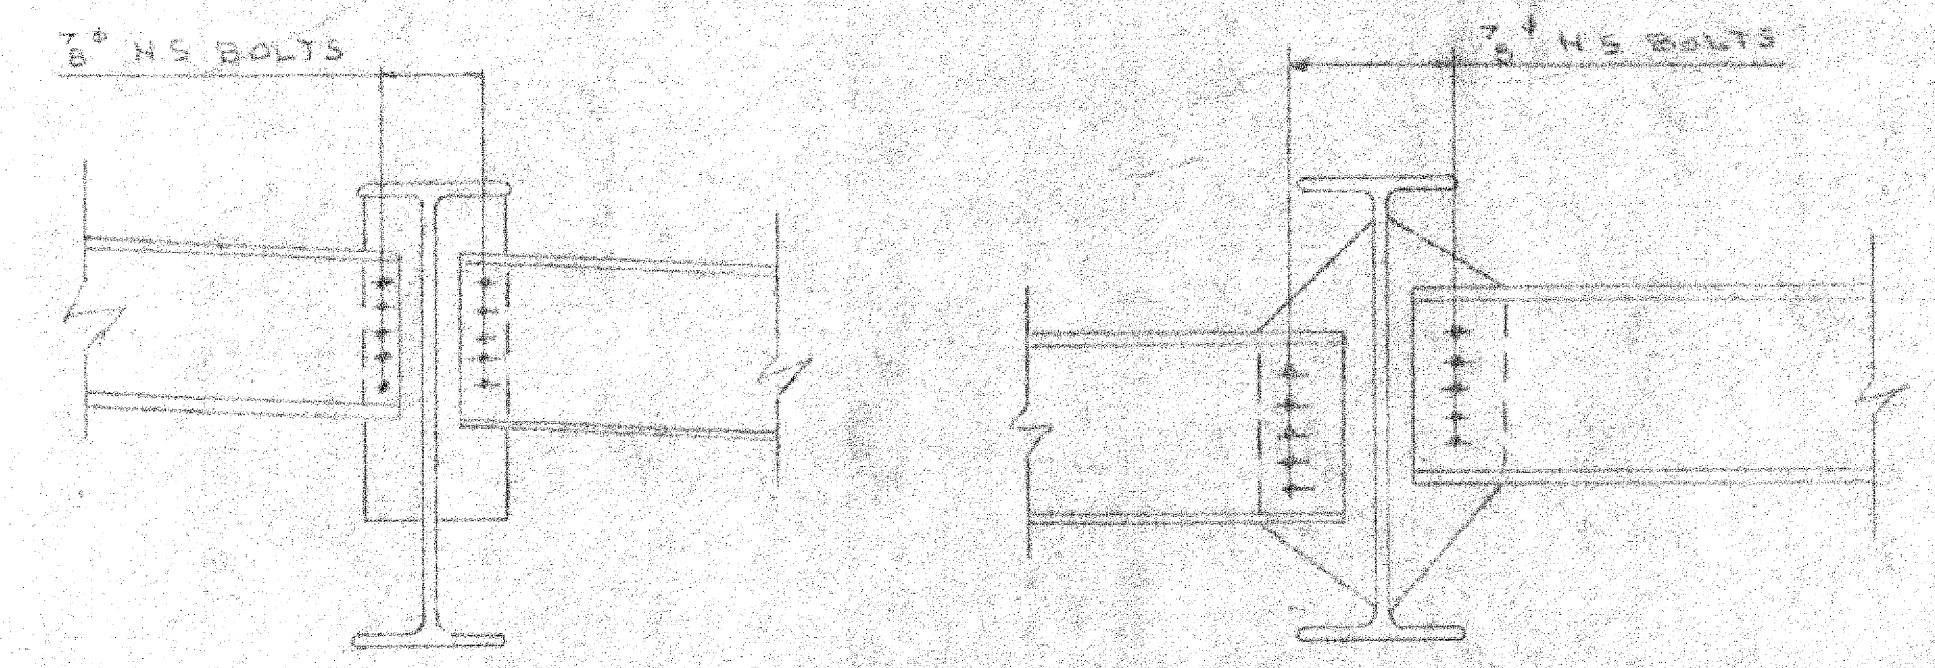

**NOTE:**  
 FOR METHOD OF TIGHTENING  
 HIGH STRENGTH BOLTS & FOR  
 TORQUE TENSION REQUIRED  
 SEE A325 SPECS.

*OKI  
 E.F.P. 7/1/63*

**END DIAPHRAGMS**                      **INTERMEDIATE DIAPHRAGMS**

**FIELD CONNECTIONS**

ST. ALBANS - HIGHGATE  
 IM BPNT(4)  
 SHEET 25 OF 32  
 BRIDGE 97N&S  
 FOR REFERENCE ONLY

PROJECT NO. I 89-3 (7) CONT. 1

CITY IRON WORKS A DIVISION OF TRANS-UNITED INDUSTRIES, INC. P. O. BOX 147 WETHERSFIELD, CONN.	
BOLTS	INTERSTATE ROUTE 8 <sup>th</sup> OVER ST. ALBANS RAILROAD, SOUTHBOUND LANE
OPEN HOLES	SWANTON - HIGHGATE VERNONT
PAINT	NAME BY: <i>[Signature]</i> CHECKED BY: <i>[Signature]</i> DATE: 7/1/63
REVISIONS	
	S.O. 1529 B
	SHEET NO. E2