


- NB RAMP B TYPE II WHITE 5
TYPE I YELLOW 6
TYPE I WHITE 15/26
DELIN W/ FLEX POST 12
- NB RAMP A TYPE I YELLOW 12
TYPE II WHITE 13/25
- SB RAMP D TYPE II WHITE 7
TYPE I YELLOW 8
TYPE III Y W RB 4
TYPE III W/ RB 4
- SB RAMP C TYPE I YELLOW 8
TYPE I WHITE 10
TYPE II WHITE 9

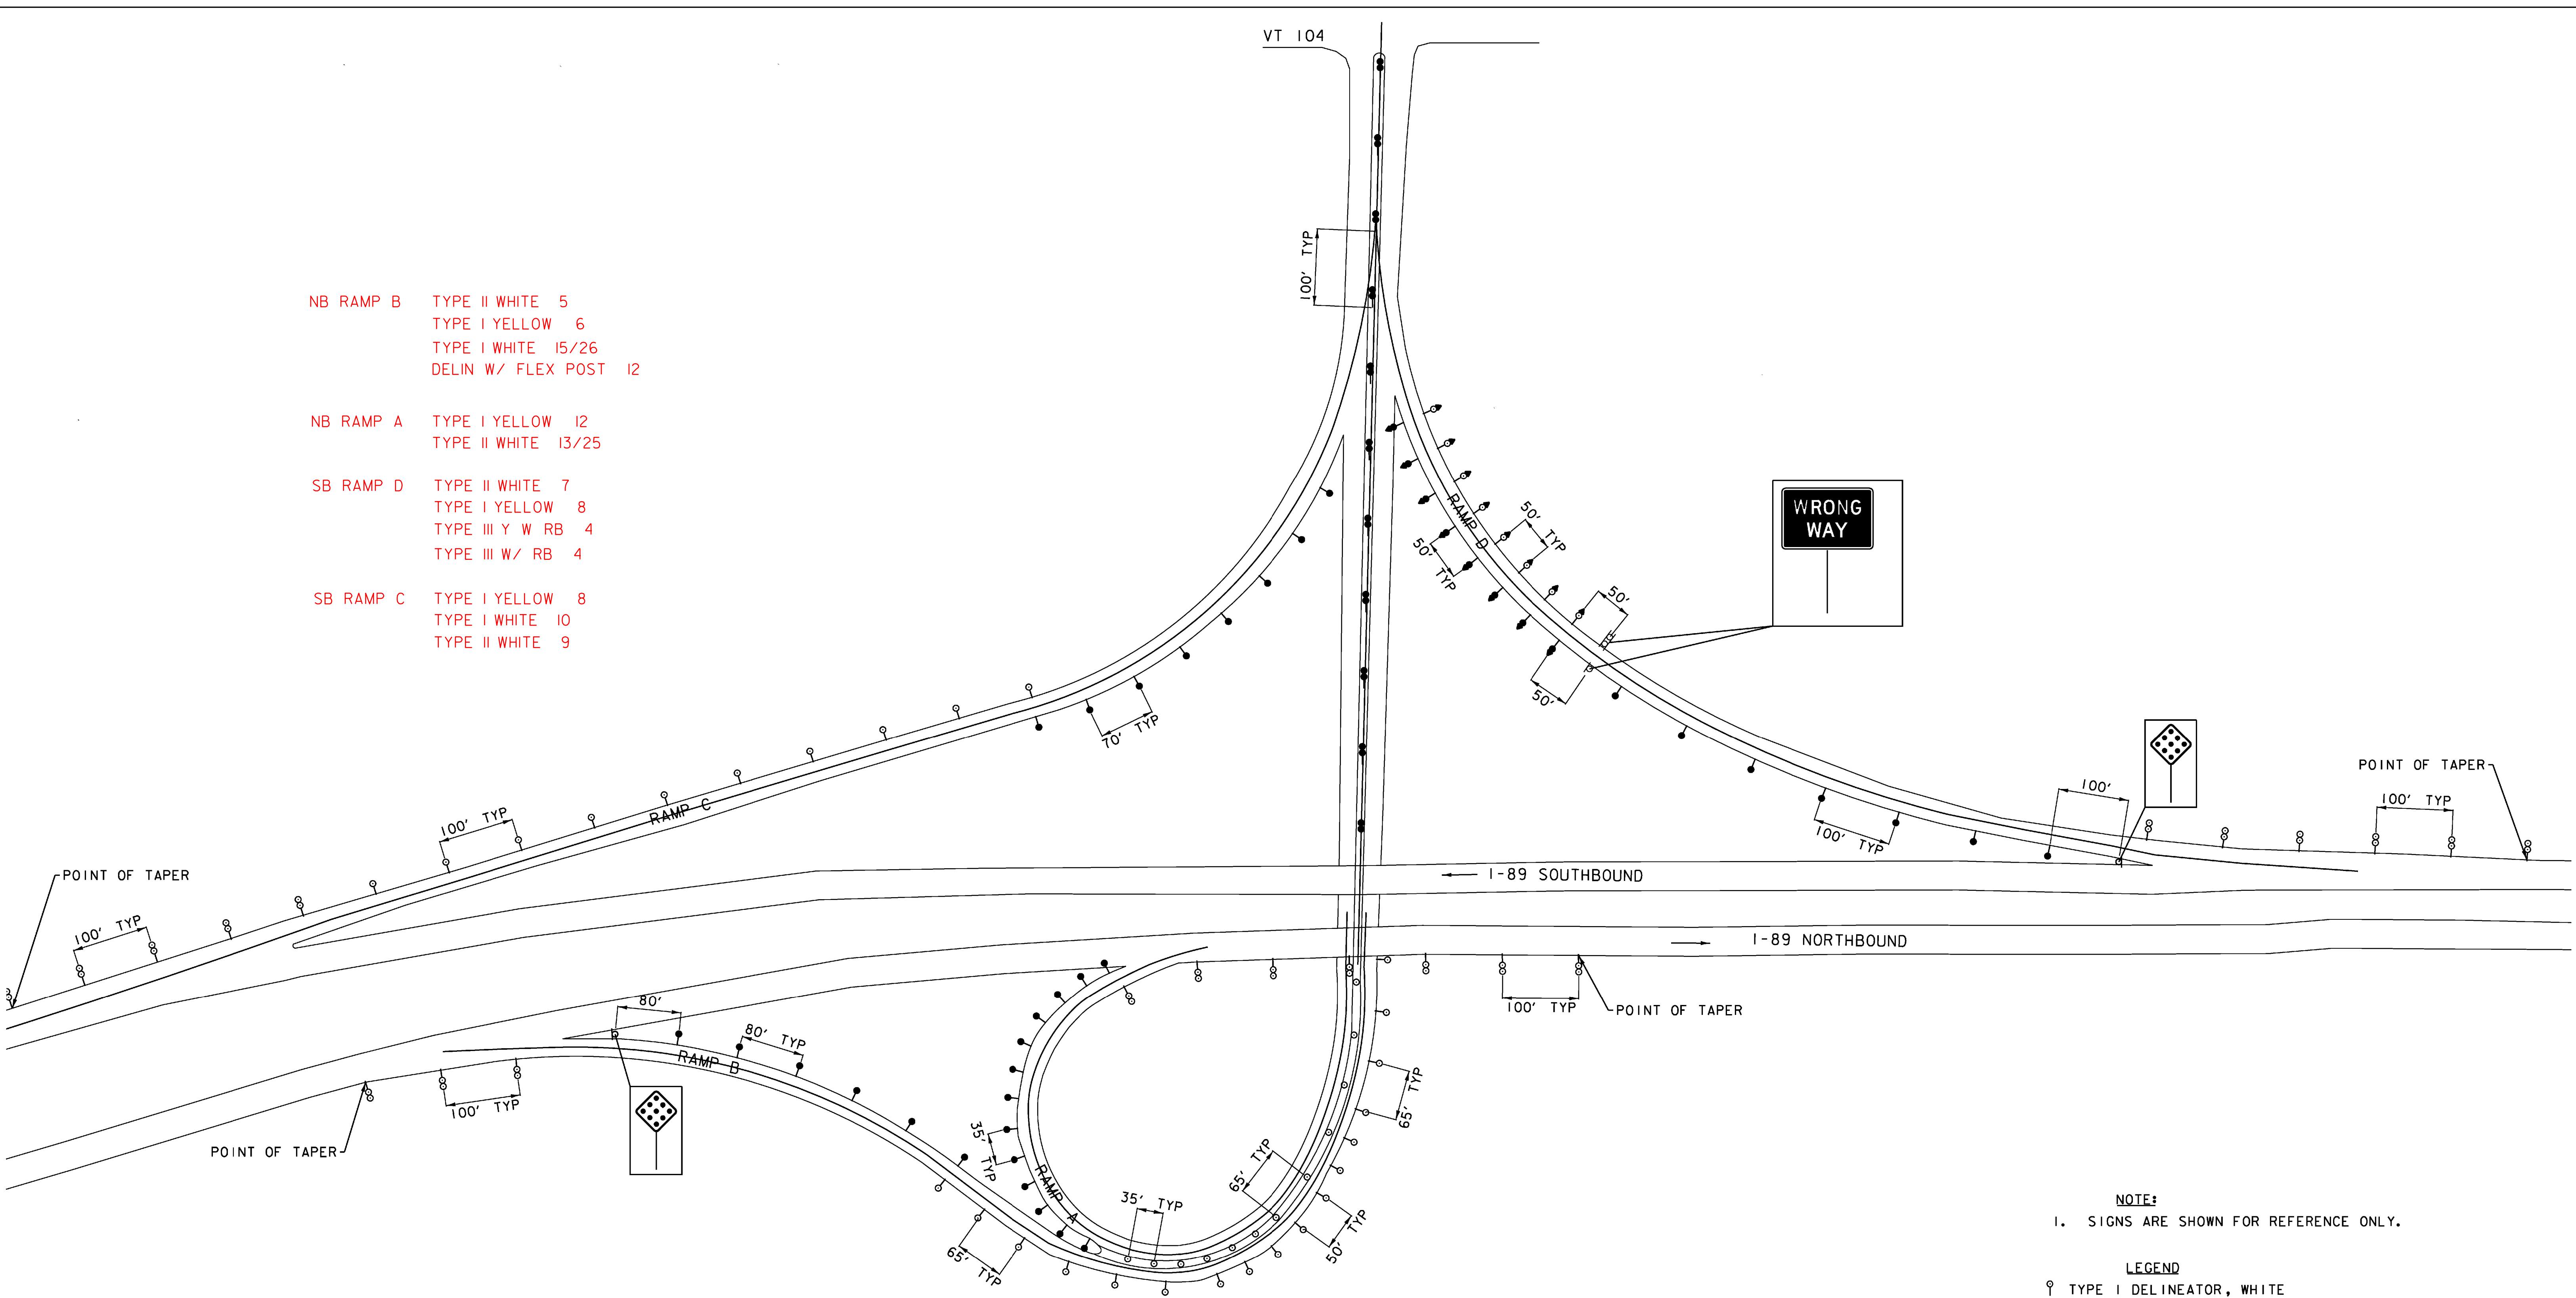

NOTE:
I. SIGNS ARE SHOWN FOR REFERENCE ONLY.

LEGEND

- TYPE I DELINEATOR, WHITE
- TYPE I DELINEATOR, YELLOW
- ⊗ TYPE II DELINEATOR, WHITE
- ⊙ TYPE III DELINEATOR, WHITE FRONT / RED BACK
- ⊕ TYPE III DELINEATOR, YELLOW FRONT / RED BACK
- ⊖ TYPE III DELINEATOR, YELLOW BACK TO BACK
- ⦿ DELINEATOR WITH FLEXIBLE POST, YELLOW BACK TO BACK

| | | |
|---|-----------------------------------|----------------------|
| INTERCHANGE 19 DELINEATOR LAYOUT | PROJECT NAME: COLCHESTER-HIGHGATE | |
| | PROJECT NUMBER: IMG SIGN (17) | |
| | FILE NAME: 09A016.DGN | PLOT DATE: 8/21/2009 |
| | DESIGNED BY: BMB | CHECKED BY: EPD |
| | PLOT FILE: 09A01619DL.I | SHEET 19 OF 221 |