


SB RAMP A TYPE II WHITE 7
 TYPE I WHITE 5
 TYPE III WHITE/ R BACK 4
 TYPE III YELLOW/ R BACK 4

SB RAMP C TYPE I WHITE 7
 TYPE II WHITE 12

NB RAMP D TYPE II WHITE 7
 TYPE I WHITE 4
 TYPE III YELLOW/ R BACK 4
 TYPE III WHITE/ R BACK 4

NB RAMP B TYPE I WHITE 7
 TYPE II WHITE 8

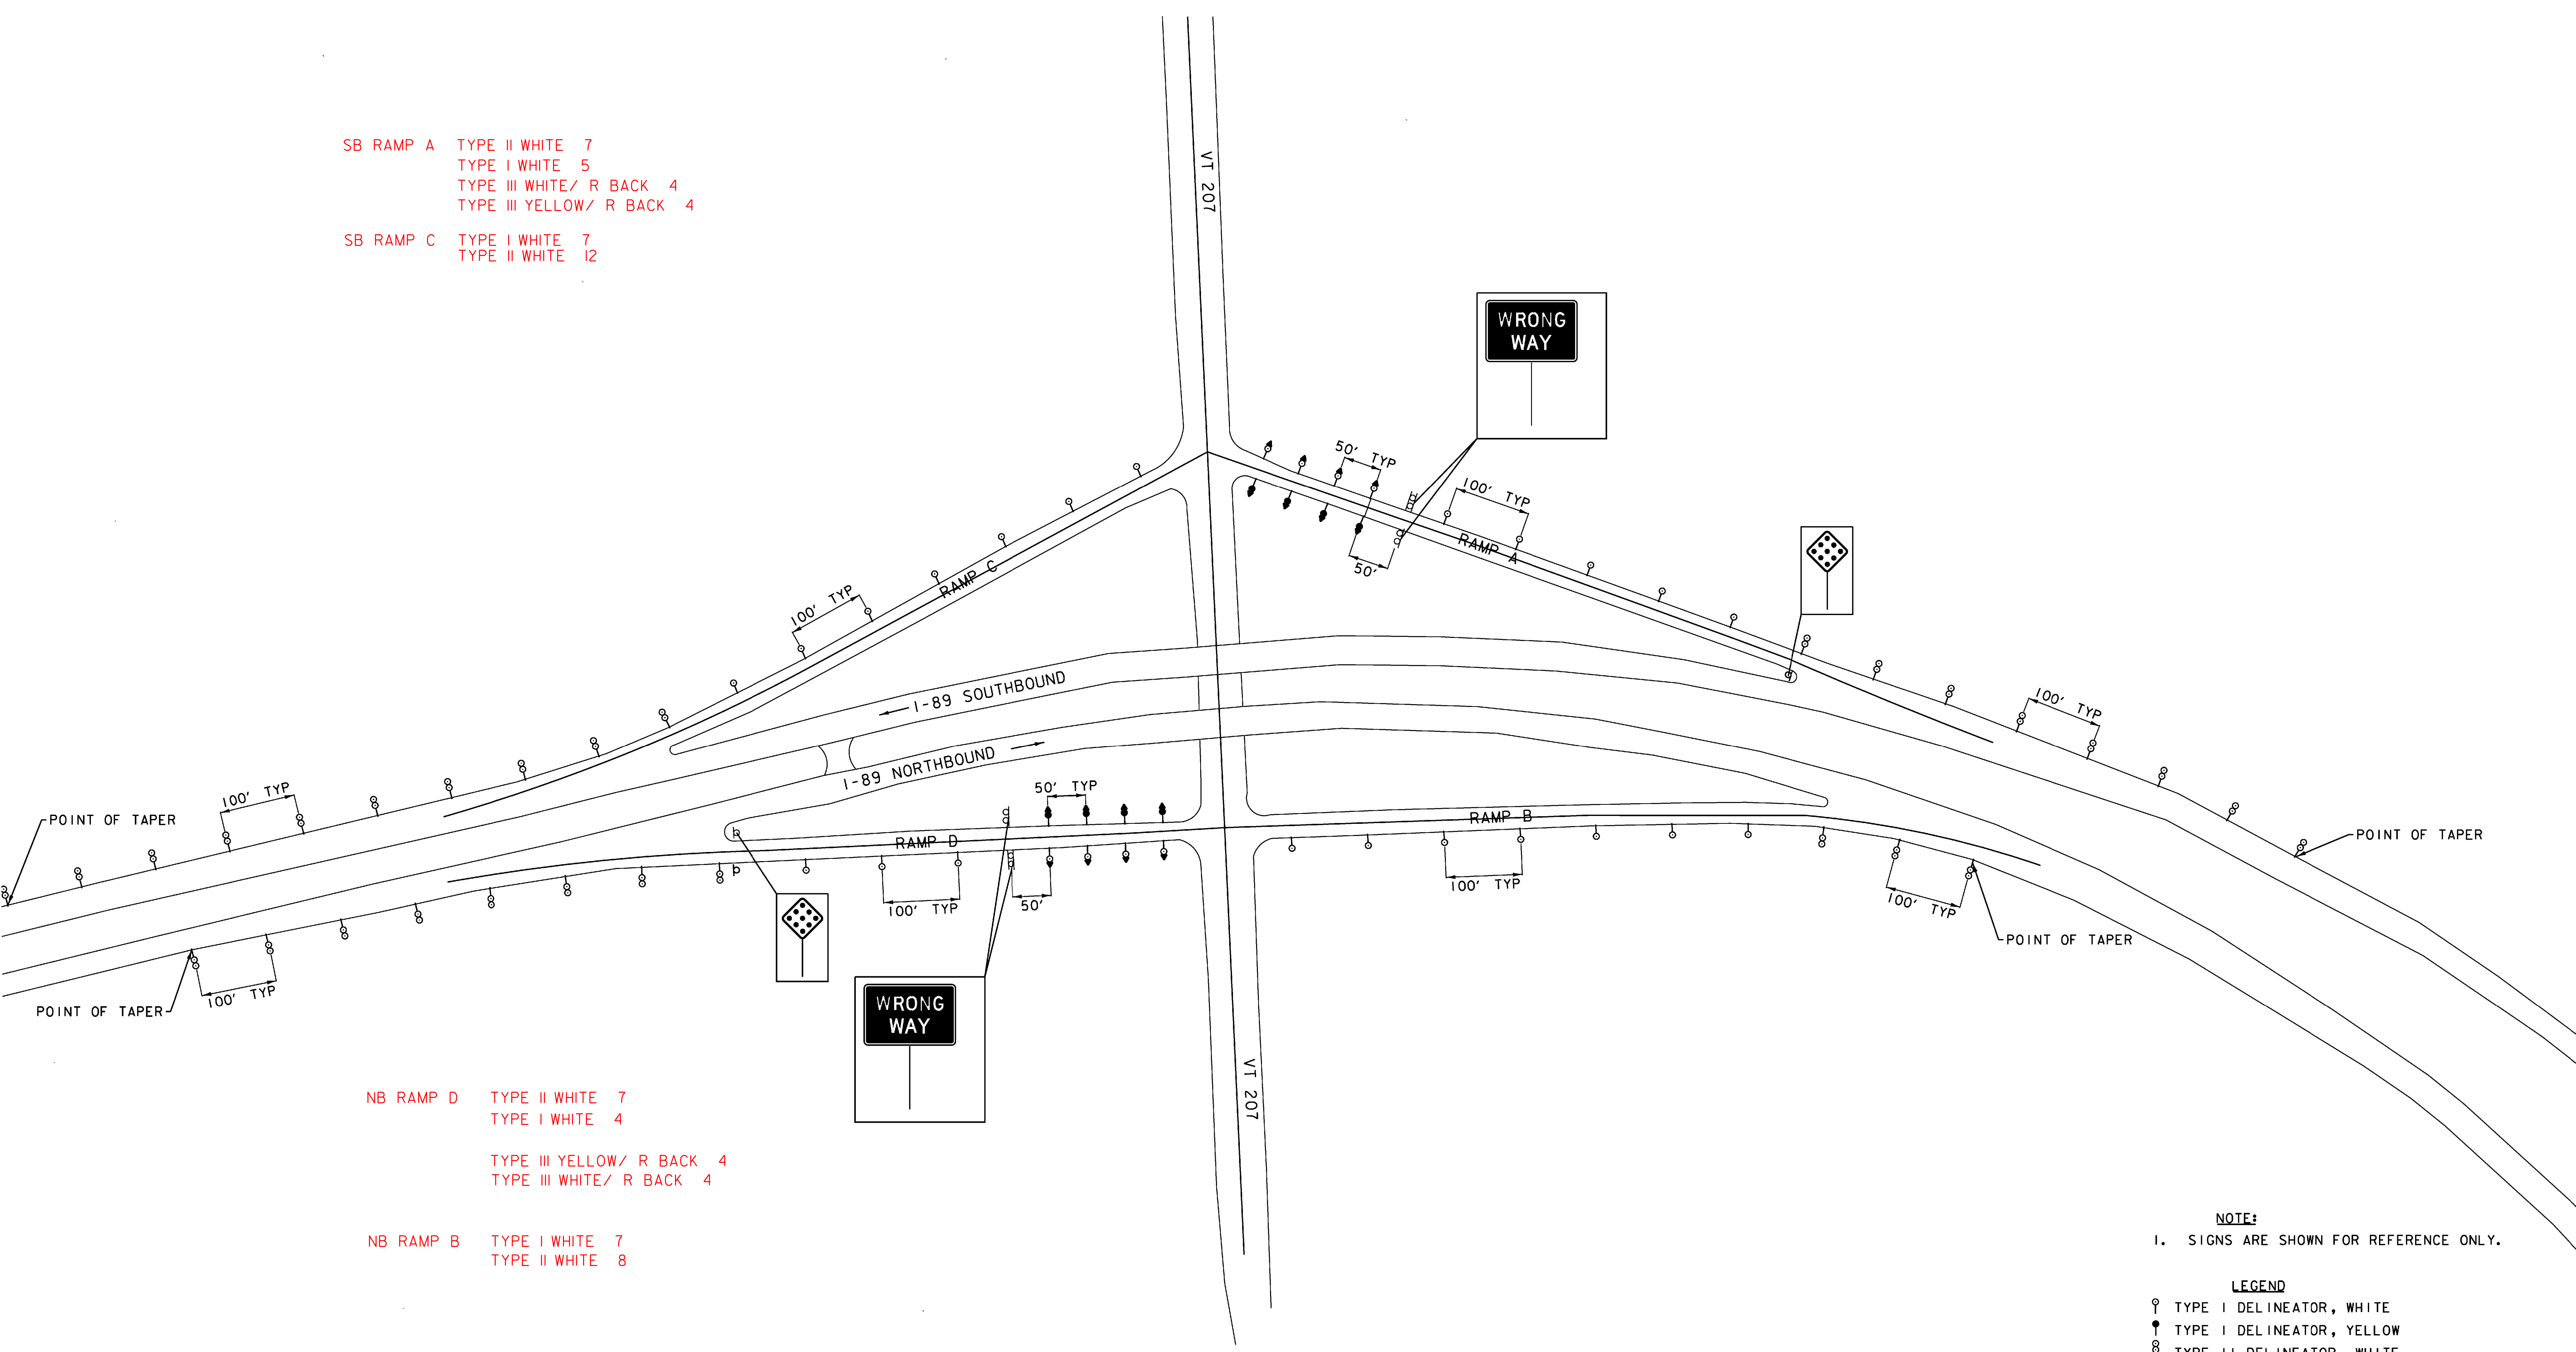

NOTE:
 I. SIGNS ARE SHOWN FOR REFERENCE ONLY.

- LEGEND**
- TYPE I DELINEATOR, WHITE
 - ▲ TYPE I DELINEATOR, YELLOW
 - ⊗ TYPE II DELINEATOR, WHITE
 - ⊙ TYPE III DELINEATOR, WHITE FRONT / RED BACK
 - ⦿ TYPE III DELINEATOR, YELLOW FRONT / RED BACK

**INTERCHANGE 20
 DELINEATOR
 LAYOUT**

PROJECT NAME: COLCHESTER-HIGHGATE	PROJECT NUMBER: IMG SIGN (17)
FILE NAME: 09A016.DGN	PLOT DATE: 8/21/2009
PROJECT LEADER: EPD	DRAWN BY: BMB
DESIGNED BY: BMB	CHECKED BY: EPD
PLOT FILE: 09A016I20DL.I	SHEET 20 OF 22I