


SB RAMP B TYPE III WHITE 5
 TYPE I WHITE 5
 TYPE III WHITE R BACK 5
 TYPE III YELLOW R BACK 5

SB RAMP A TYPE I WHITE 6
 TYPE II WHITE 12

NB RAMP C TYPE II WHITE 7
 TYPE I WHITE 3
 TYPE III WHITE R/BACK 4
 TYPE III YELLOW R/BACK 4

NB RAMP D TYPE I WHITE 6
 TYPE II WHITE 12

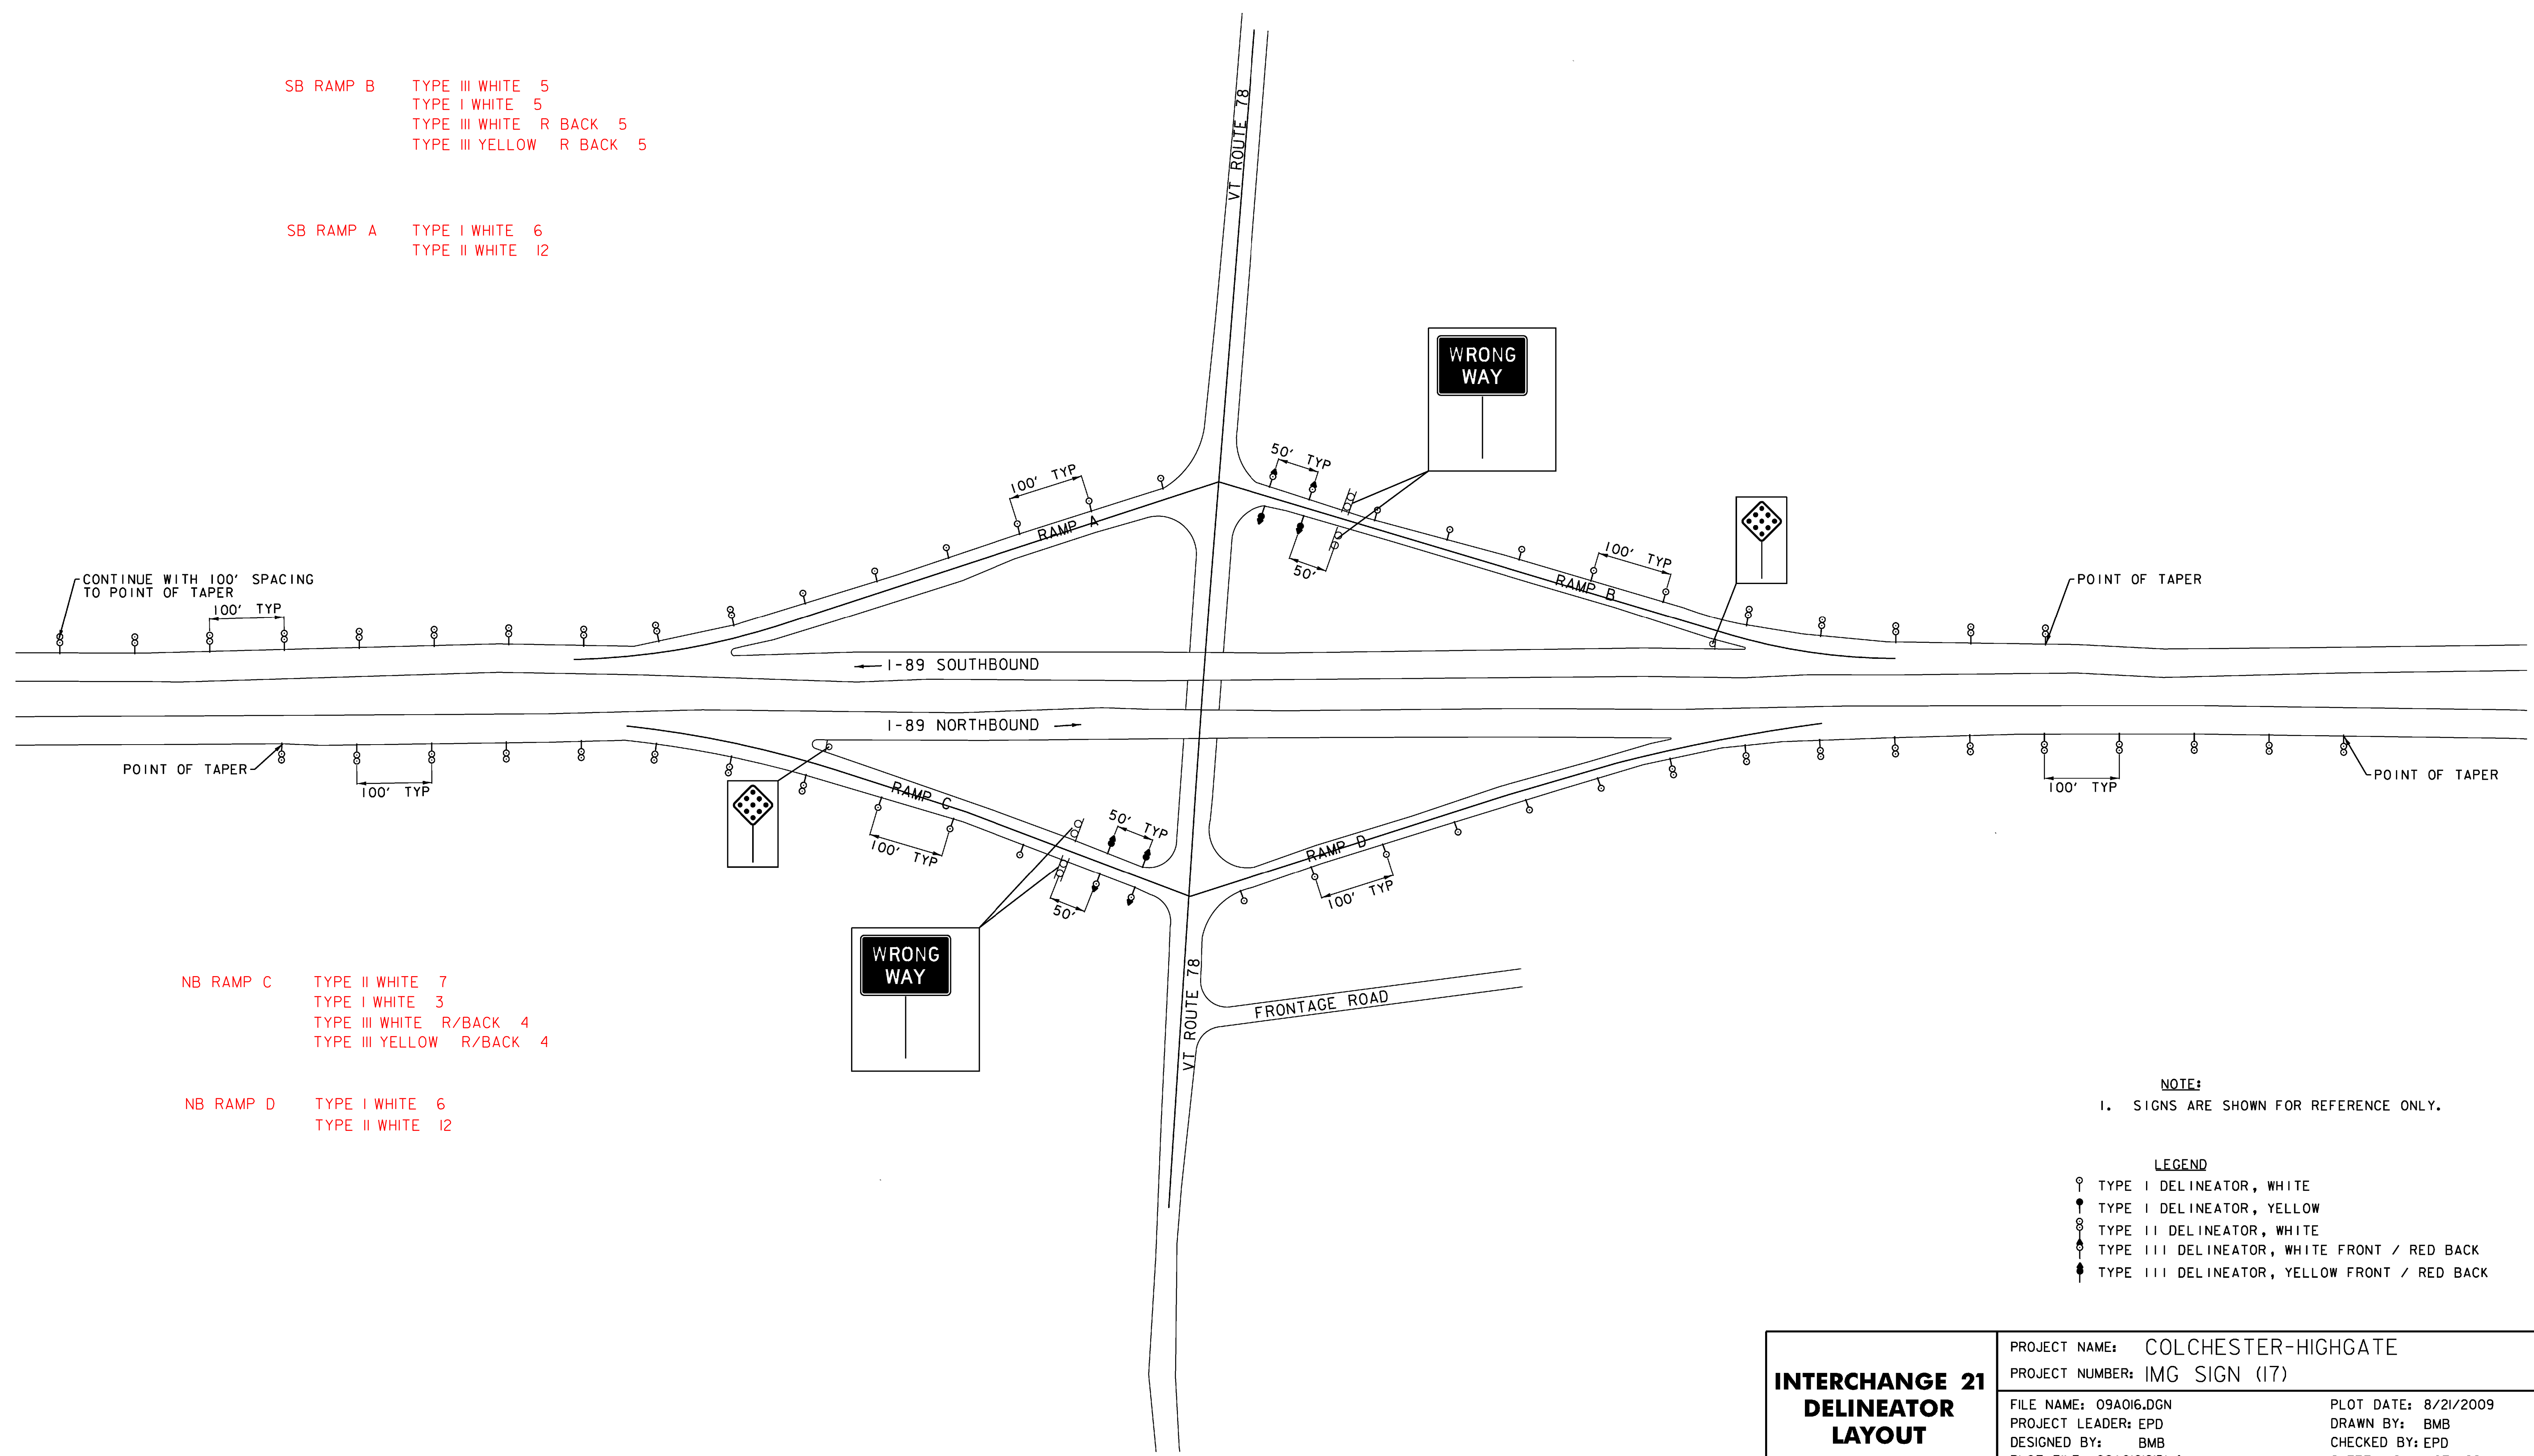

NOTE:
 1. SIGNS ARE SHOWN FOR REFERENCE ONLY.

- LEGEND
- ⊙ TYPE I DELINEATOR, WHITE
 - ⦿ TYPE I DELINEATOR, YELLOW
 - ⊗ TYPE II DELINEATOR, WHITE
 - ⦿ TYPE III DELINEATOR, WHITE FRONT / RED BACK
 - ⦿ TYPE III DELINEATOR, YELLOW FRONT / RED BACK

**INTERCHANGE 21
 DELINEATOR
 LAYOUT**

PROJECT NAME: COLCHESTER-HIGHGATE	
PROJECT NUMBER: IMG SIGN (17)	
FILE NAME: 09A016.DGN	PLOT DATE: 8/21/2009
PROJECT LEADER: EPD	DRAWN BY: BMB
DESIGNED BY: BMB	CHECKED BY: EPD
PLOT FILE: 09A016I2IDL.I	SHEET 21 OF 22I