



EDGE OF TRAVELLED WAY

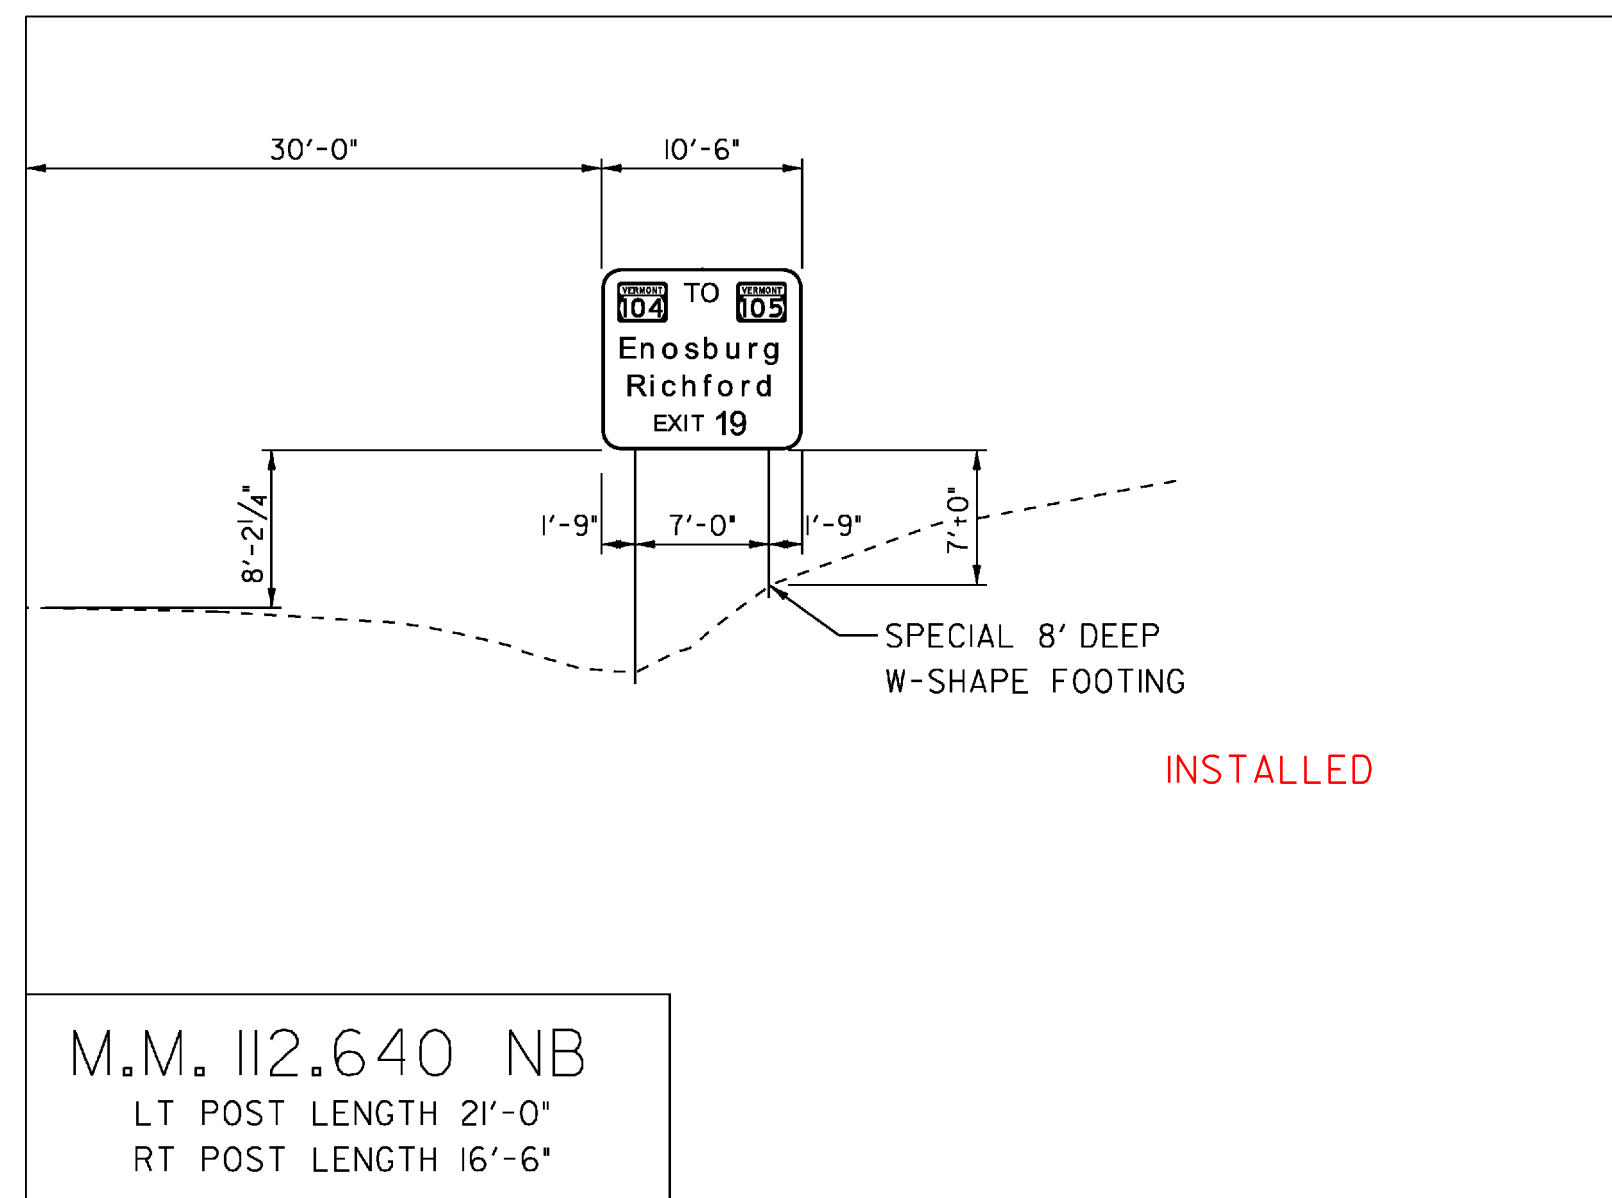


M.M. 112.640 NB
 LT POST LENGTH 21'-0"
 RT POST LENGTH 16'-6"

EDGE OF TRAVELLED WAY

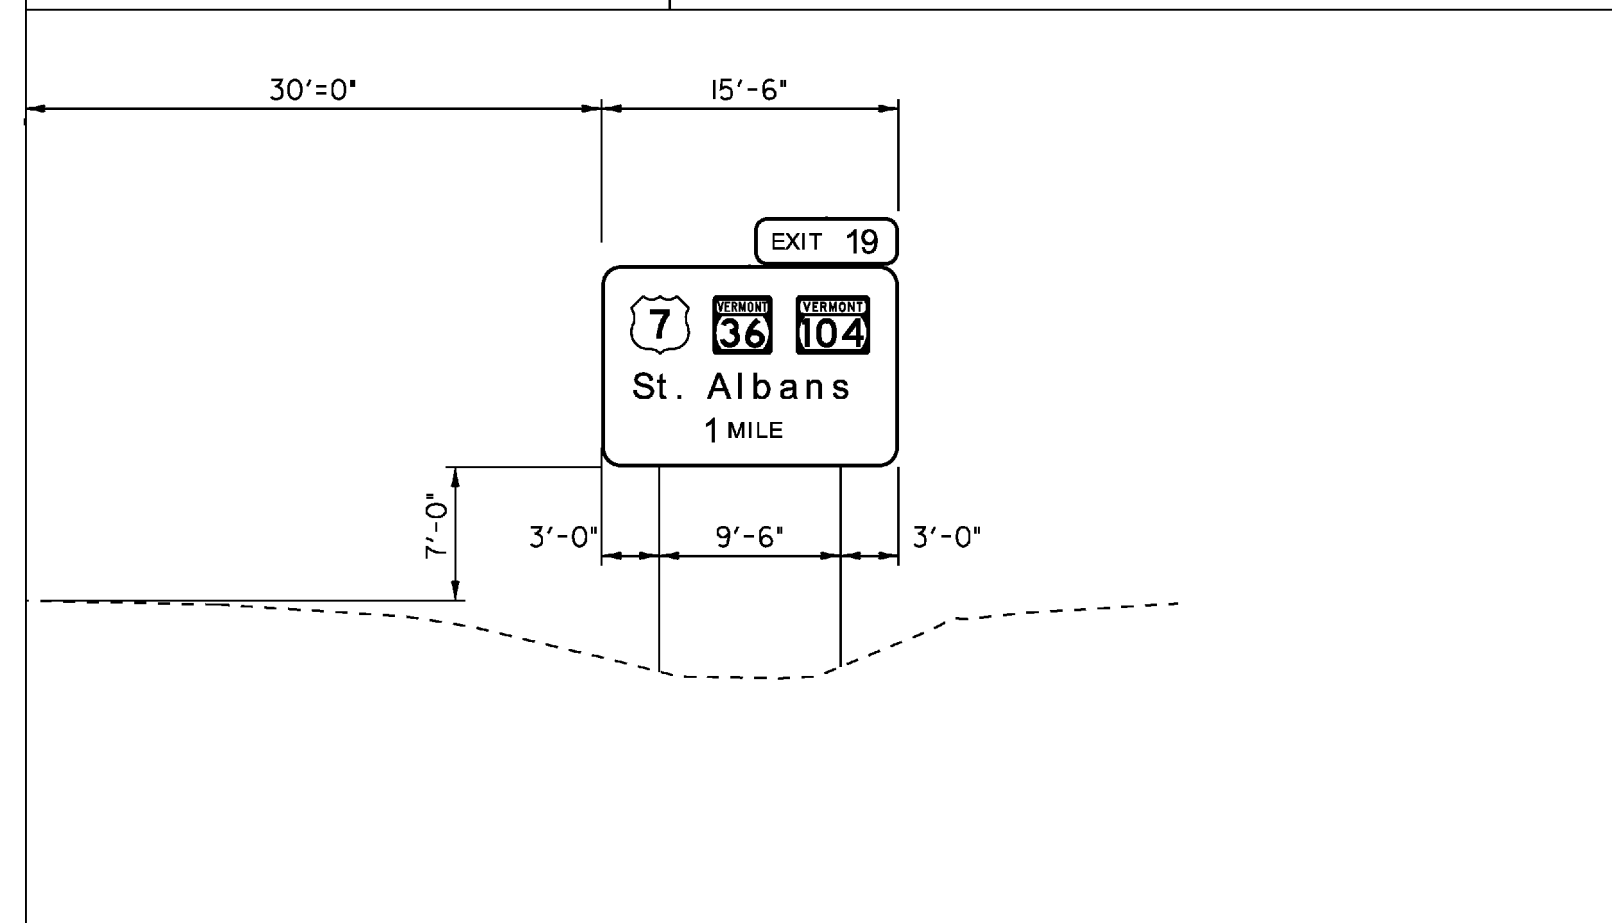


M.M. 112.450 NB
 LT POST LENGTH 21'-6"
 RT POST LENGTH 21'-6"

EDGE OF TRAVELLED WAY

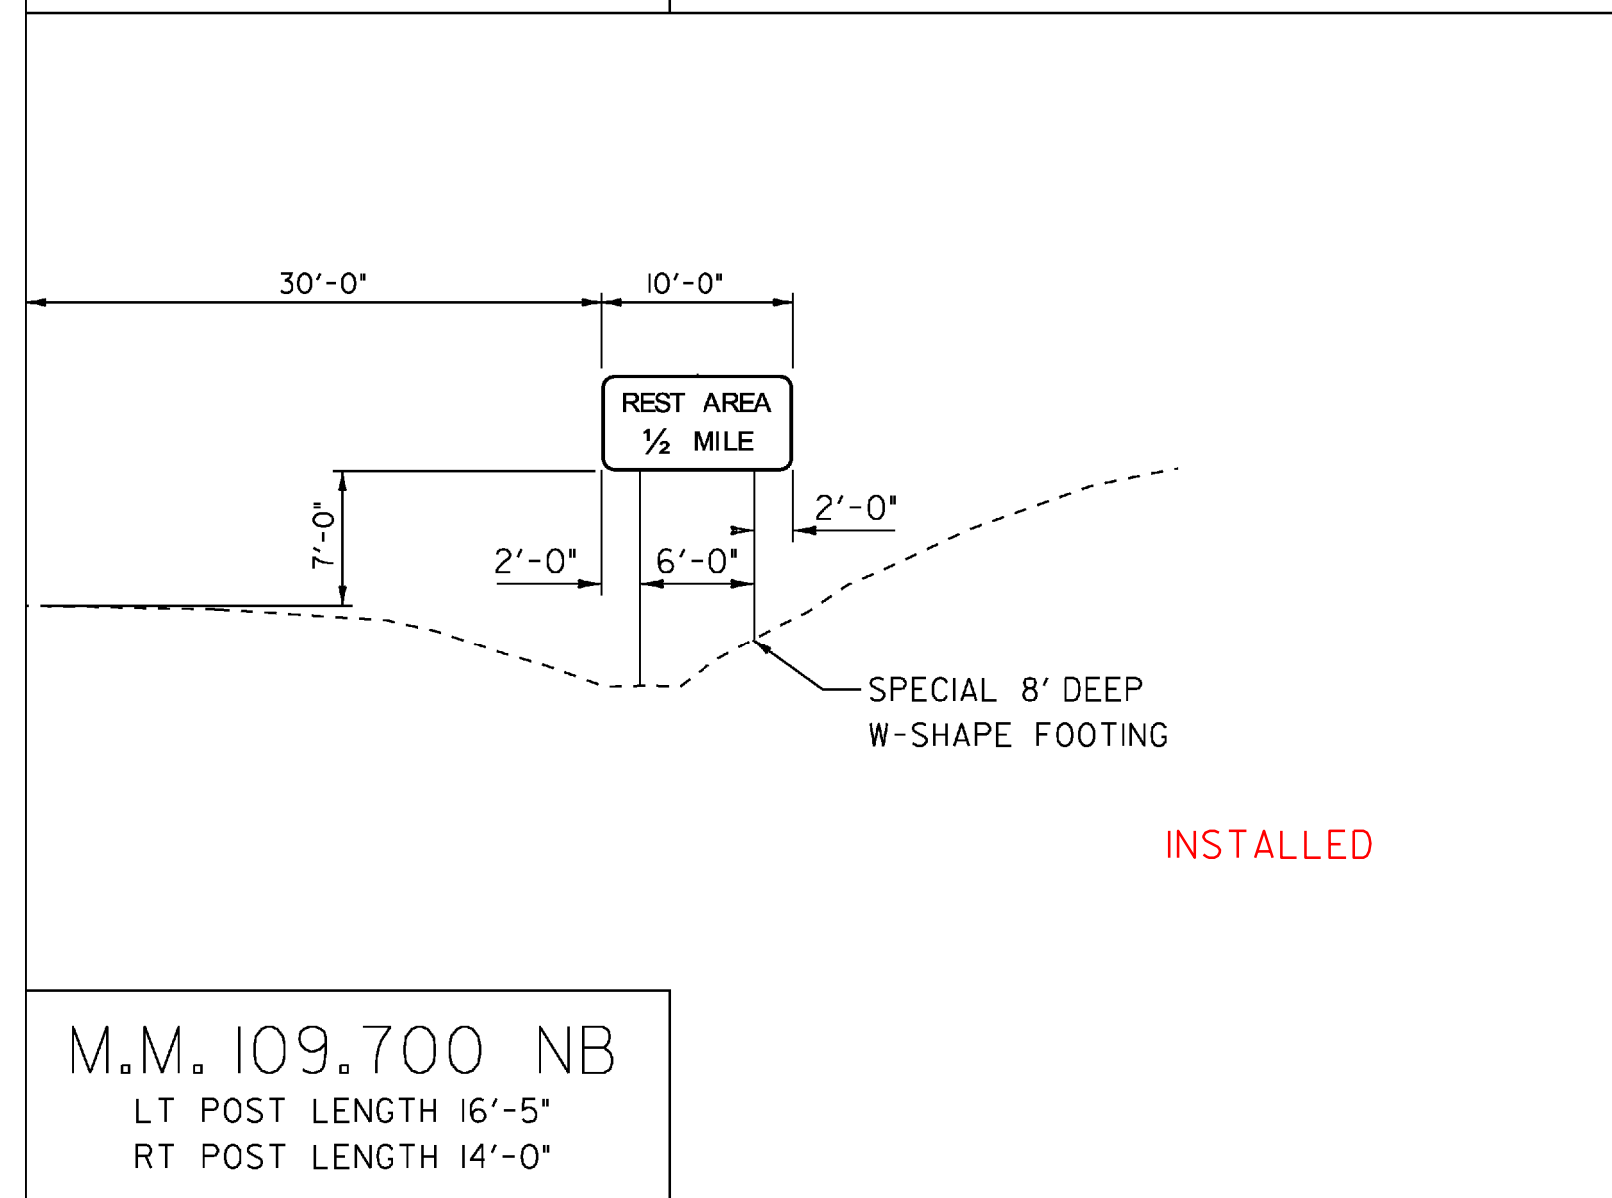


M.M. 109.700 NB
 LT POST LENGTH 16'-5"
 RT POST LENGTH 14'-0"

EDGE OF TRAVELLED WAY

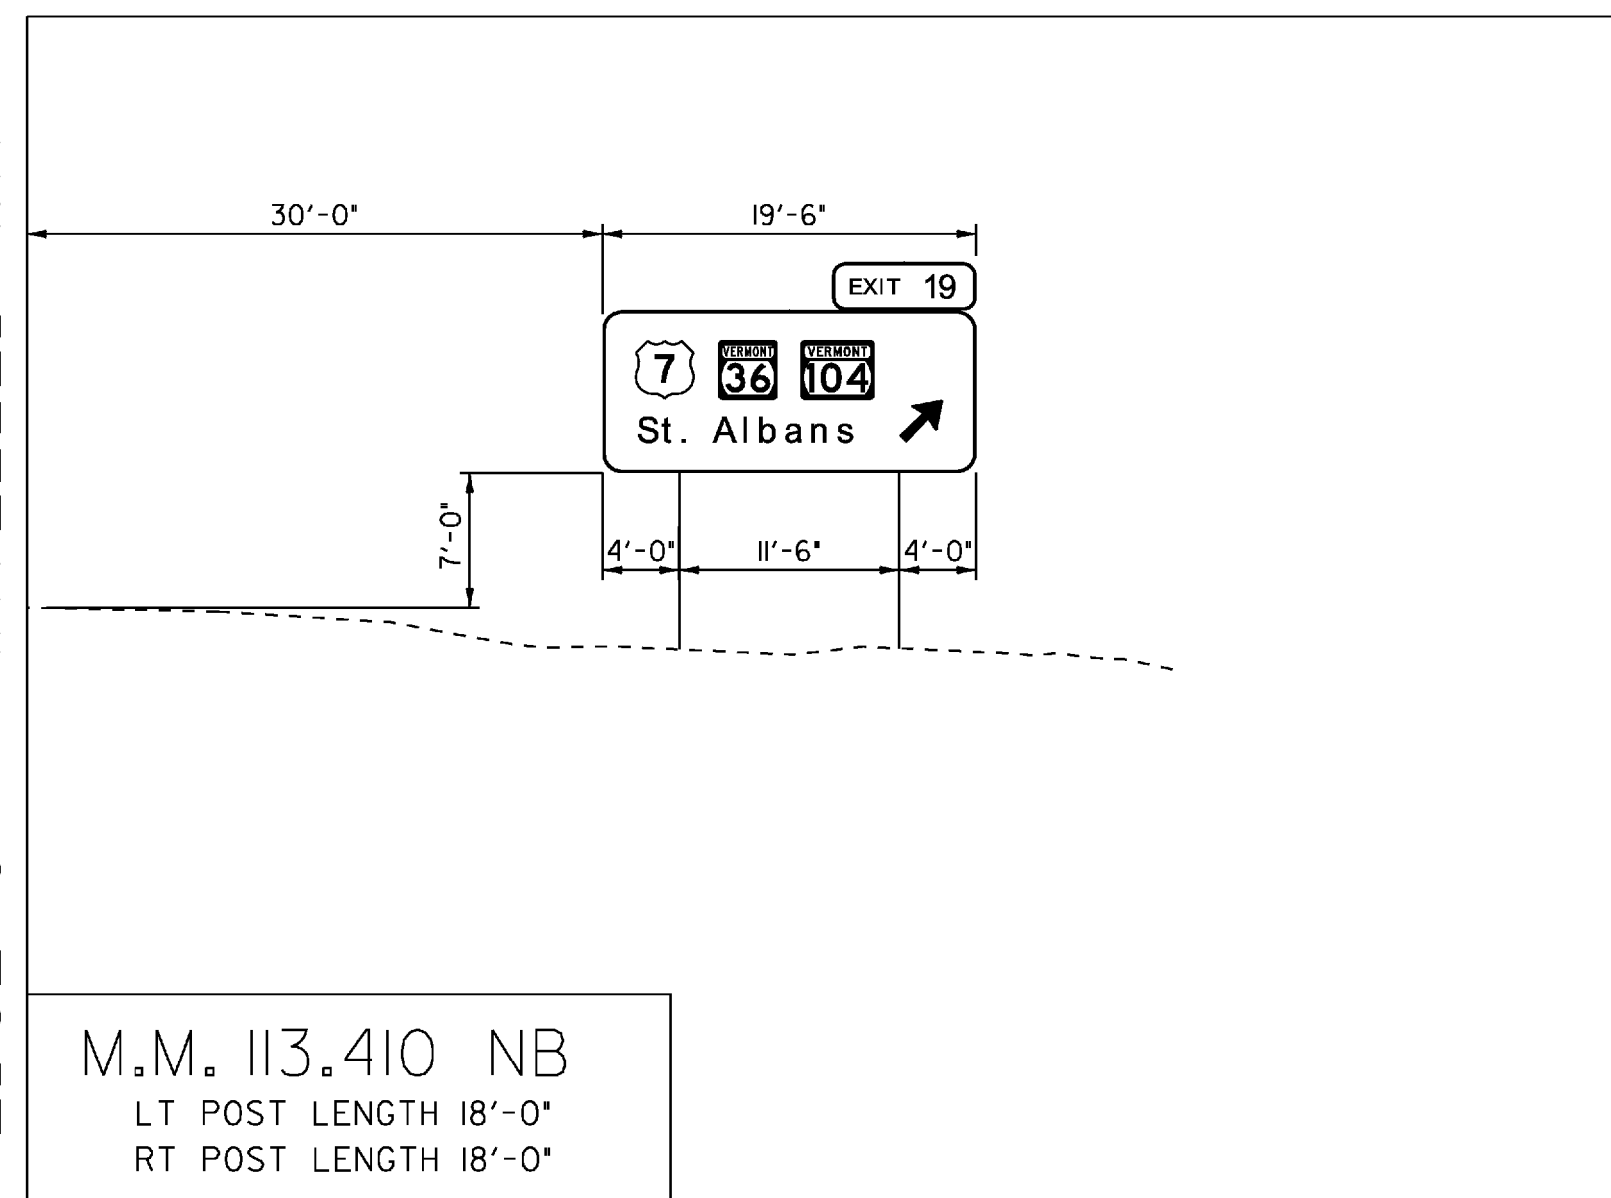


M.M. 113.410 NB
 LT POST LENGTH 18'-0"
 RT POST LENGTH 18'-0"

EDGE OF TRAVELLED WAY

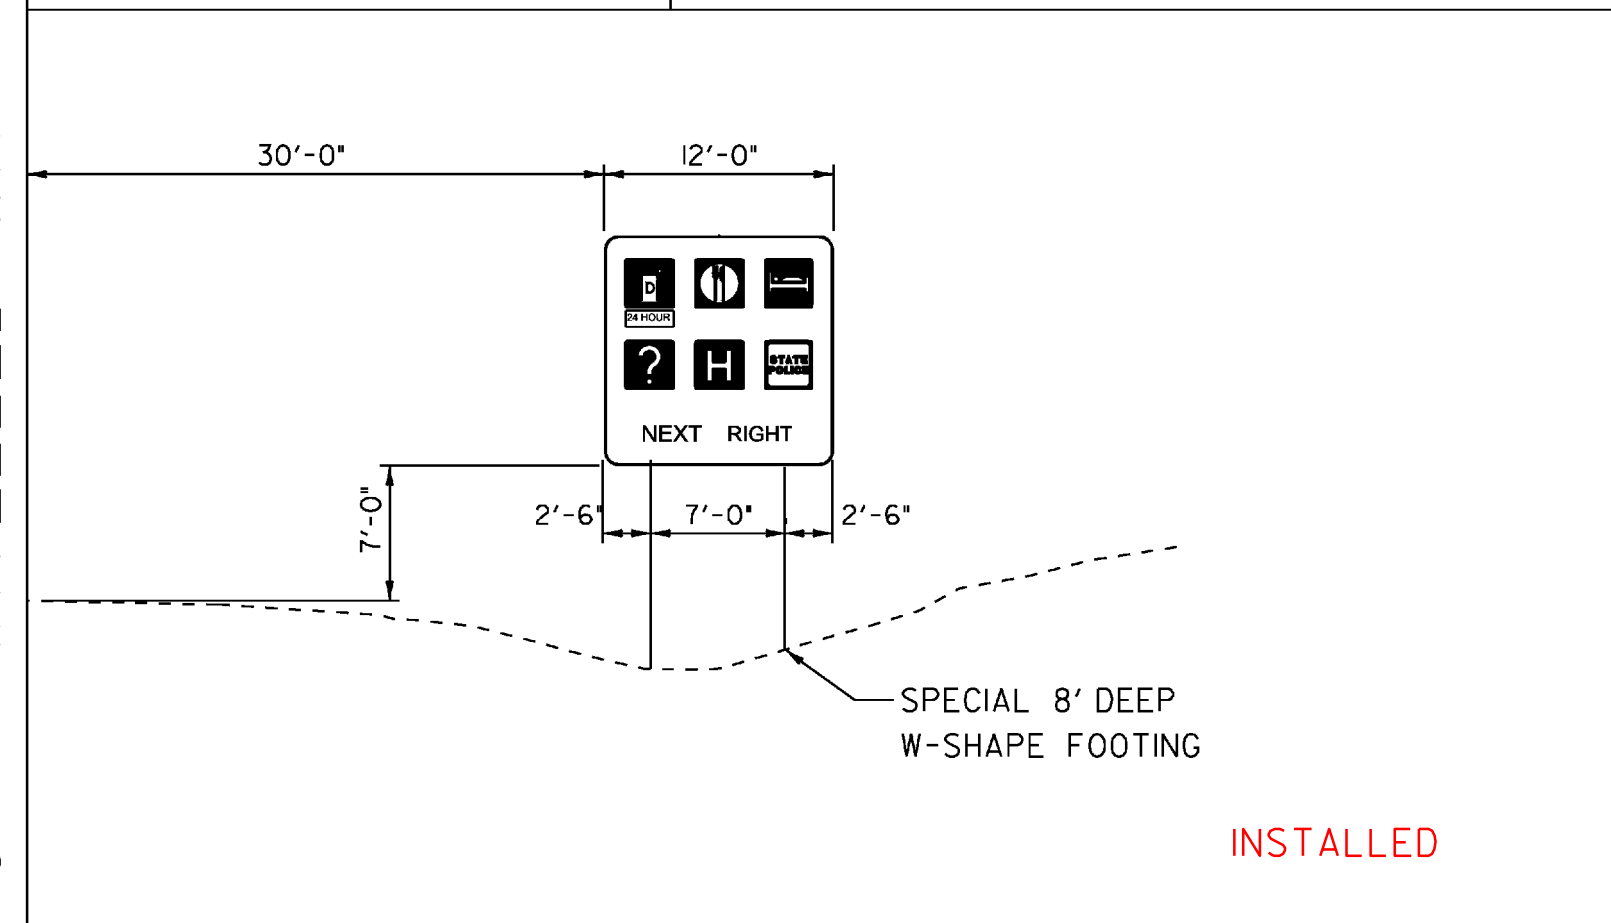


M.M. 113.210 NB
 LT POST LENGTH 23'-0"
 RT POST LENGTH 22'-0"

EDGE OF TRAVELLED WAY

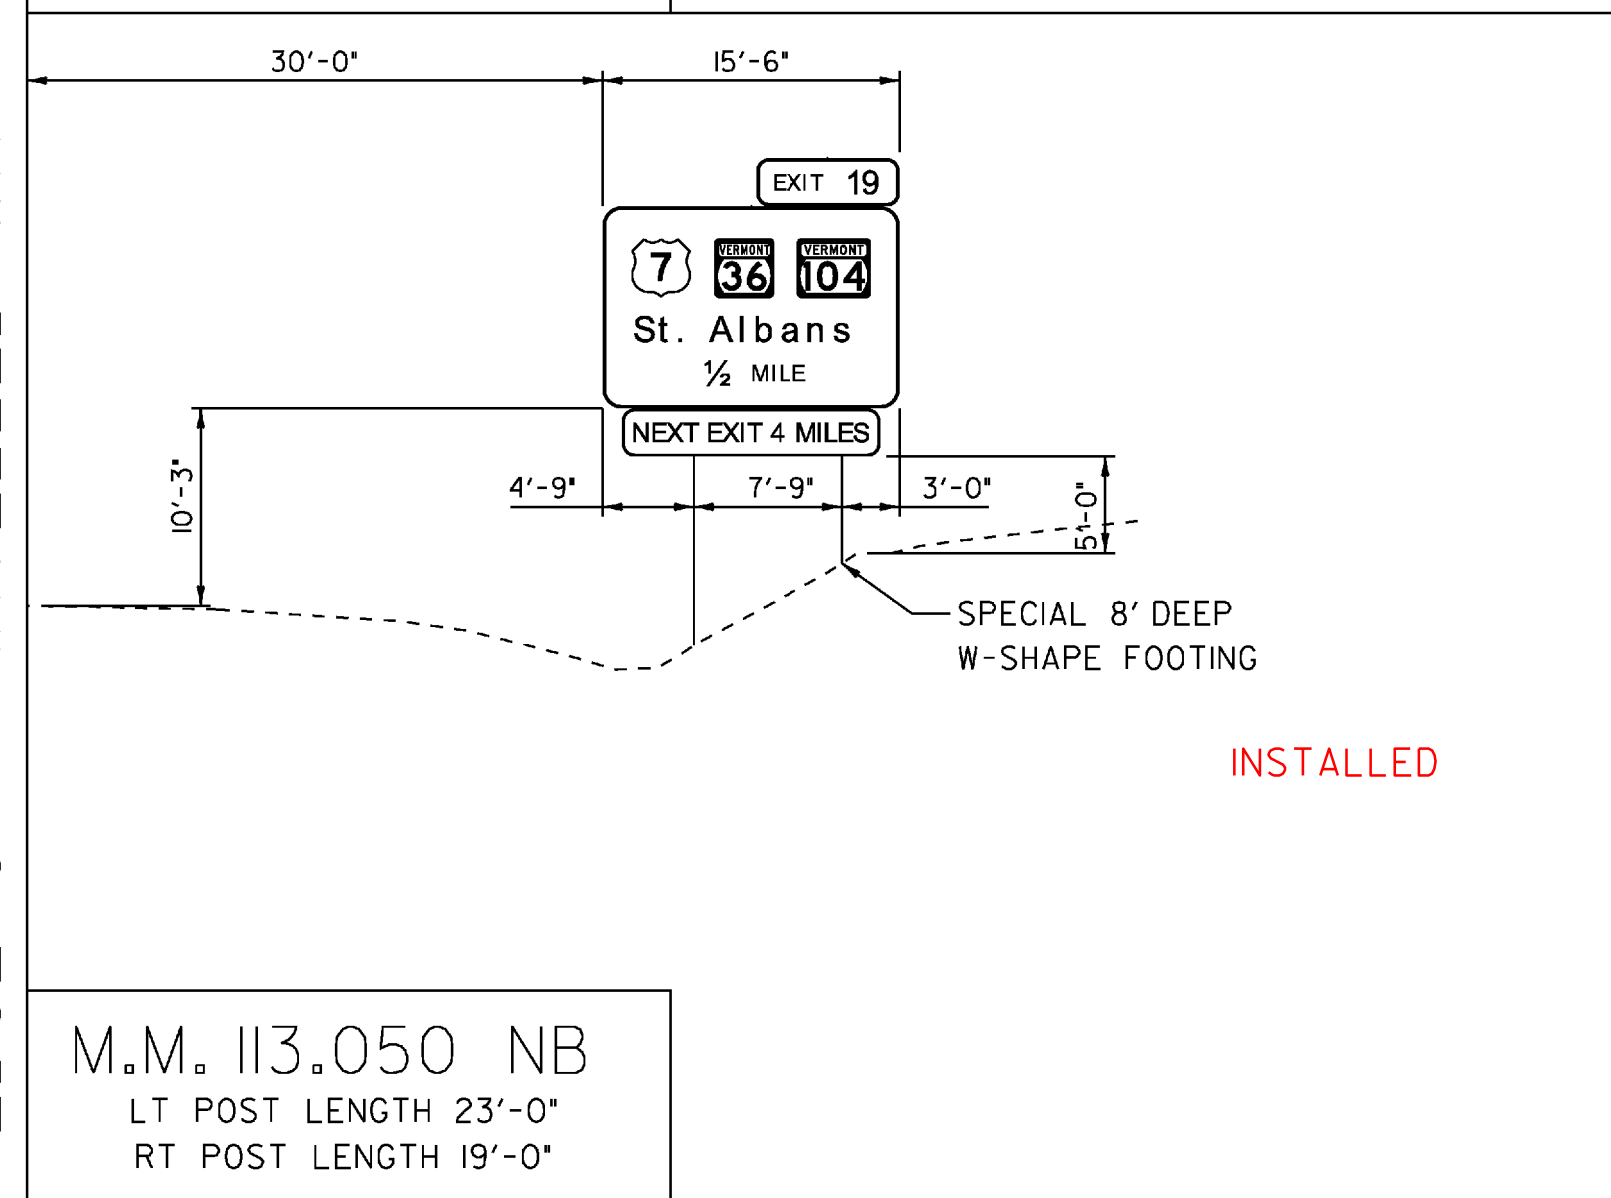


M.M. 113.050 NB
 LT POST LENGTH 23'-0"
 RT POST LENGTH 19'-0"

EDGE OF TRAVELLED WAY

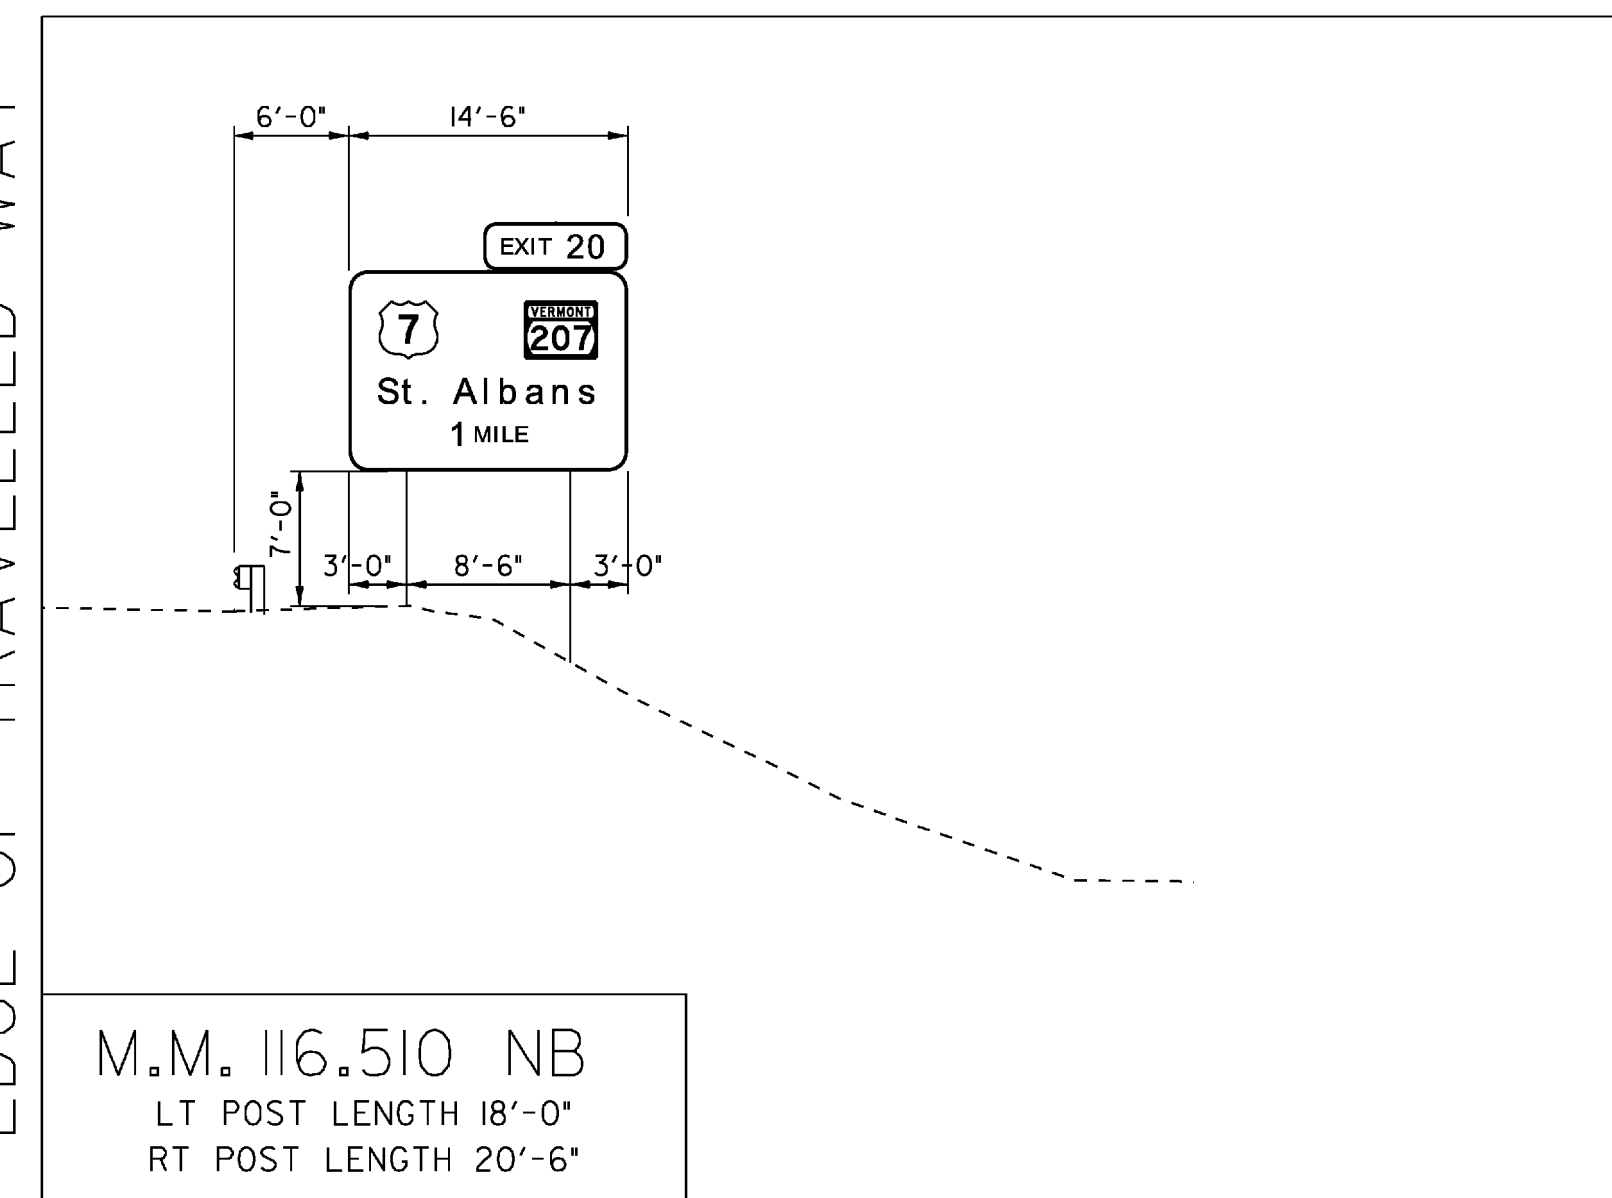

M.M. 116.510 NB
 LT POST LENGTH 18'-0"
 RT POST LENGTH 20'-6"

EDGE OF TRAVELLED WAY

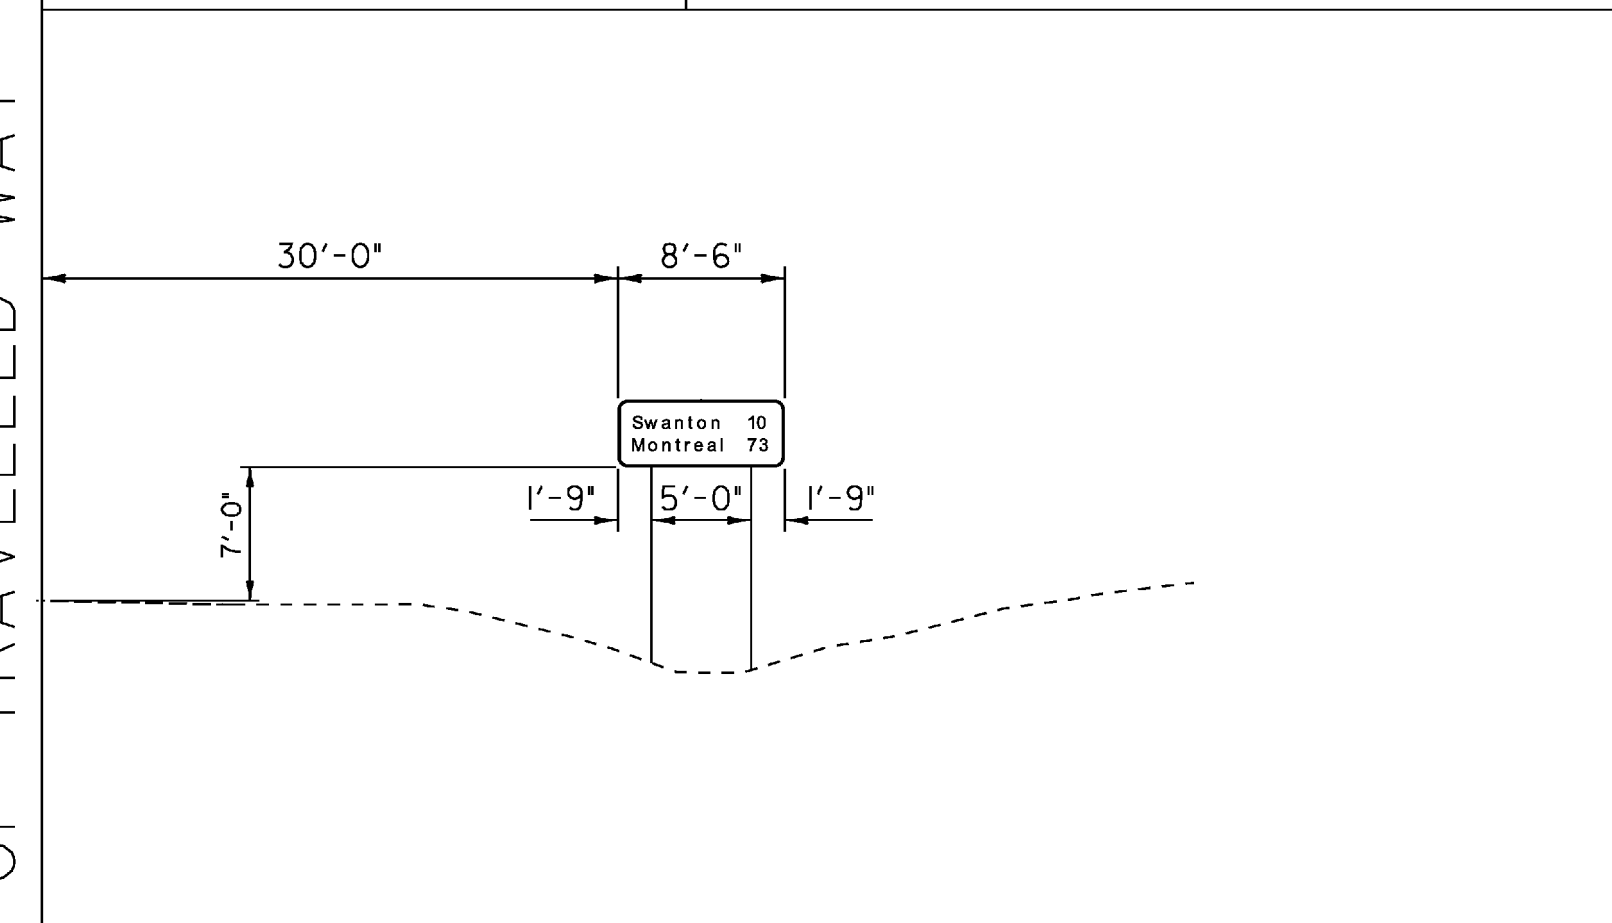

M.M. 114.370 NB
 LT POST LENGTH 14'-0"
 RT POST LENGTH 14'-6"

NOTES:

1. TYPICAL FOOTING BASE DEPTH IS PER STANDARD E-161, UNLESS SPECIFIED WITH THE NOTE: "SPECIAL 8' DEEP W-SHAPE FOOTING".
2. THE SPECIAL W-SHAPE FOOTING DETAIL IS LOCATED ON THE INDEX OF SHEETS & GENERAL NOTES, SHEET 2.

**NORTHBOUND
 CROSS SECTIONS
 3**

COLCHESTER-HIGHGATE	
PROJECT NUMBER: IMG SIGN (17)	
FILE NAME: 09A016.DGN	PLOT DATE: 8/21/2009
PROJECT LEADER: EPD	DRAWN BY: JDG
DESIGNED BY: JDG	CHECKED BY: EPD
PLOT FILE: 09A016CS3.1	SHEET 52 OF 221

SCALE 1" = 10'-0"
 10 0 10