

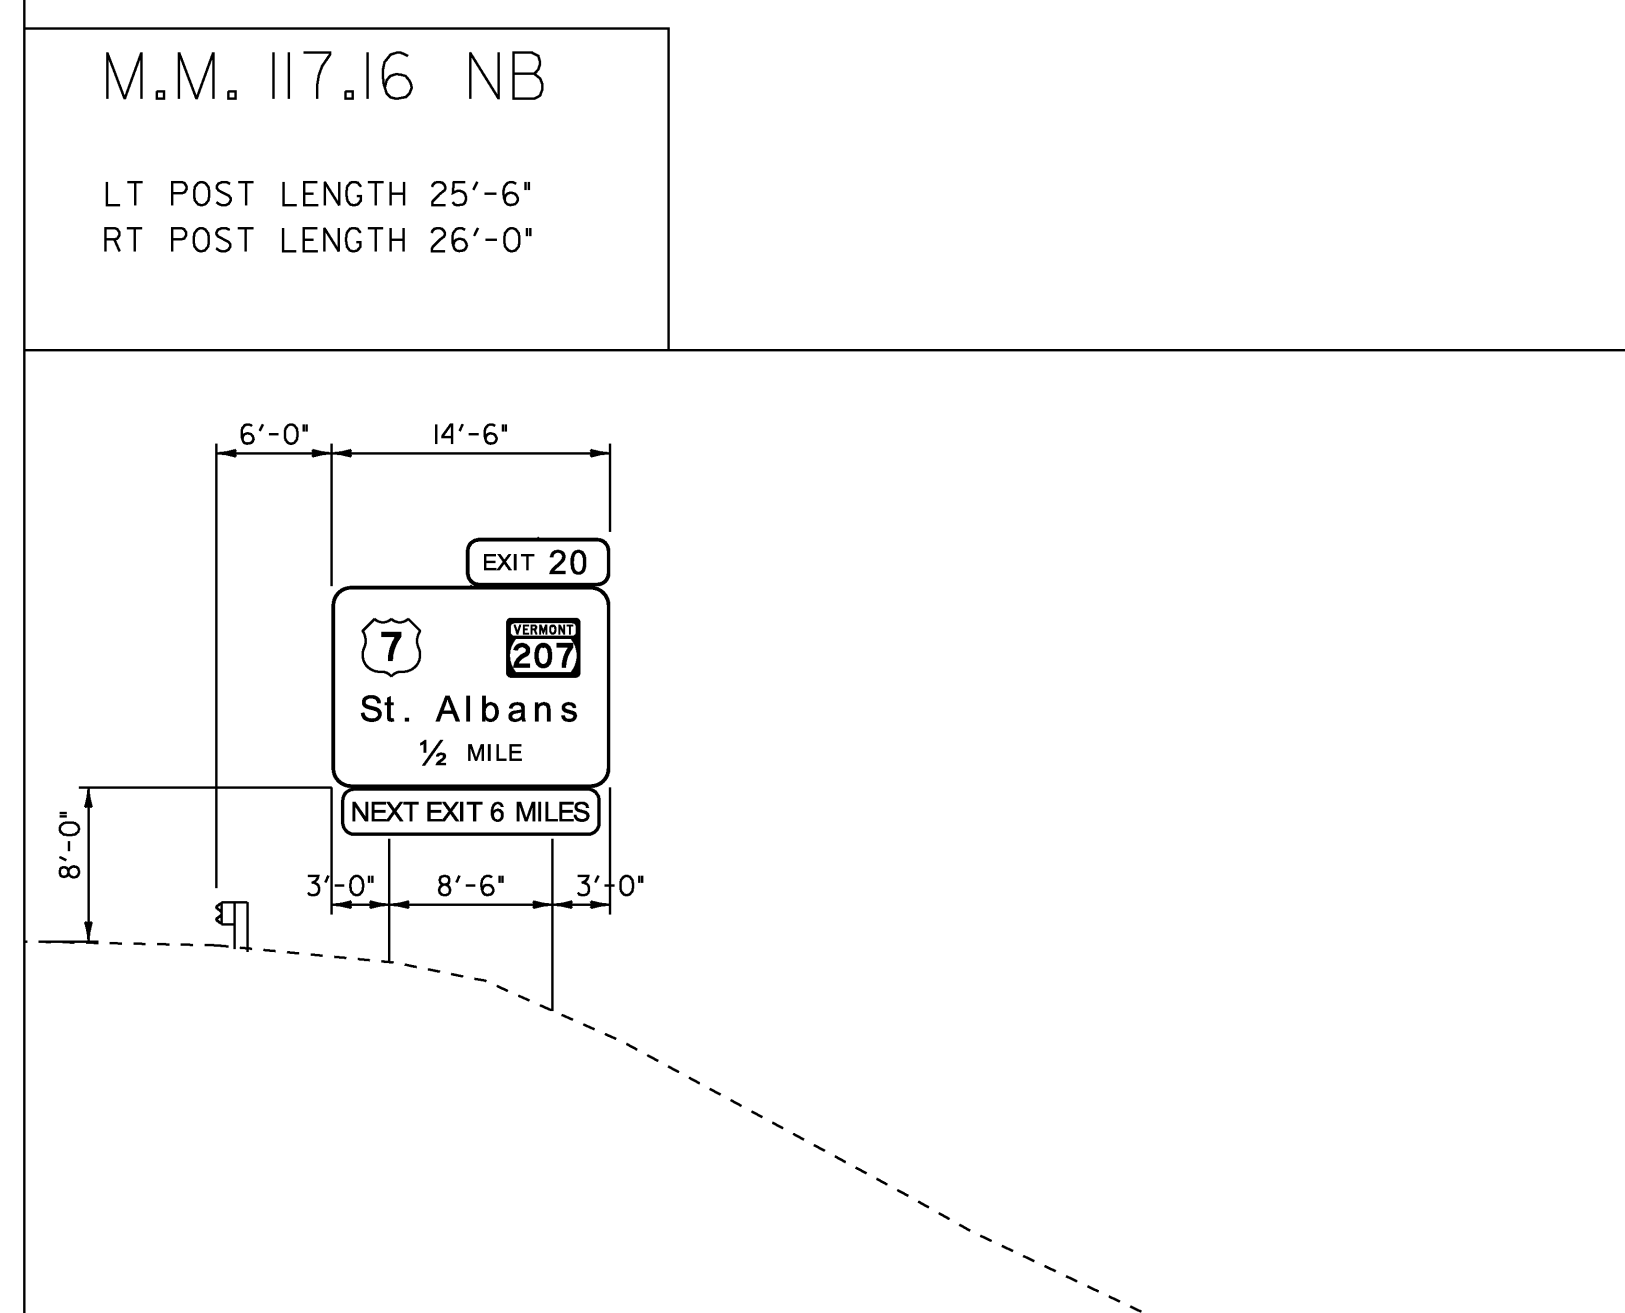
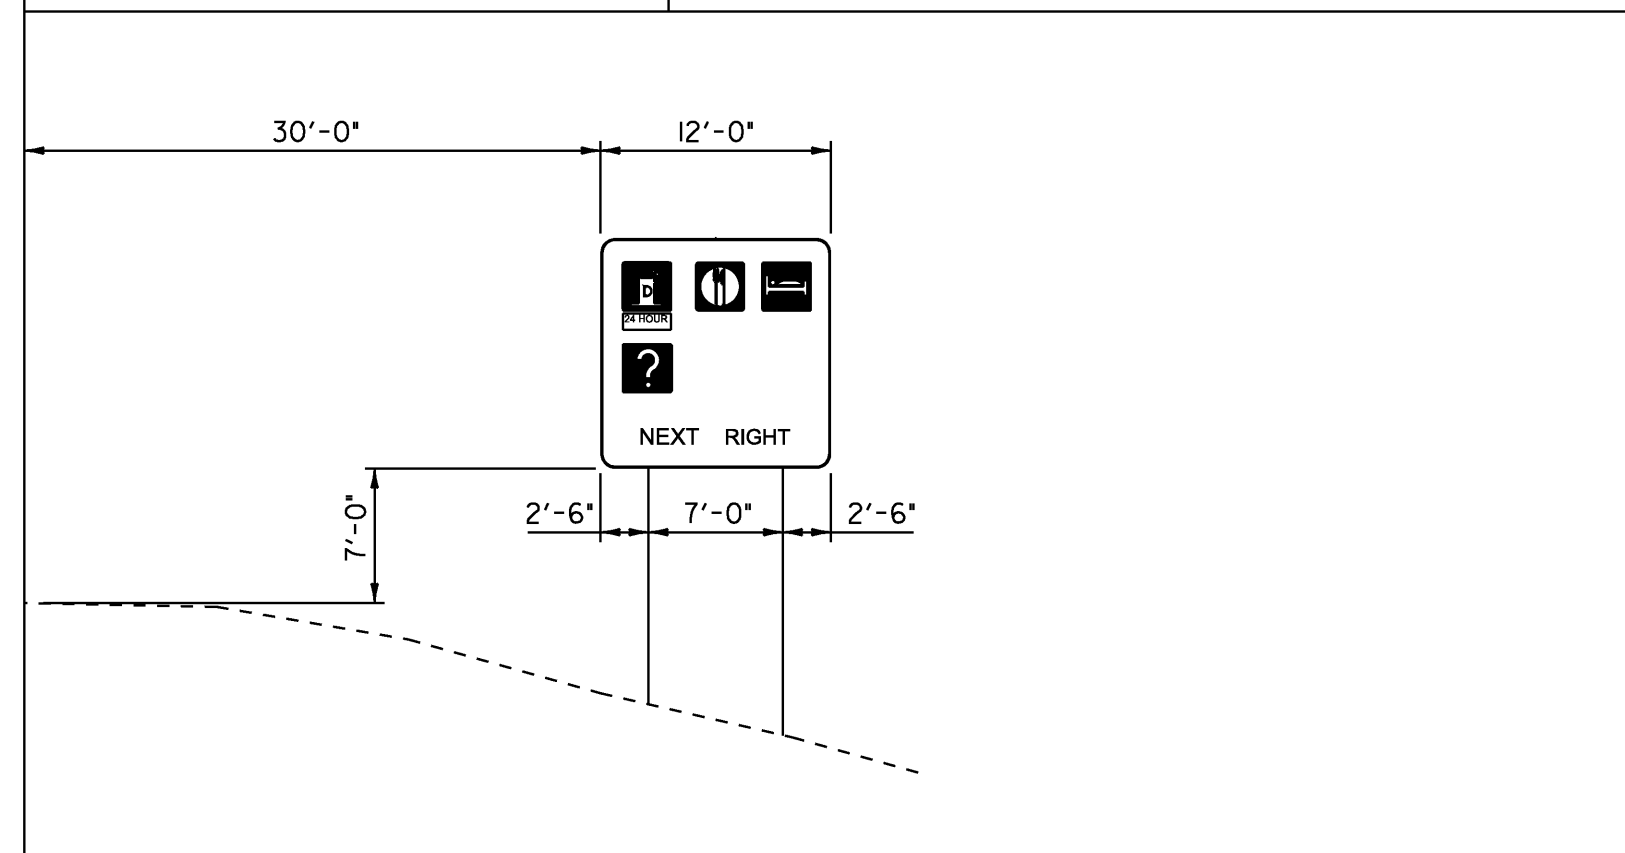
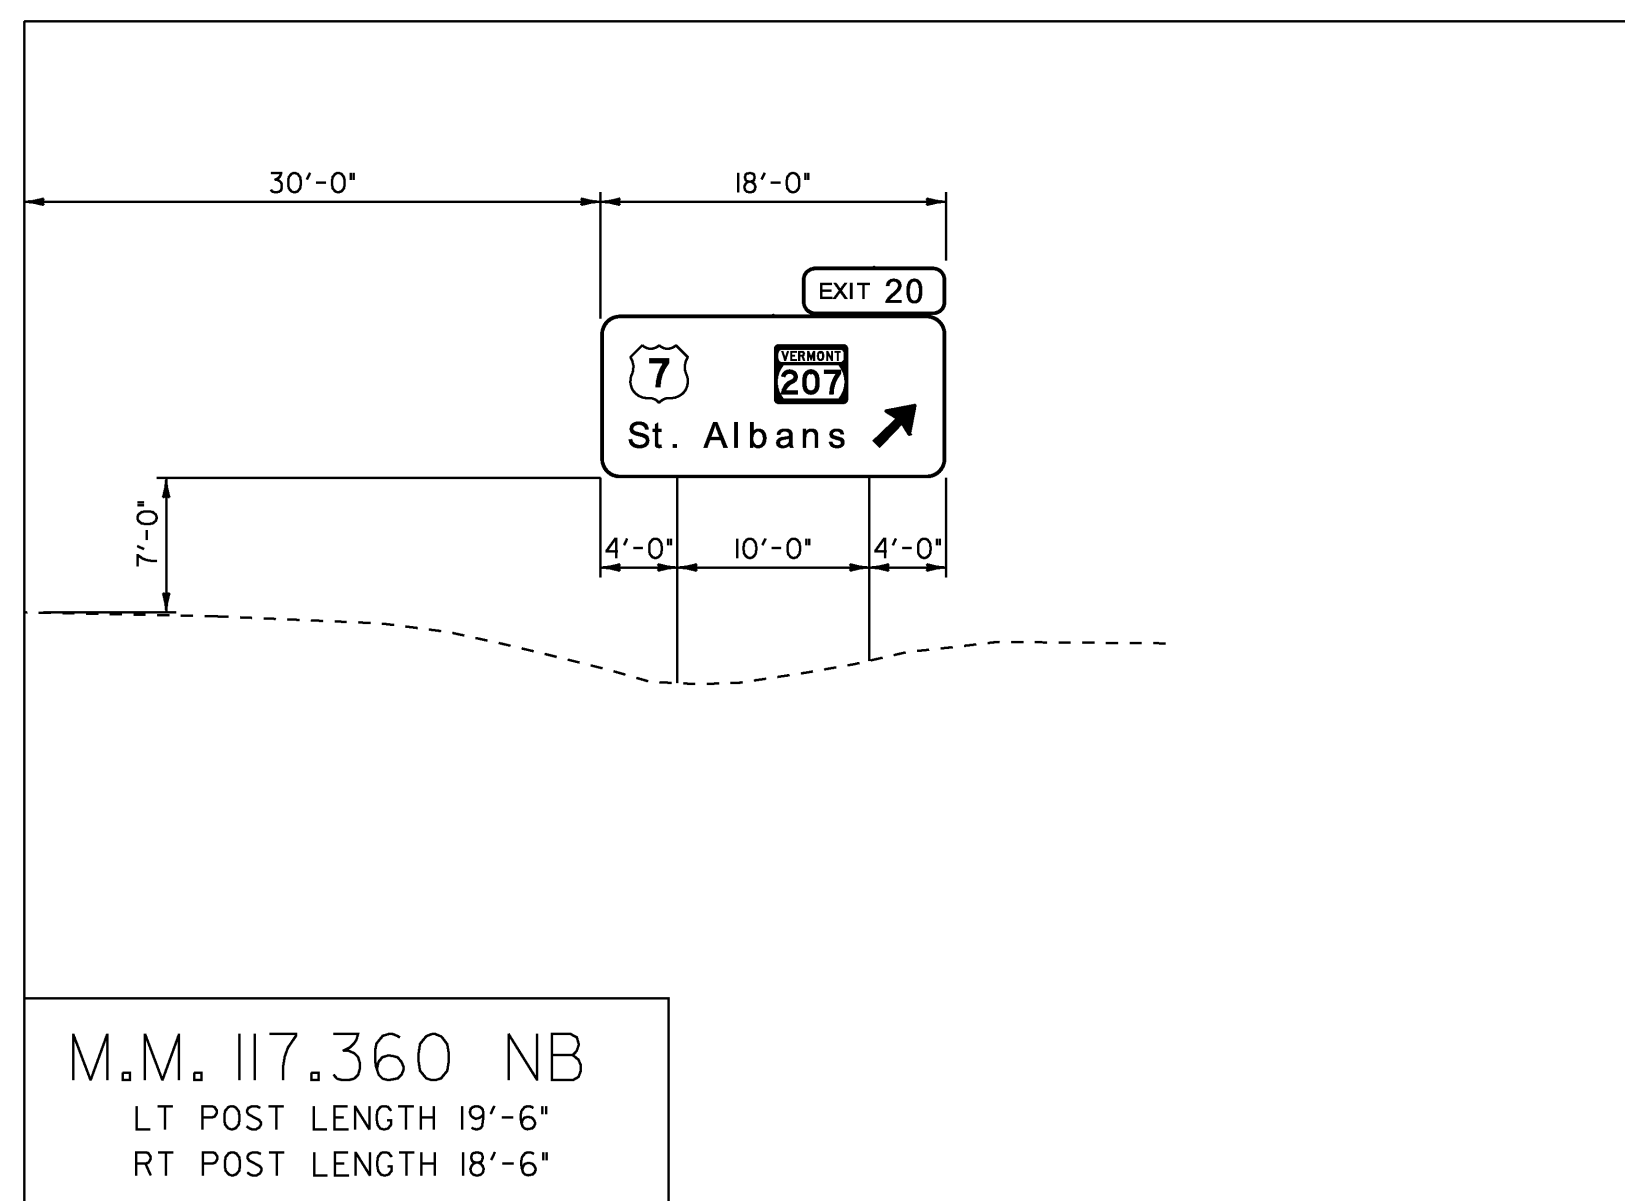
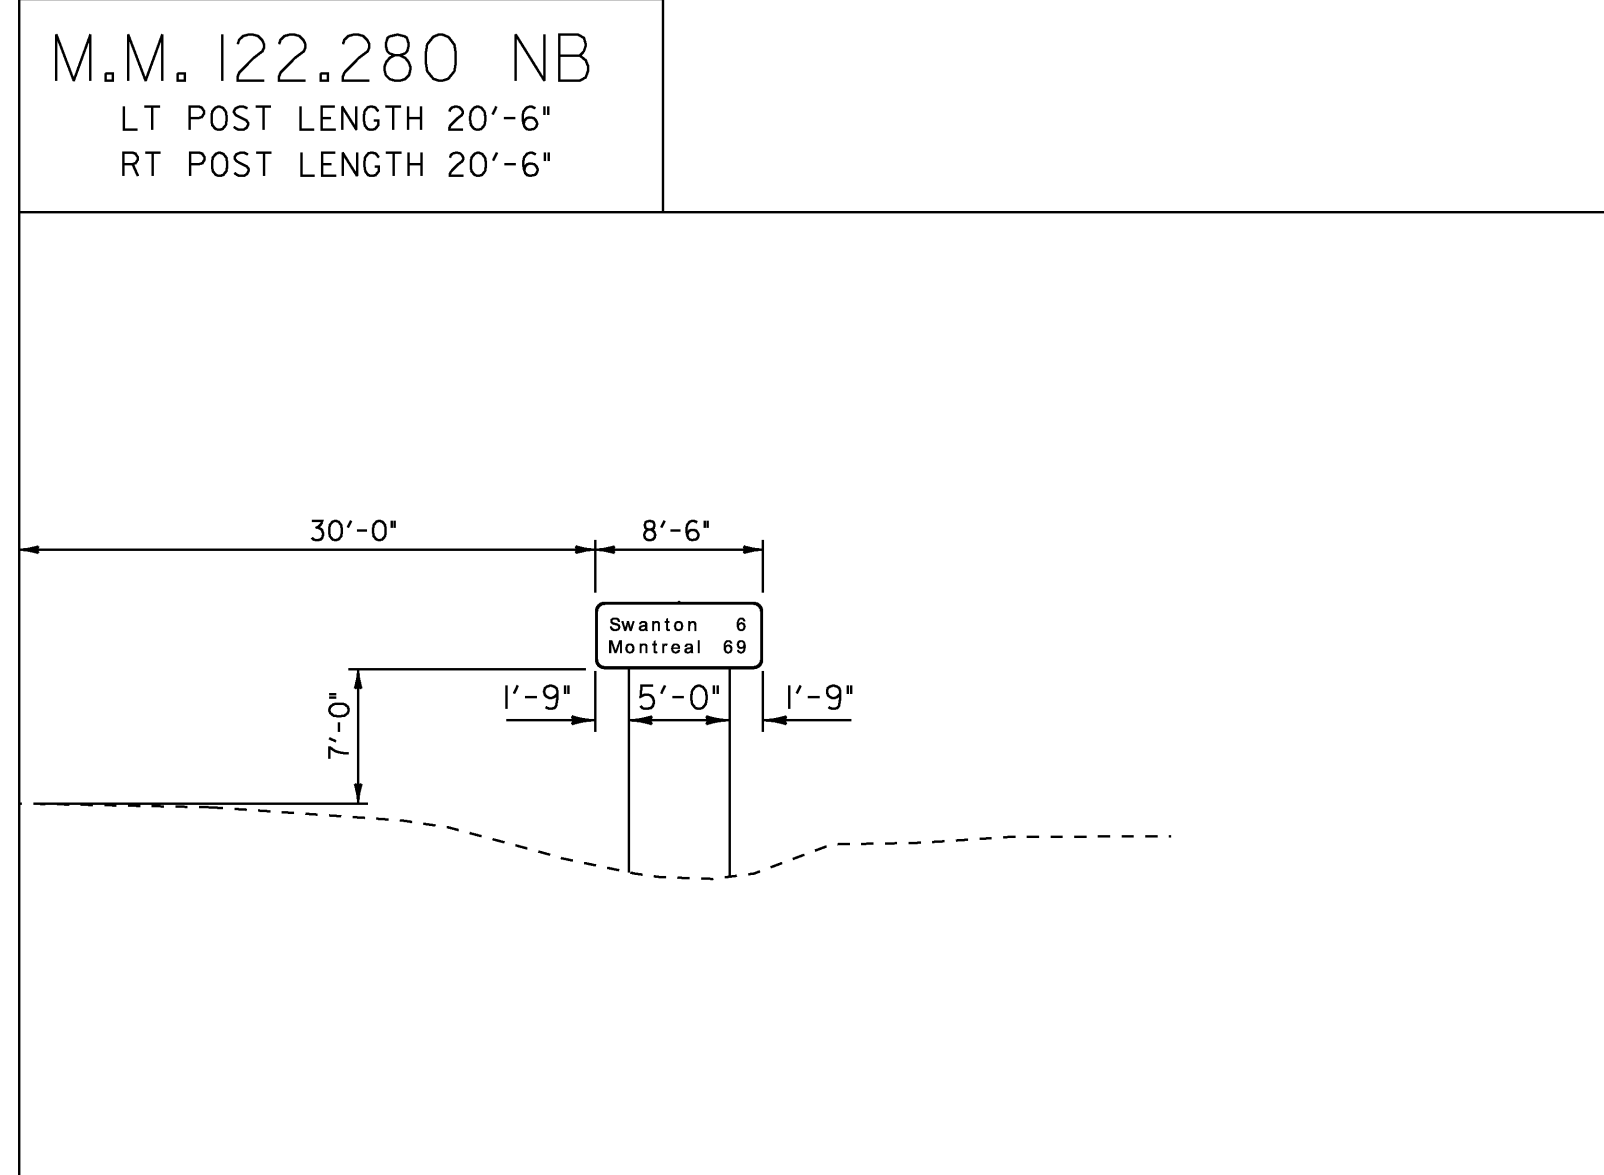





EDGE OF TRAVELLED WAY

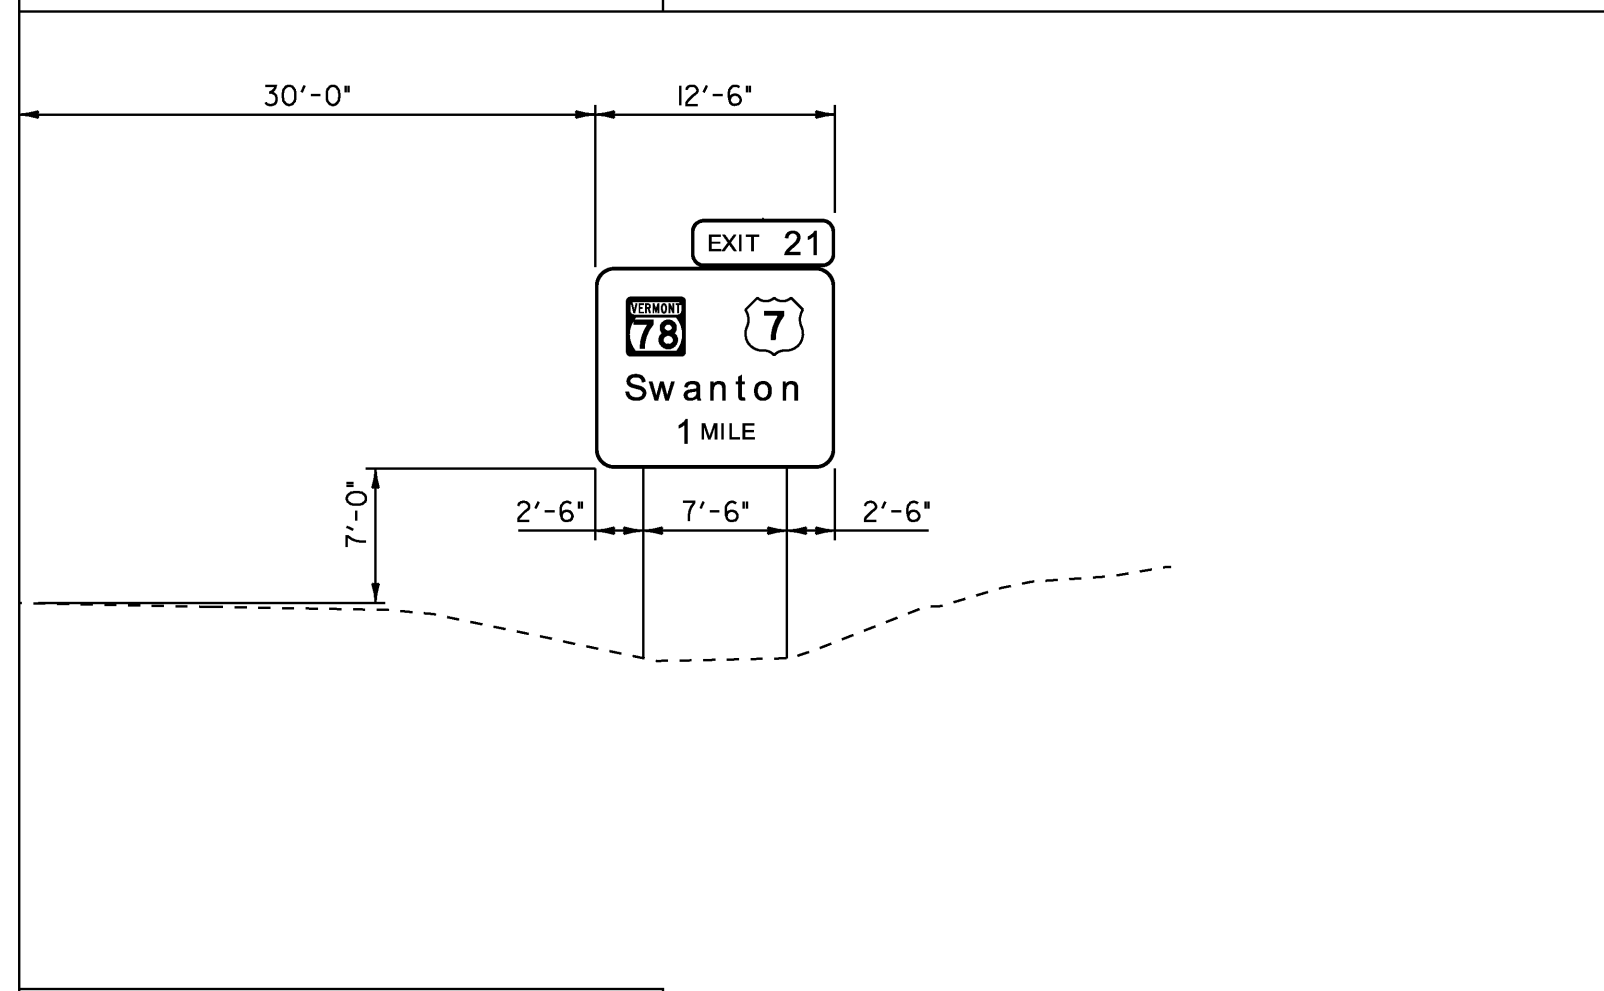

EDGE OF TRAVELLED WAY

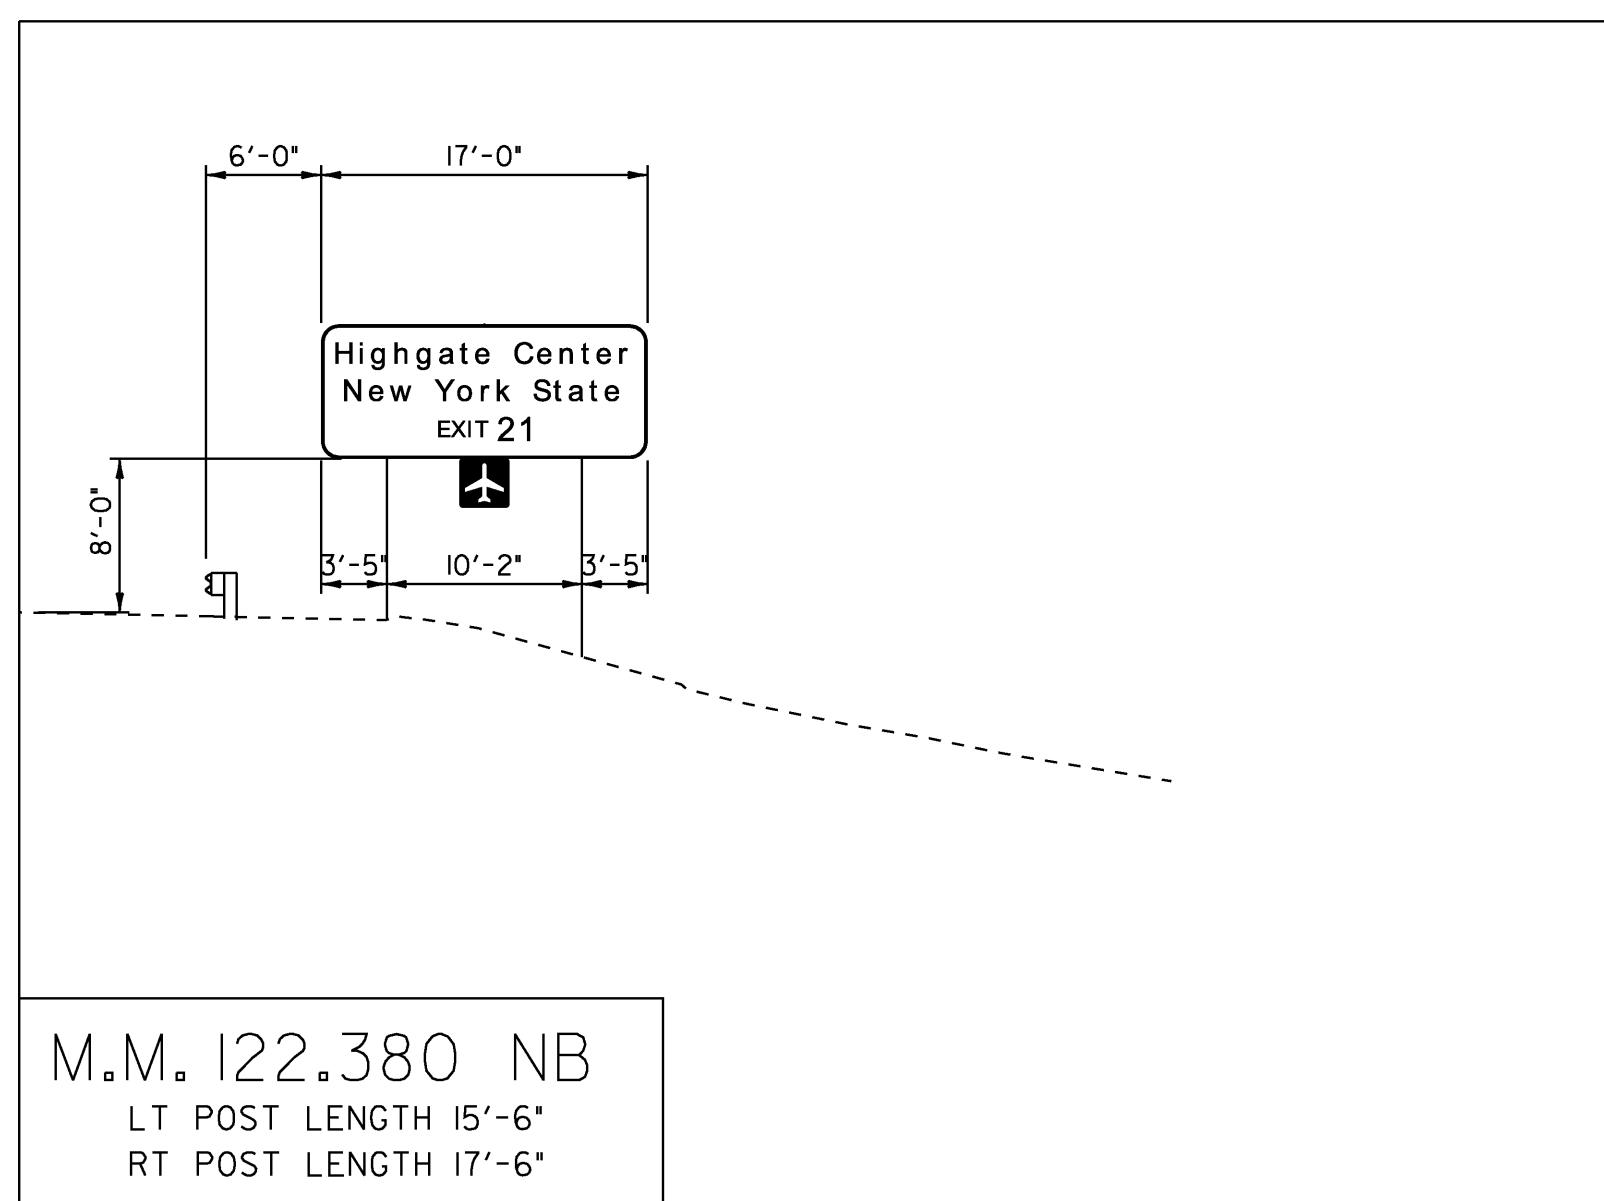

EDGE OF TRAVELLED WAY

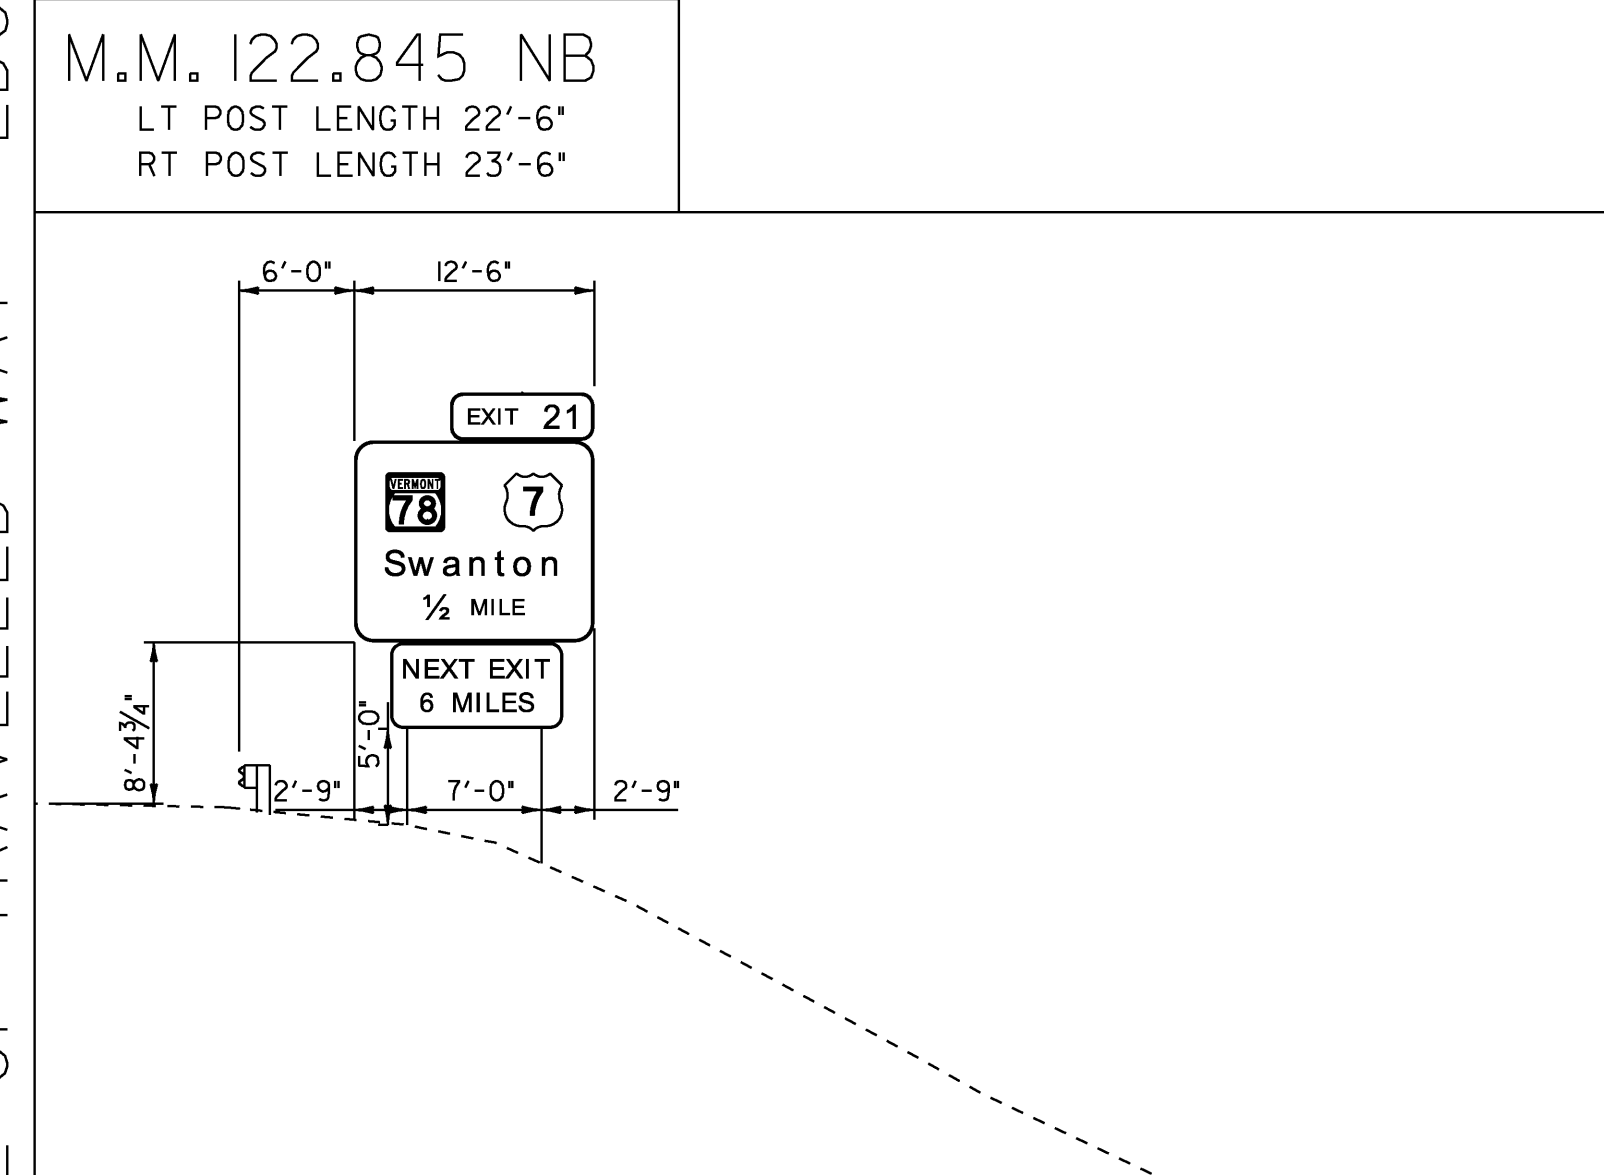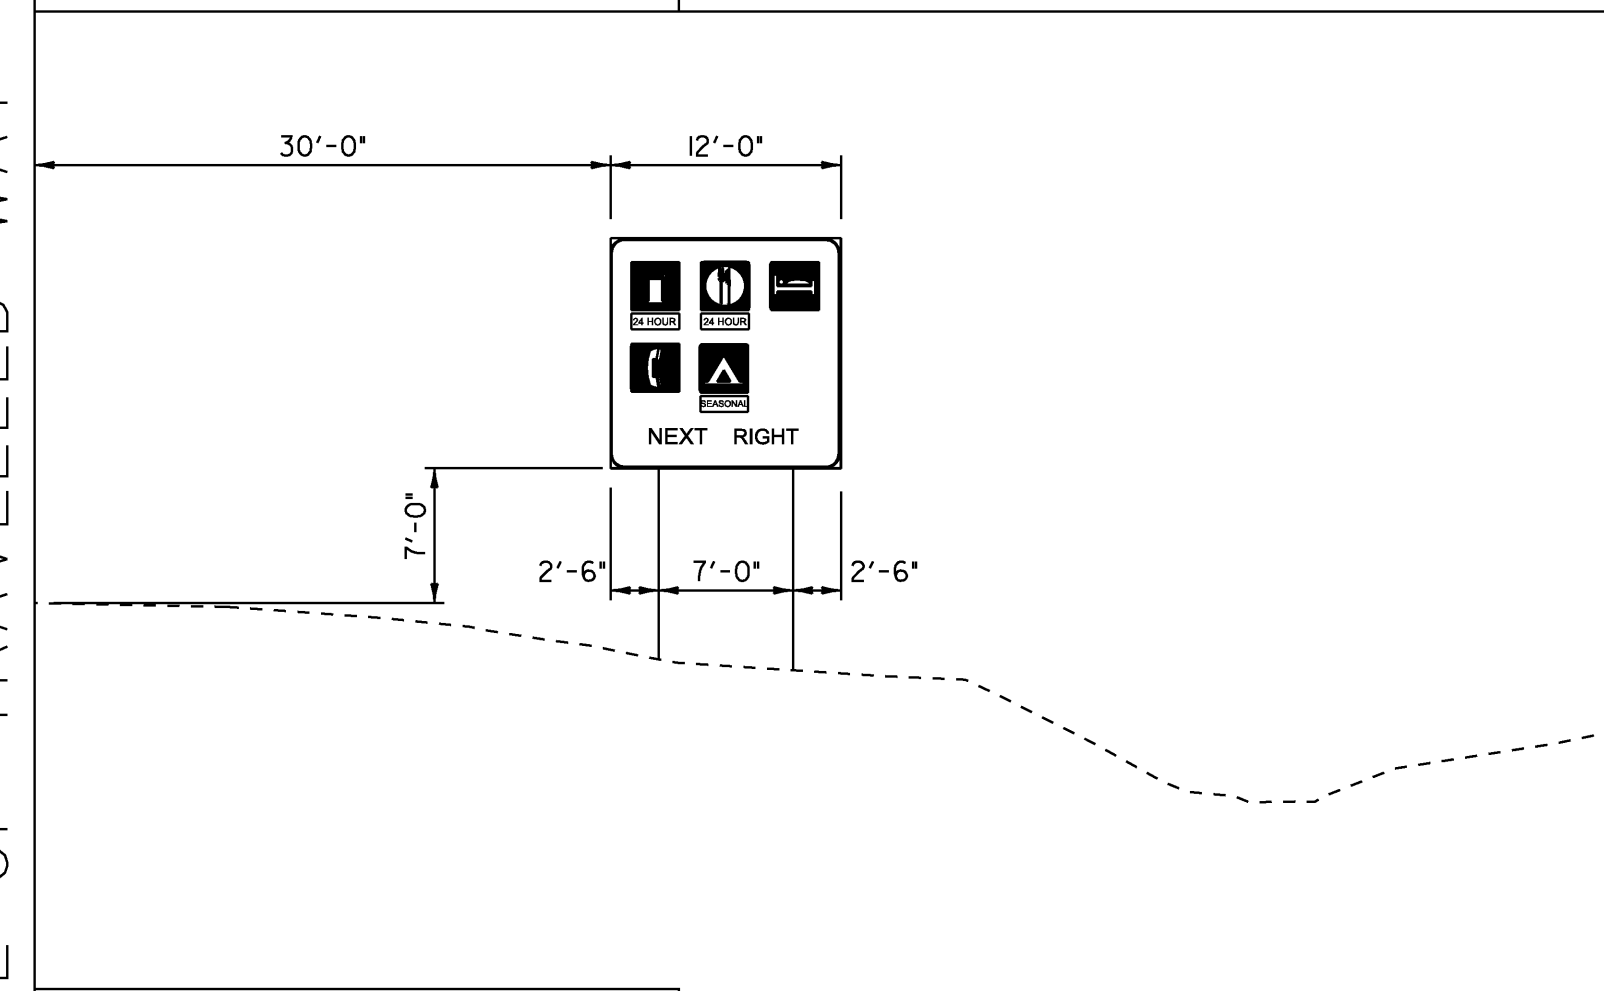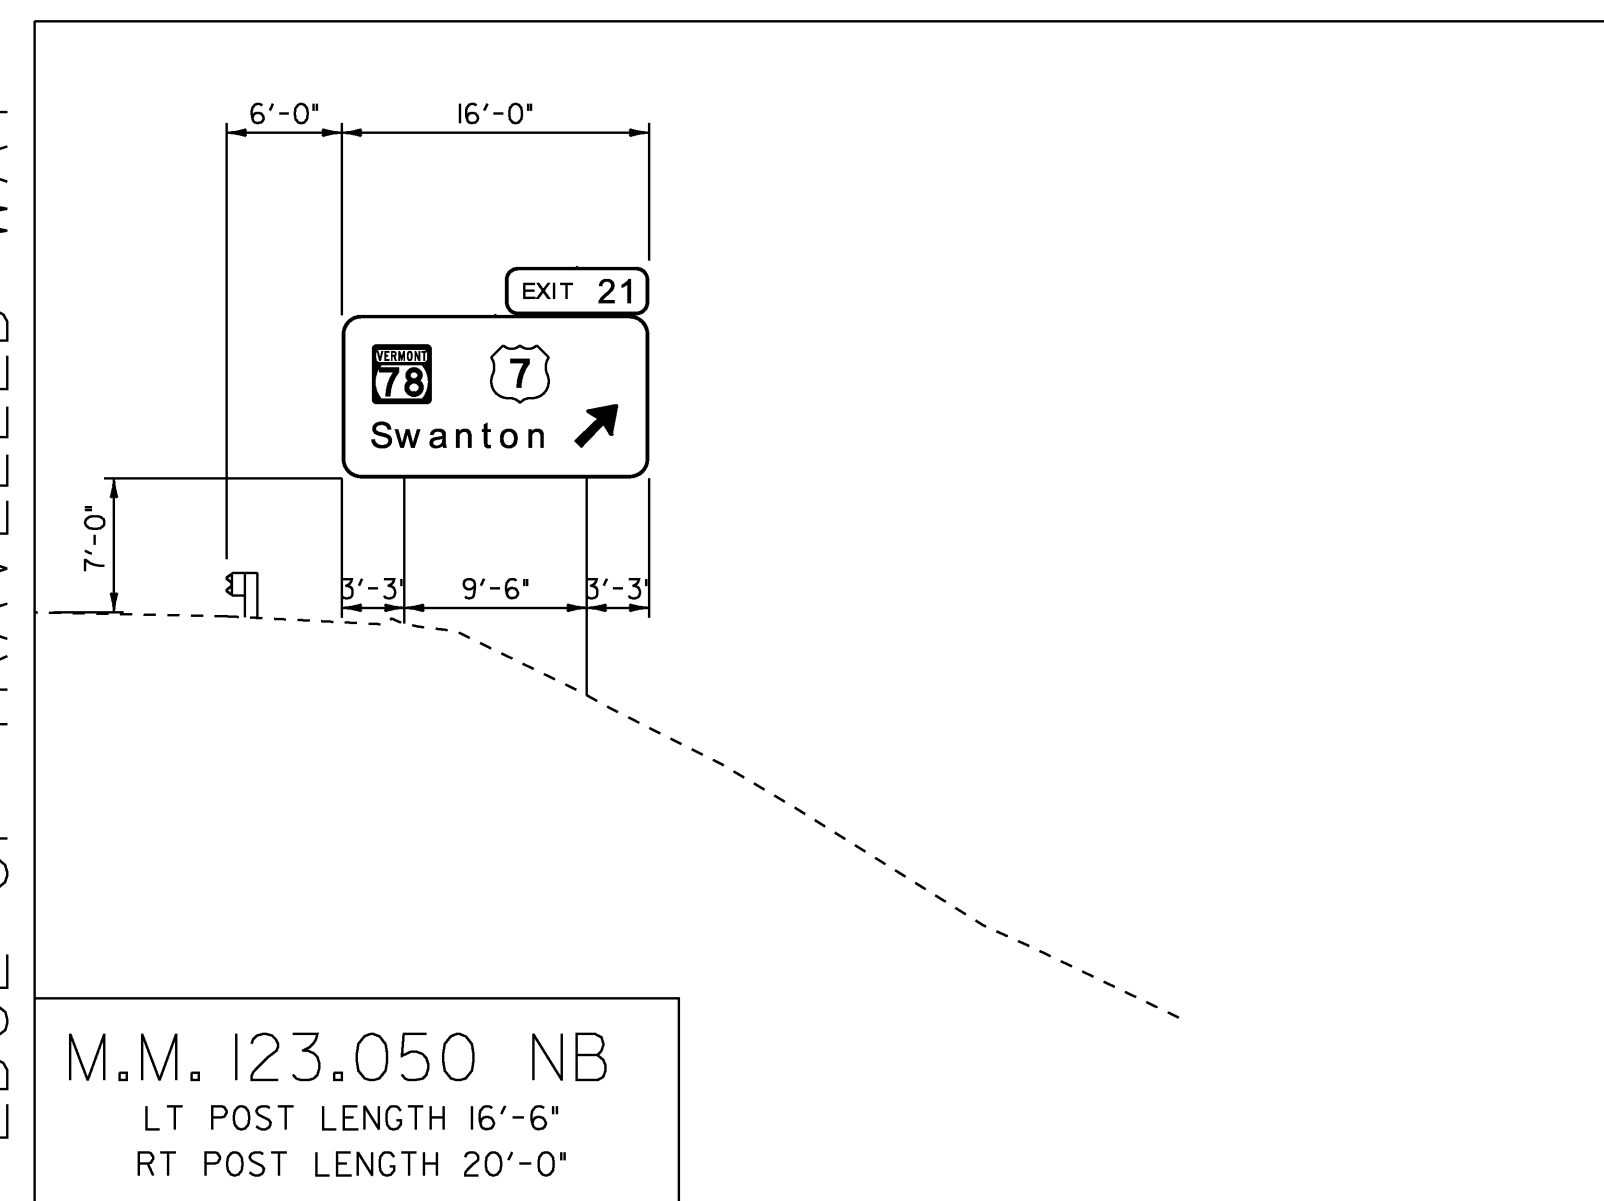

SCALE 1" = 10'-0"  
10 0 10

**NOTES:**

1. TYPICAL FOOTING BASE DEPTH IS PER STANDARD E-161, UNLESS SPECIFIED WITH THE NOTE: "SPECIAL 8' DEEP W-SHAPE FOOTING".
2. THE SPECIAL W-SHAPE FOOTING DETAIL IS LOCATED ON THE INDEX OF SHEETS & GENERAL NOTES, SHEET 2.

**NORTHBOUND  
CROSS SECTIONS  
4**

COLCHESTER-HIGHGATE  
PROJECT NUMBER: IMG SIGN (17)  
FILE NAME: 09A016.DGN  
PROJECT LEADER: EPD  
DESIGNED BY: JDG  
PLOT FILE: 09A016CS4.I  
PLOT DATE: 8/21/2009  
DRAWN BY: JDG  
CHECKED BY: EPD  
SHEET 53 OF 221